


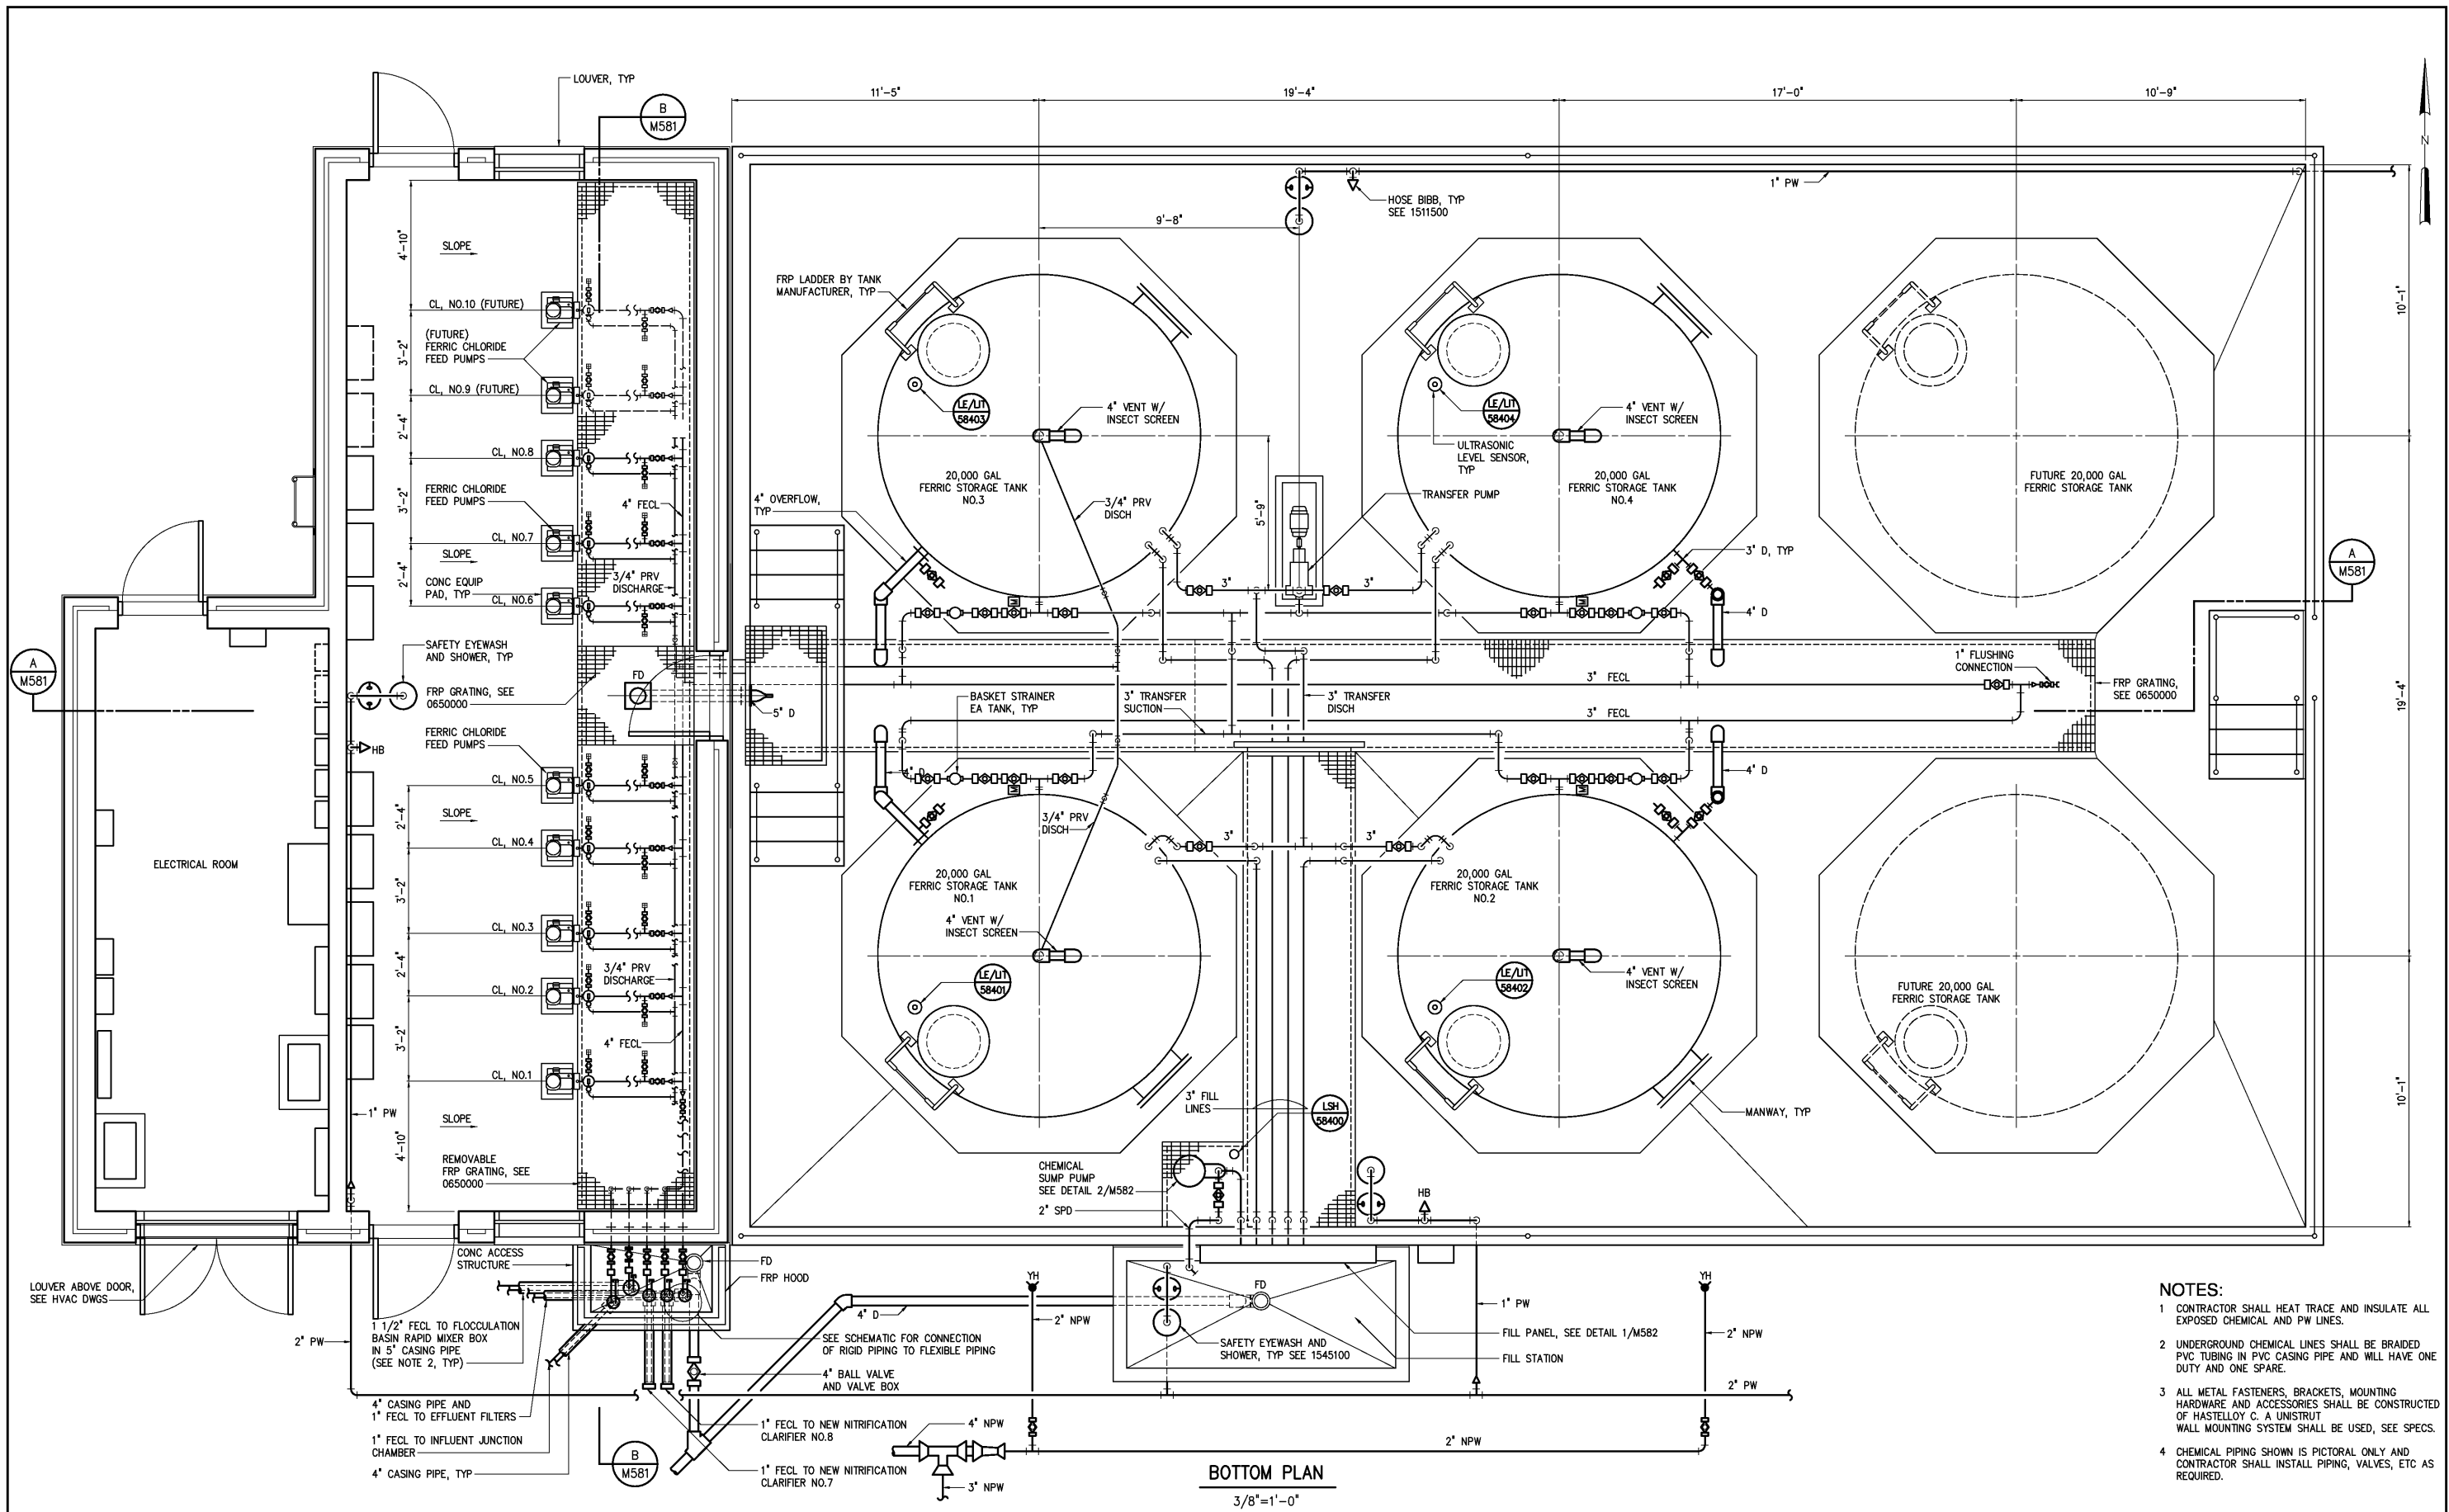

- NOTES:**
- 1 CONTRACTOR SHALL HEAT TRACE AND INSULATE ALL EXPOSED CHEMICAL AND PW LINES.
 - 2 UNDERGROUND CHEMICAL LINES SHALL BE BRAIDED PVC TUBING IN PVC CASING PIPE AND WILL HAVE ONE DUTY AND ONE SPARE.
 - 3 ALL METAL FASTENERS, BRACKETS, MOUNTING HARDWARE AND ACCESSORIES SHALL BE CONSTRUCTED OF HASTELLOY C. A UNISTRUT WALL MOUNTING SYSTEM SHALL BE USED, SEE SPECS.
 - 4 CHEMICAL PIPING SHOWN IS PICTORIAL ONLY AND CONTRACTOR SHALL INSTALL PIPING, VALVES, ETC AS REQUIRED.

BOTTOM PLAN
3/8"=1'-0"

				DESIGNED	ABL
				DRAWN	BRC
				CHECKED	
				PROJ. ENGR.	DAN

THIS DOCUMENT ORIGINALLY ISSUED FOR CONSTRUCTION AND SEALED BY ROBERT S. DIFIORE, SEAL NO. 22769

THIS DOCUMENT ORIGINALLY ISSUED FOR CONSTRUCTION AND SEALED BY RONALD L. TAYLOR, SEAL NO. 024649

RECORD DRAWING

THIS DRAWING HAS BEEN MODIFIED TO REFLECT FIELD CHANGES REPORTED BY THE CONTRACTOR OR ANOTHER PARTY, BUT NOT VERIFIED BY THE CERTIFYING ENGINEER. THIS DOCUMENT ORIGINALLY ISSUED AND SEALED BY DAVID A. NAILOR, 025465. THIS MEDIA SHALL NOT BE CONSIDERED A CERTIFIED DOCUMENT.

Hazen and Sawyer
Environmental Engineers & Scientists
4011 WestChase Blvd, Raleigh, North Carolina 27607

CITY OF ROANOKE
VIRGINIA

REGIONAL WATER POLLUTION CONTROL PLANT
WET WEATHER IMPROVEMENTS

COAGULATION CHEMICAL FEED FACILITIES

MECHANICAL

BOTTOM PLAN

THE SCALE BAR SHOWN BELOW MEASURES ONE INCH LONG ON THE ORIGINAL DRAWING.	DATE	JULY 2003
	H & S JOB NUMBER	30788A
	CONTRACT NUMBER	A
	DRAWING NUMBER	M580