


PARTIAL BOTTOM PLAN

1/4"=1'-0"

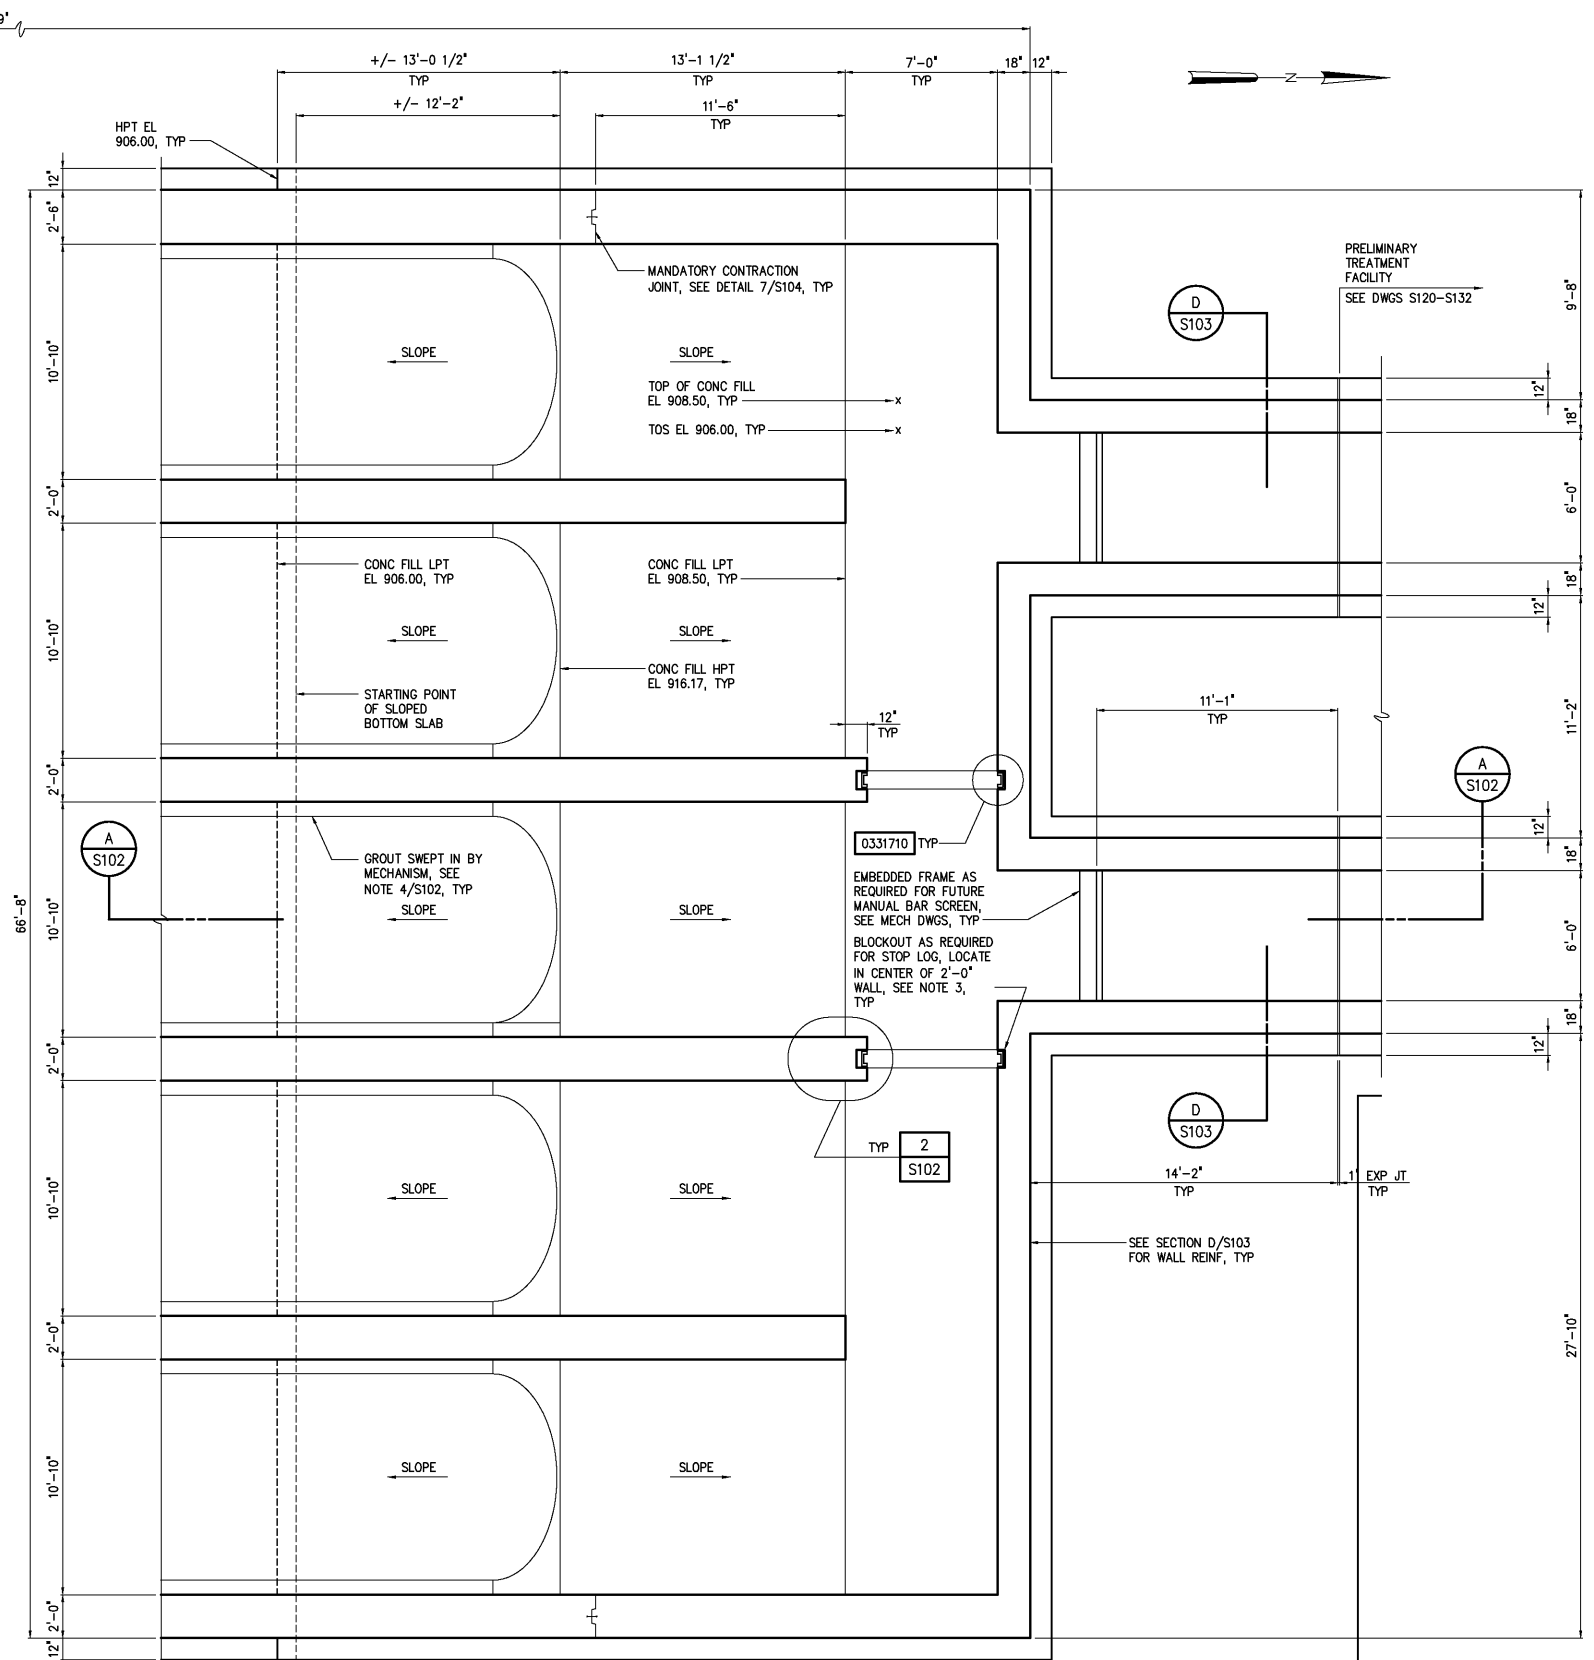

PARTIAL INTERMEDIATE PLAN

1/4"=1'-0"

- NOTES:
- 1 CONCRETE FILL IN CHANNELS AS SHOWN IN SECTION A/S102 SHALL NOT BE PLACED UNTIL GATES HAVE BEEN INSTALLED. CONTRACTOR SHALL COORDINATE CAVITY AT GATE WITH THE GATE MANUFACTURER.
 - 2 * INDICATES SIZE AND LOCATION OF SUPPORT BLOCK TO BE COORDINATED WITH SCREW MANUFACTURER.
 - 3 CONTRACTOR SHALL COORDINATE REQUIRED BLOCKOUT WITH STOP LOG MANUFACTURER.
 - 4 PROVIDE #6@8" ADDITIONAL HORIZONTAL BARS IN WALLS WHERE NOTED ON PLANS. ADDITIONAL BARS SHALL ALTERNATE WITH MAIN BARS SHOWN IN SECTIONS. ADDITIONAL BARS SHALL BE PROVIDED IN ADDITION TO TYPICAL WALL REINFORCING. ADDITIONAL BARS SHALL BE LOCATED BETWEEN ELEVATIONS 886.67 AND 905.25.

				DESIGNED	WGL
				DRAWN	WGL
				CHECKED	
		RECORD DRAWINGS	MAR 2008	RLT	
		CONSTRUCTION	MAR 2004	RLT	
		REGULATORY APPROVAL	NOV 2003	RLT	PROJ. ENGR. DAN
		PRELIMINARY DESIGN	NOV 2002	RLT	
NO.		ISSUED FOR	DATE	BY	APPROVED

THIS DOCUMENT ORIGINALLY ISSUED FOR CONSTRUCTION AND SEALED BY ROBERT S. DIFIORE, SEAL NO. 22769

RECORD DRAWING

THIS DRAWING HAS BEEN MODIFIED TO REFLECT FIELD CHANGES REPORTED BY THE CONTRACTOR OR ANOTHER PARTY, BUT NOT VERIFIED BY THE CERTIFYING ENGINEER. THIS DOCUMENT ORIGINALLY ISSUED AND SEALED BY CHRISTOPHER T. PHILLIPS, 033796. THIS MEDIA SHALL NOT BE CONSIDERED A CERTIFIED DOCUMENT.

THIS DOCUMENT ORIGINALLY ISSUED FOR CONSTRUCTION AND SEALED BY RONALD L. TAYLOR, SEAL NO. 024649

HAZEN AND SAWYER
Environmental Engineers & Scientists
4011 WestChase Blvd, Raleigh, North Carolina 27607

CITY OF ROANOKE
VIRGINIA
REGIONAL WATER POLLUTION CONTROL PLANT
WET WEATHER IMPROVEMENTS

INFLUENT PUMP STATION
STRUCTURAL
PARTIAL BOTTOM AND INTERMEDIATE PLANS

THE SCALE BAR SHOWN BELOW MEASURES ONE INCH LONG ON THE ORIGINAL DRAWING.	DATE	JULY 2003
	H & S JOB NUMBER	30788A
	CONTRACT NUMBER	A
	DRAWING NUMBER	S100