




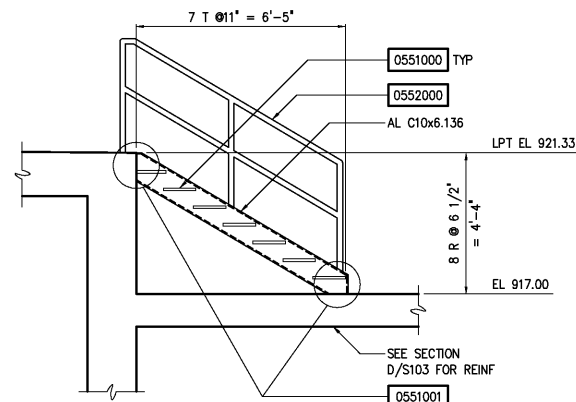


SECTION F
3/8"=1'-0"

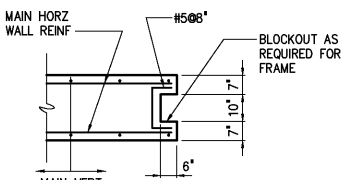

NOTE: POCKET SHALL BE 6" DEEP ON SOUTH SIDE OF STOP LOG
DETAIL 2
3/8"=1'-0"

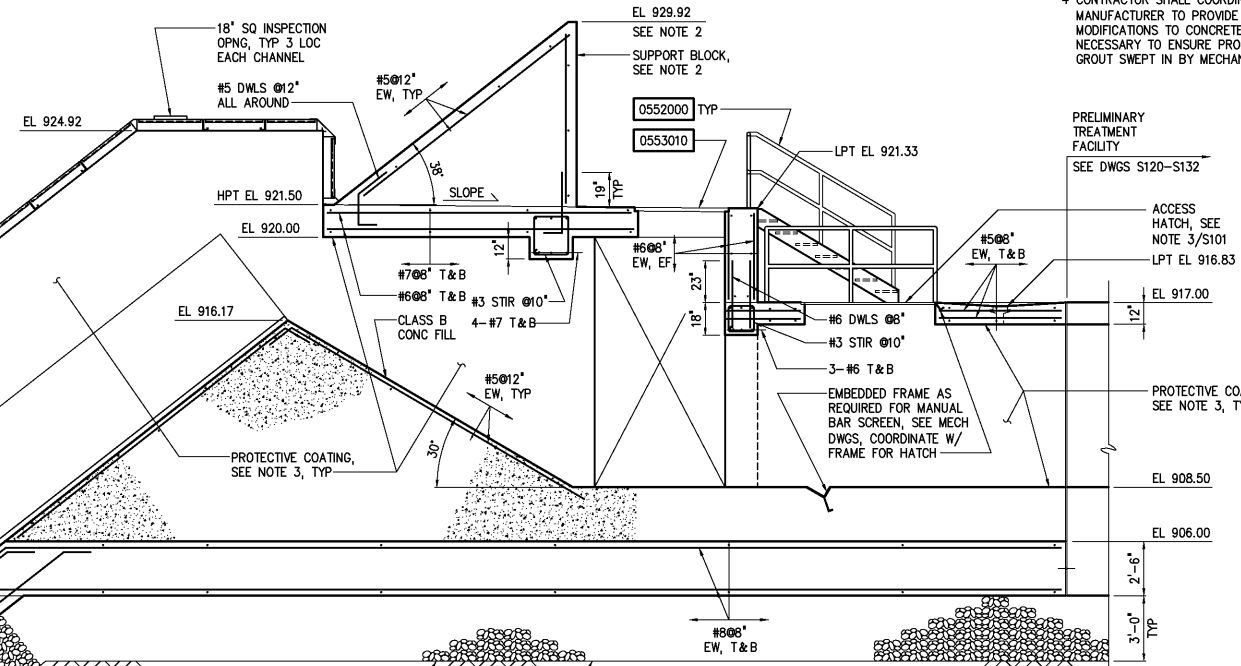


SECTION A
1/4"=1'-0"

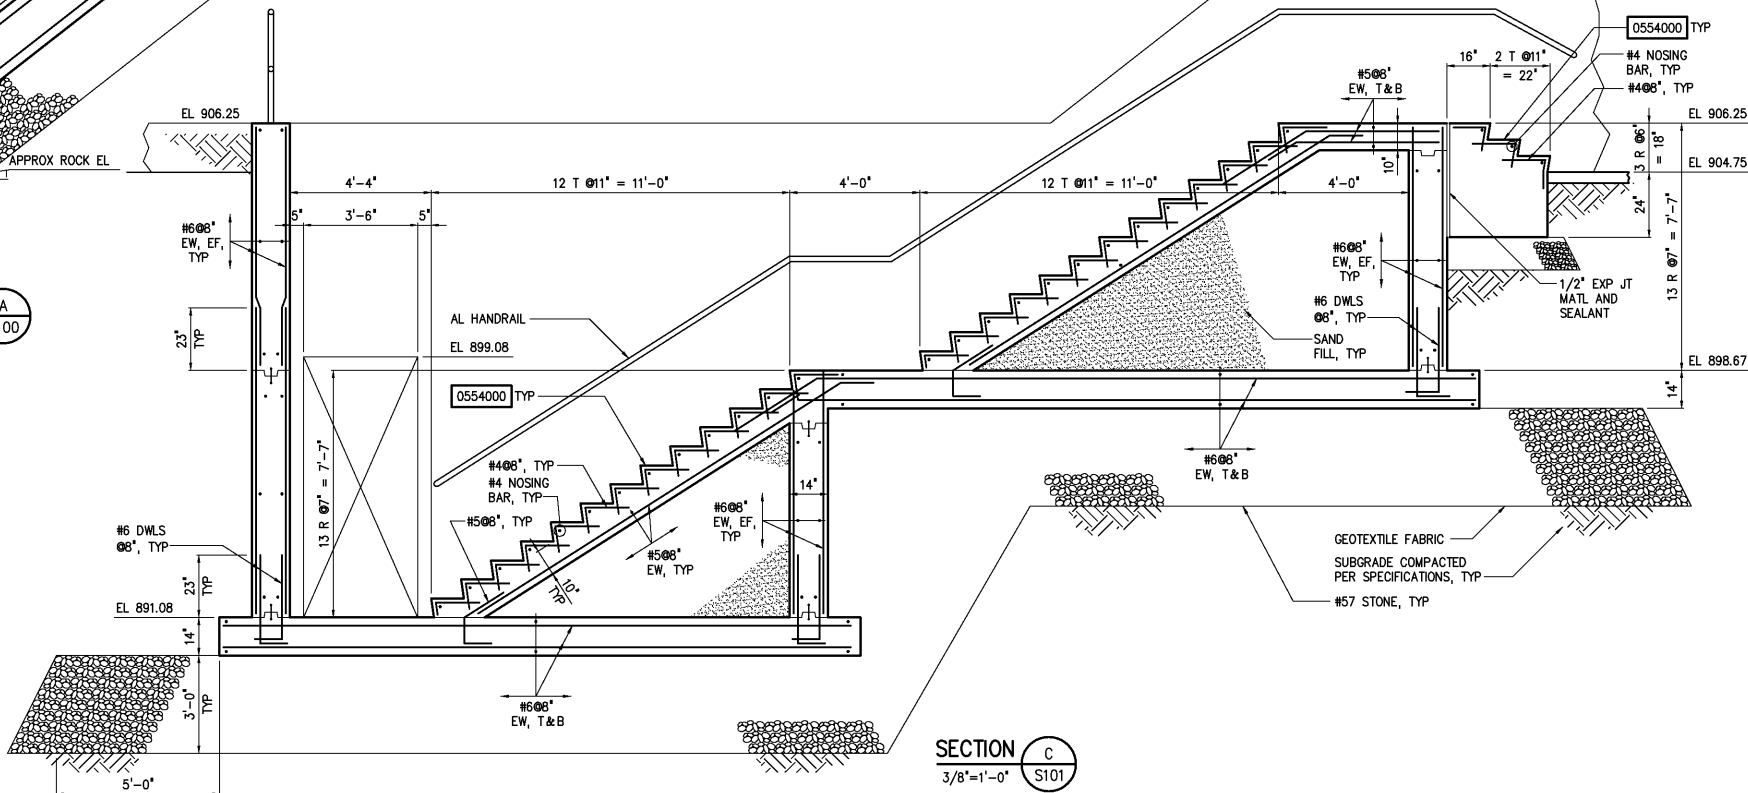

SECTION C
3/8"=1'-0"

- NOTES:
- 1 SUBGRADE SHALL BE INSPECTED BY GEOTECHNICAL ENGINEER PRIOR TO PLACING OF GEOTEXTILE FABRIC AND STONE BASE.
 - 2 CONTRACTOR SHALL COORDINATE SIZE AND LOCATION OF SUPPORT BLOCK WITH SCREW PUMP MANUFACTURER.
 - 3 PROVIDE PROTECTIVE COATING ON ALL EXPOSED INTERIOR WALLS, UNDERSIDE OF SLABS AND CONCRETE FILL. SEE SPECIFICATION SECTION 09900.
 - 4 CONTRACTOR SHALL COORDINATE WITH SCREW PUMP MANUFACTURER TO PROVIDE CONCRETE FILL AND/OR MODIFICATIONS TO CONCRETE DIVIDER WALLS AS NECESSARY TO ENSURE PROPER INSTALLATION OF GROUT SWEEP IN BY MECHANISM.

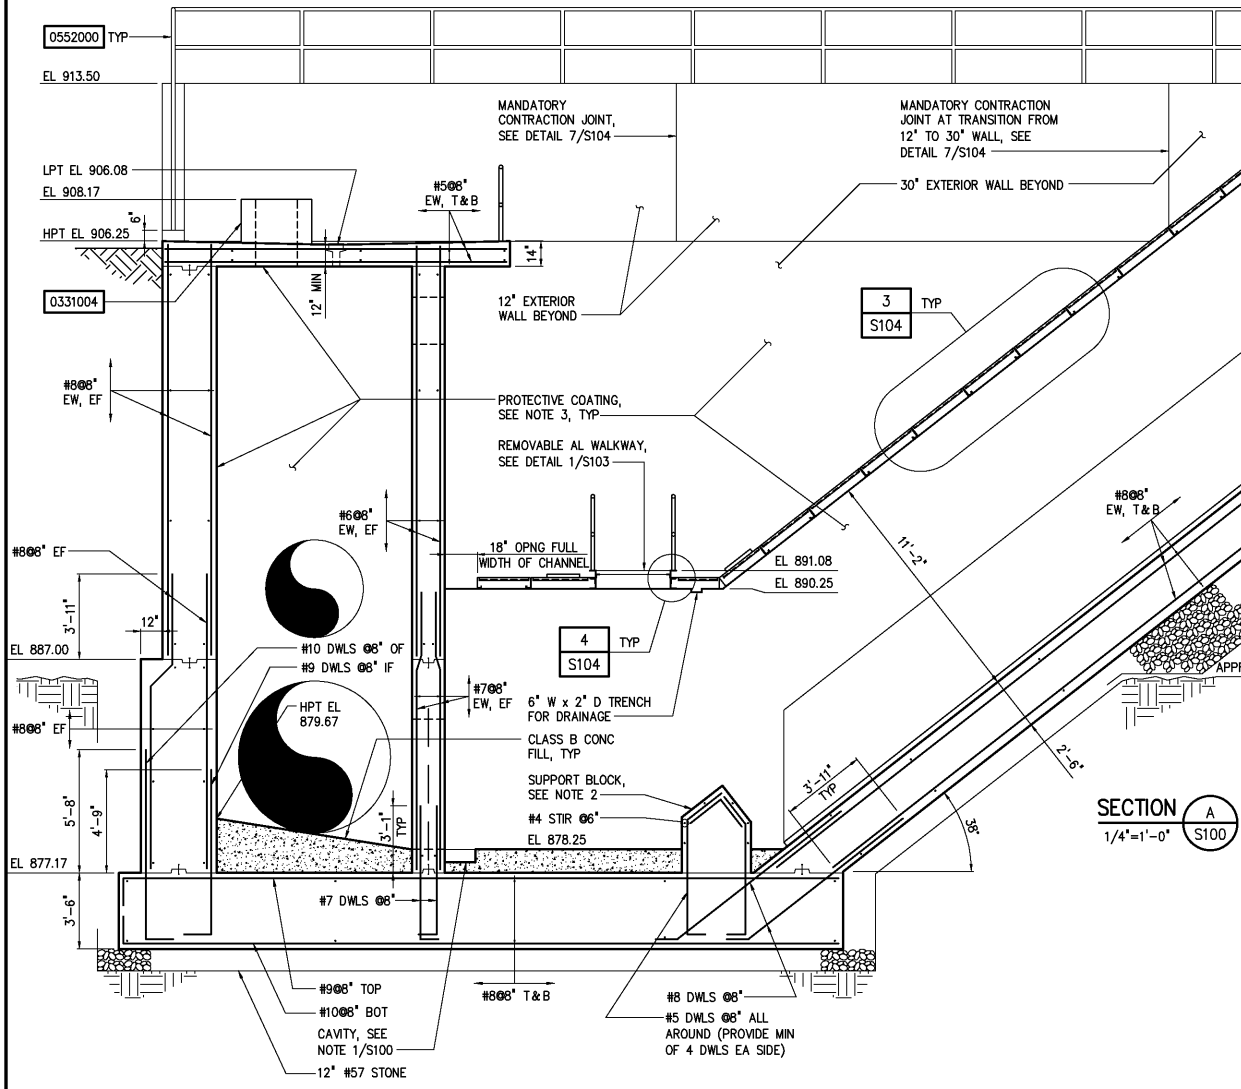

DESIGNED	WGL
DRAWN	WGL
CHECKED	
PROJ. ENGR.	DAN
APPROVED	

THIS DOCUMENT ORIGINALLY ISSUED FOR CONSTRUCTION AND SEALED BY ROBERT S. DIFIORE, SEAL NO. 22769

THIS DOCUMENT ORIGINALLY ISSUED FOR CONSTRUCTION AND SEALED BY RONALD L. TAYLOR, SEAL NO. 024649

RECORD DRAWING

THIS DRAWING HAS BEEN MODIFIED TO REFLECT FIELD CHANGES REPORTED BY THE CONTRACTOR OR ANOTHER PARTY, BUT NOT VERIFIED BY THE CERTIFYING ENGINEER. THIS DOCUMENT ORIGINALLY ISSUED AND SEALED BY CHRISTOPHER T. PHILLIPS, 033796. THIS MEDIA SHALL NOT BE CONSIDERED A CERTIFIED DOCUMENT.

HAZEN AND SAWYER
Environmental Engineers & Scientists
4011 WestChase Blvd, Raleigh, North Carolina 27607

CITY OF ROANOKE
VIRGINIA
REGIONAL WATER POLLUTION CONTROL PLANT
WET WEATHER IMPROVEMENTS

INFLUENT PUMP STATION
STRUCTURAL
SECTIONS AND DETAILS

THE SCALE BAR SHOWN BELOW MEASURES ONE INCH LONG ON THE ORIGINAL DRAWING.	DATE JULY 2003
H & S JOB NUMBER 30788A	CONTRACT NUMBER A
DRAWING NUMBER S102	