
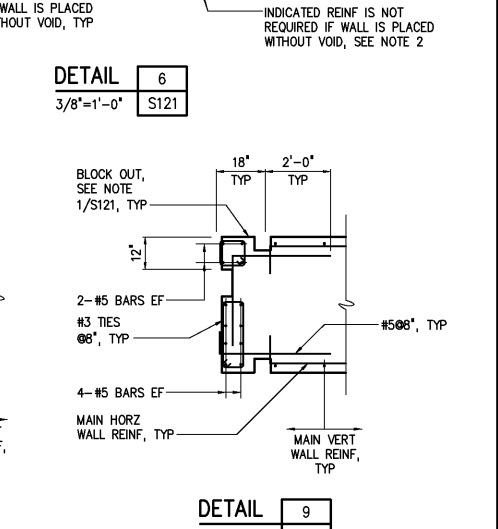
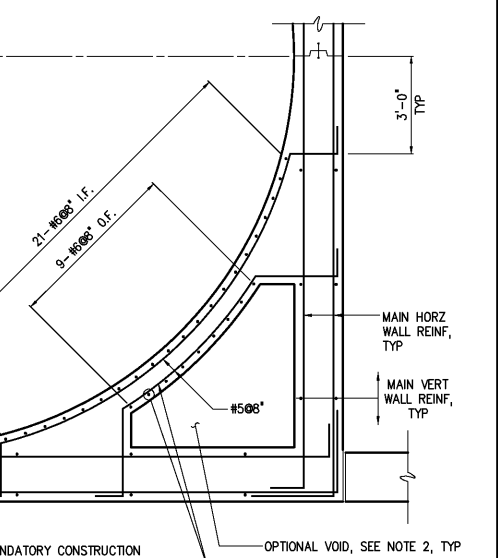
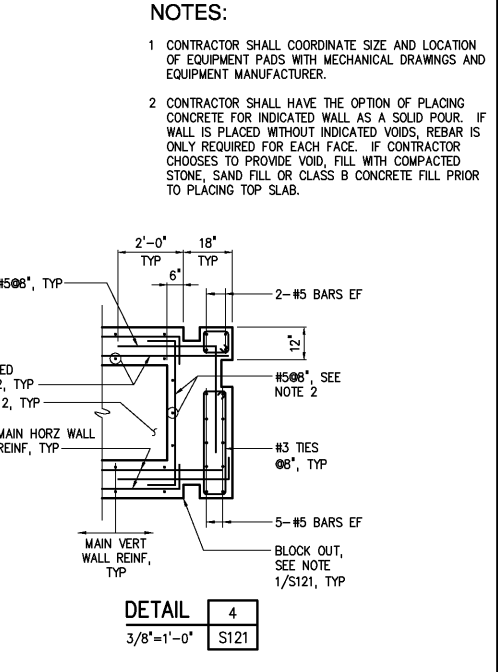
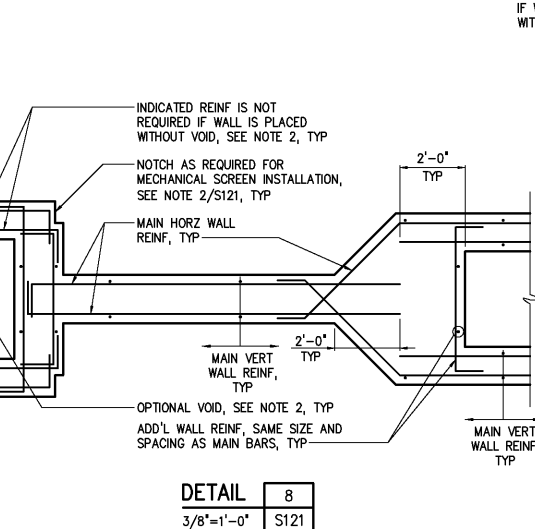
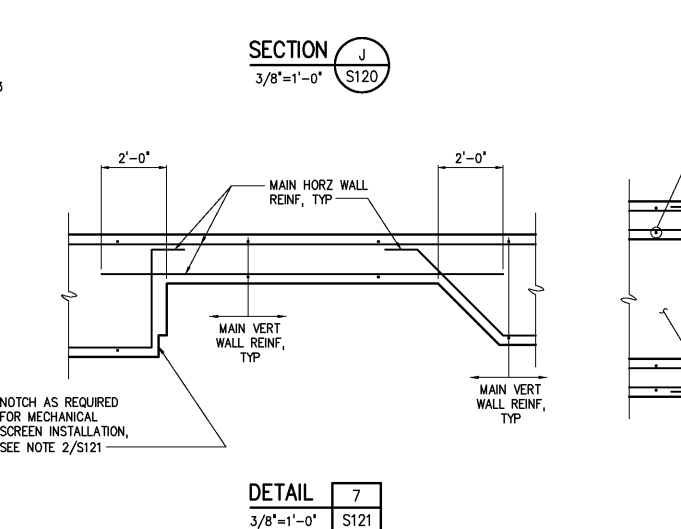
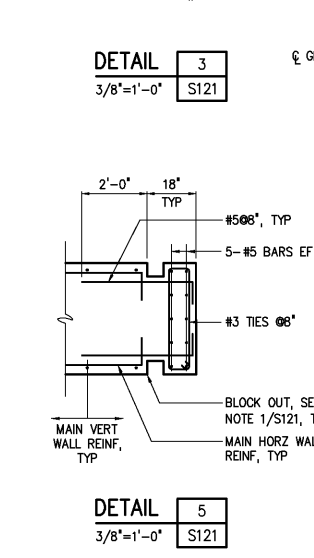
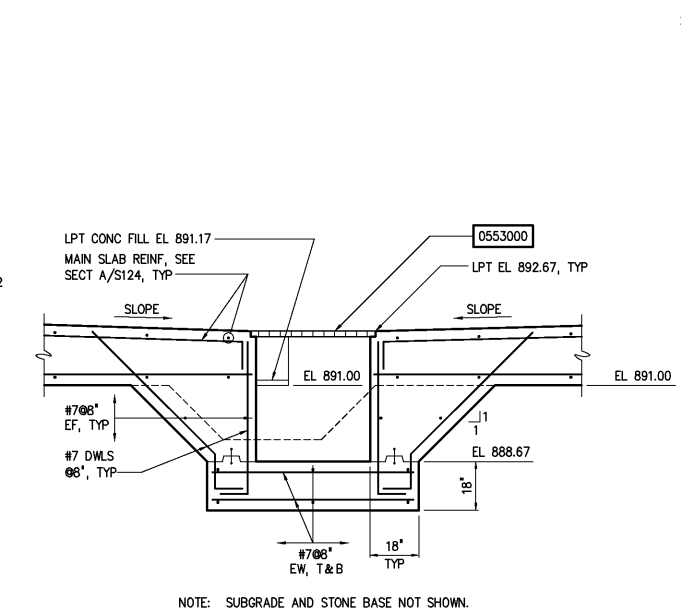
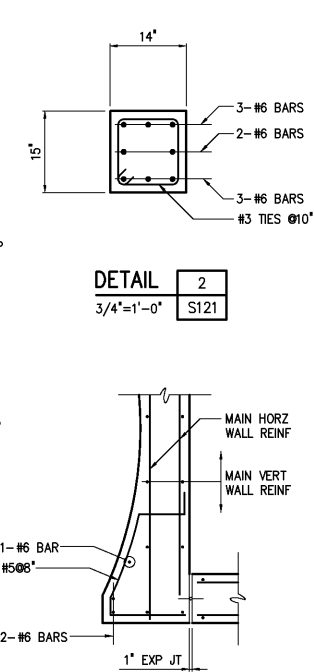
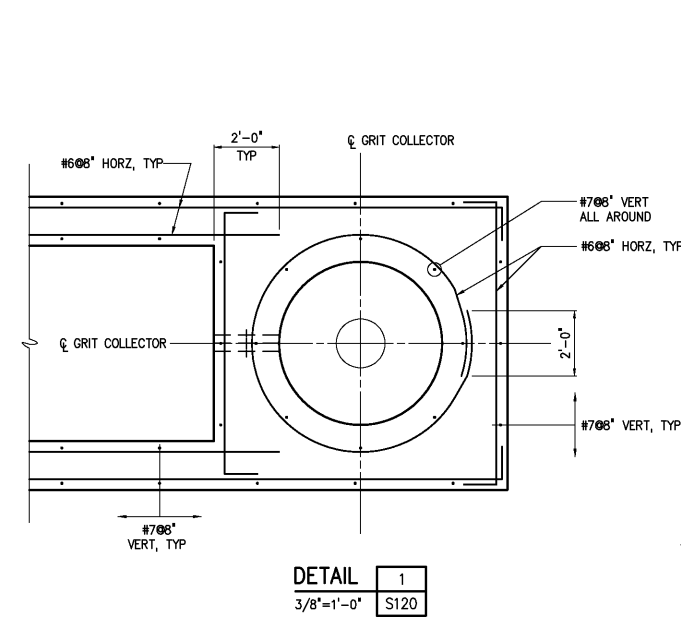


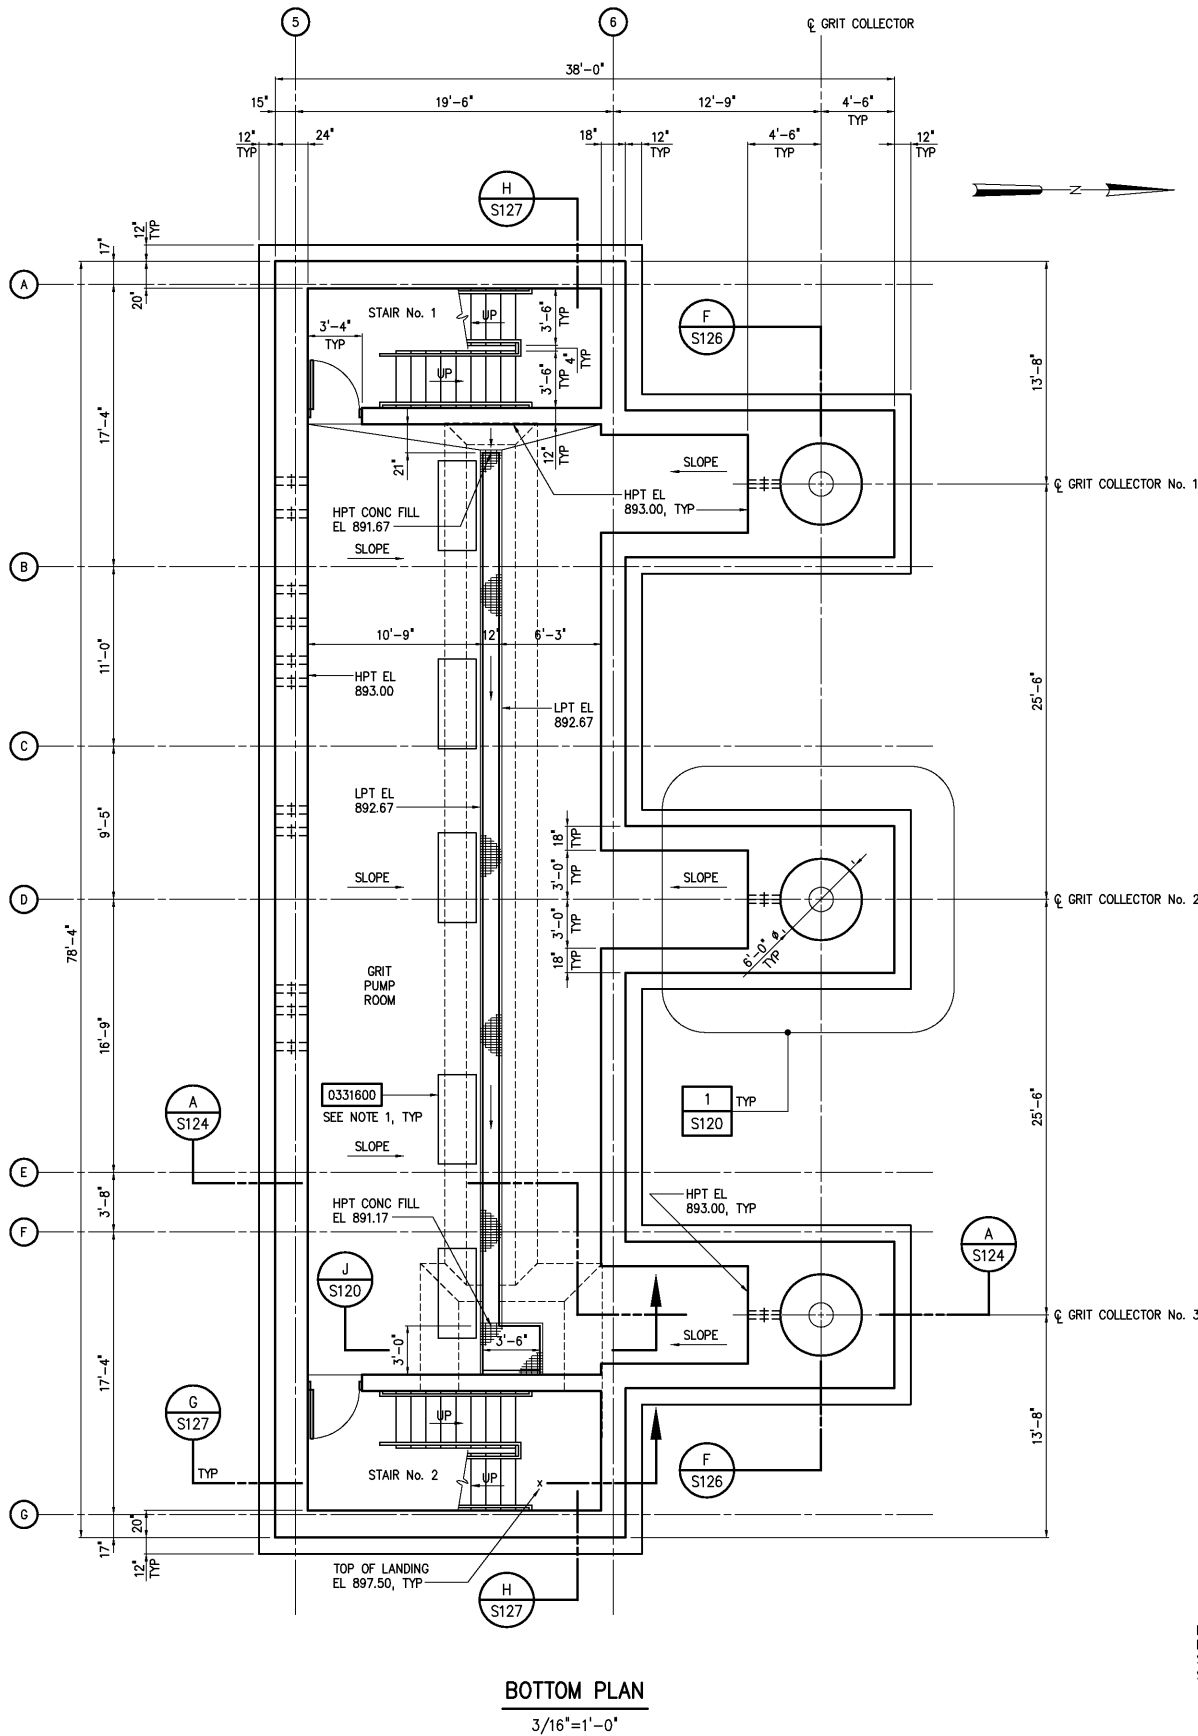

- NOTES:**
- CONTRACTOR SHALL COORDINATE SIZE AND LOCATION OF EQUIPMENT PADS WITH MECHANICAL DRAWINGS AND EQUIPMENT MANUFACTURER.
 - CONTRACTOR SHALL HAVE THE OPTION OF PLACING CONCRETE FOR INDICATED WALL AS A SOLID POUR. IF WALL IS PLACED WITHOUT INDICATED VOIDS, REBAR IS ONLY REQUIRED FOR EACH FACE. IF CONTRACTOR CHOOSES TO PROVIDE VOID, FILL WITH COMPACTED STONE, SAND FILL OR CLASS B CONCRETE FILL PRIOR TO PLACING TOP SLAB.

DESIGNED	WGL
DRAWN	WGL
CHECKED	
PROJ. ENGR.	DAN
APPROVED	
NO.	
ISSUED FOR	
DATE	
BY	

THIS DOCUMENT ORIGINALLY ISSUED FOR CONSTRUCTION AND SEALED BY ROBERT S. DIFIORE, SEAL NO. 22769

THIS DOCUMENT ORIGINALLY ISSUED FOR CONSTRUCTION AND SEALED BY RONALD L. TAYLOR, SEAL NO. 024649

RECORD DRAWING

THIS DRAWING HAS BEEN MODIFIED TO REFLECT FIELD CHANGES REPORTED BY THE CONTRACTOR OR ANOTHER PARTY, BUT NOT VERIFIED BY THE CERTIFYING ENGINEER. THIS DOCUMENT ORIGINALLY ISSUED AND SEALED BY CHRISTOPHER T. PHILLIPS, 033796. THIS MEDIA SHALL NOT BE CONSIDERED A CERTIFIED DOCUMENT.

HAZEN AND SAWYER
Environmental Engineers & Scientists
4011 WestChase Blvd, Raleigh, North Carolina 27607

CITY OF ROANOKE VIRGINIA

REGIONAL WATER POLLUTION CONTROL PLANT WET WEATHER IMPROVEMENTS

PRELIMINARY TREATMENT FACILITIES

STRUCTURAL

BOTTOM PLAN, SECTIONS AND DETAILS

THE SCALE BAR SHOWN BELOW MEASURES ONE INCH LONG ON THE ORIGINAL DRAWING.	DATE JULY 2003	H & S JOB NUMBER 30788A
	CONTRACT NUMBER A	DRAWING NUMBER S120