


NOTES:

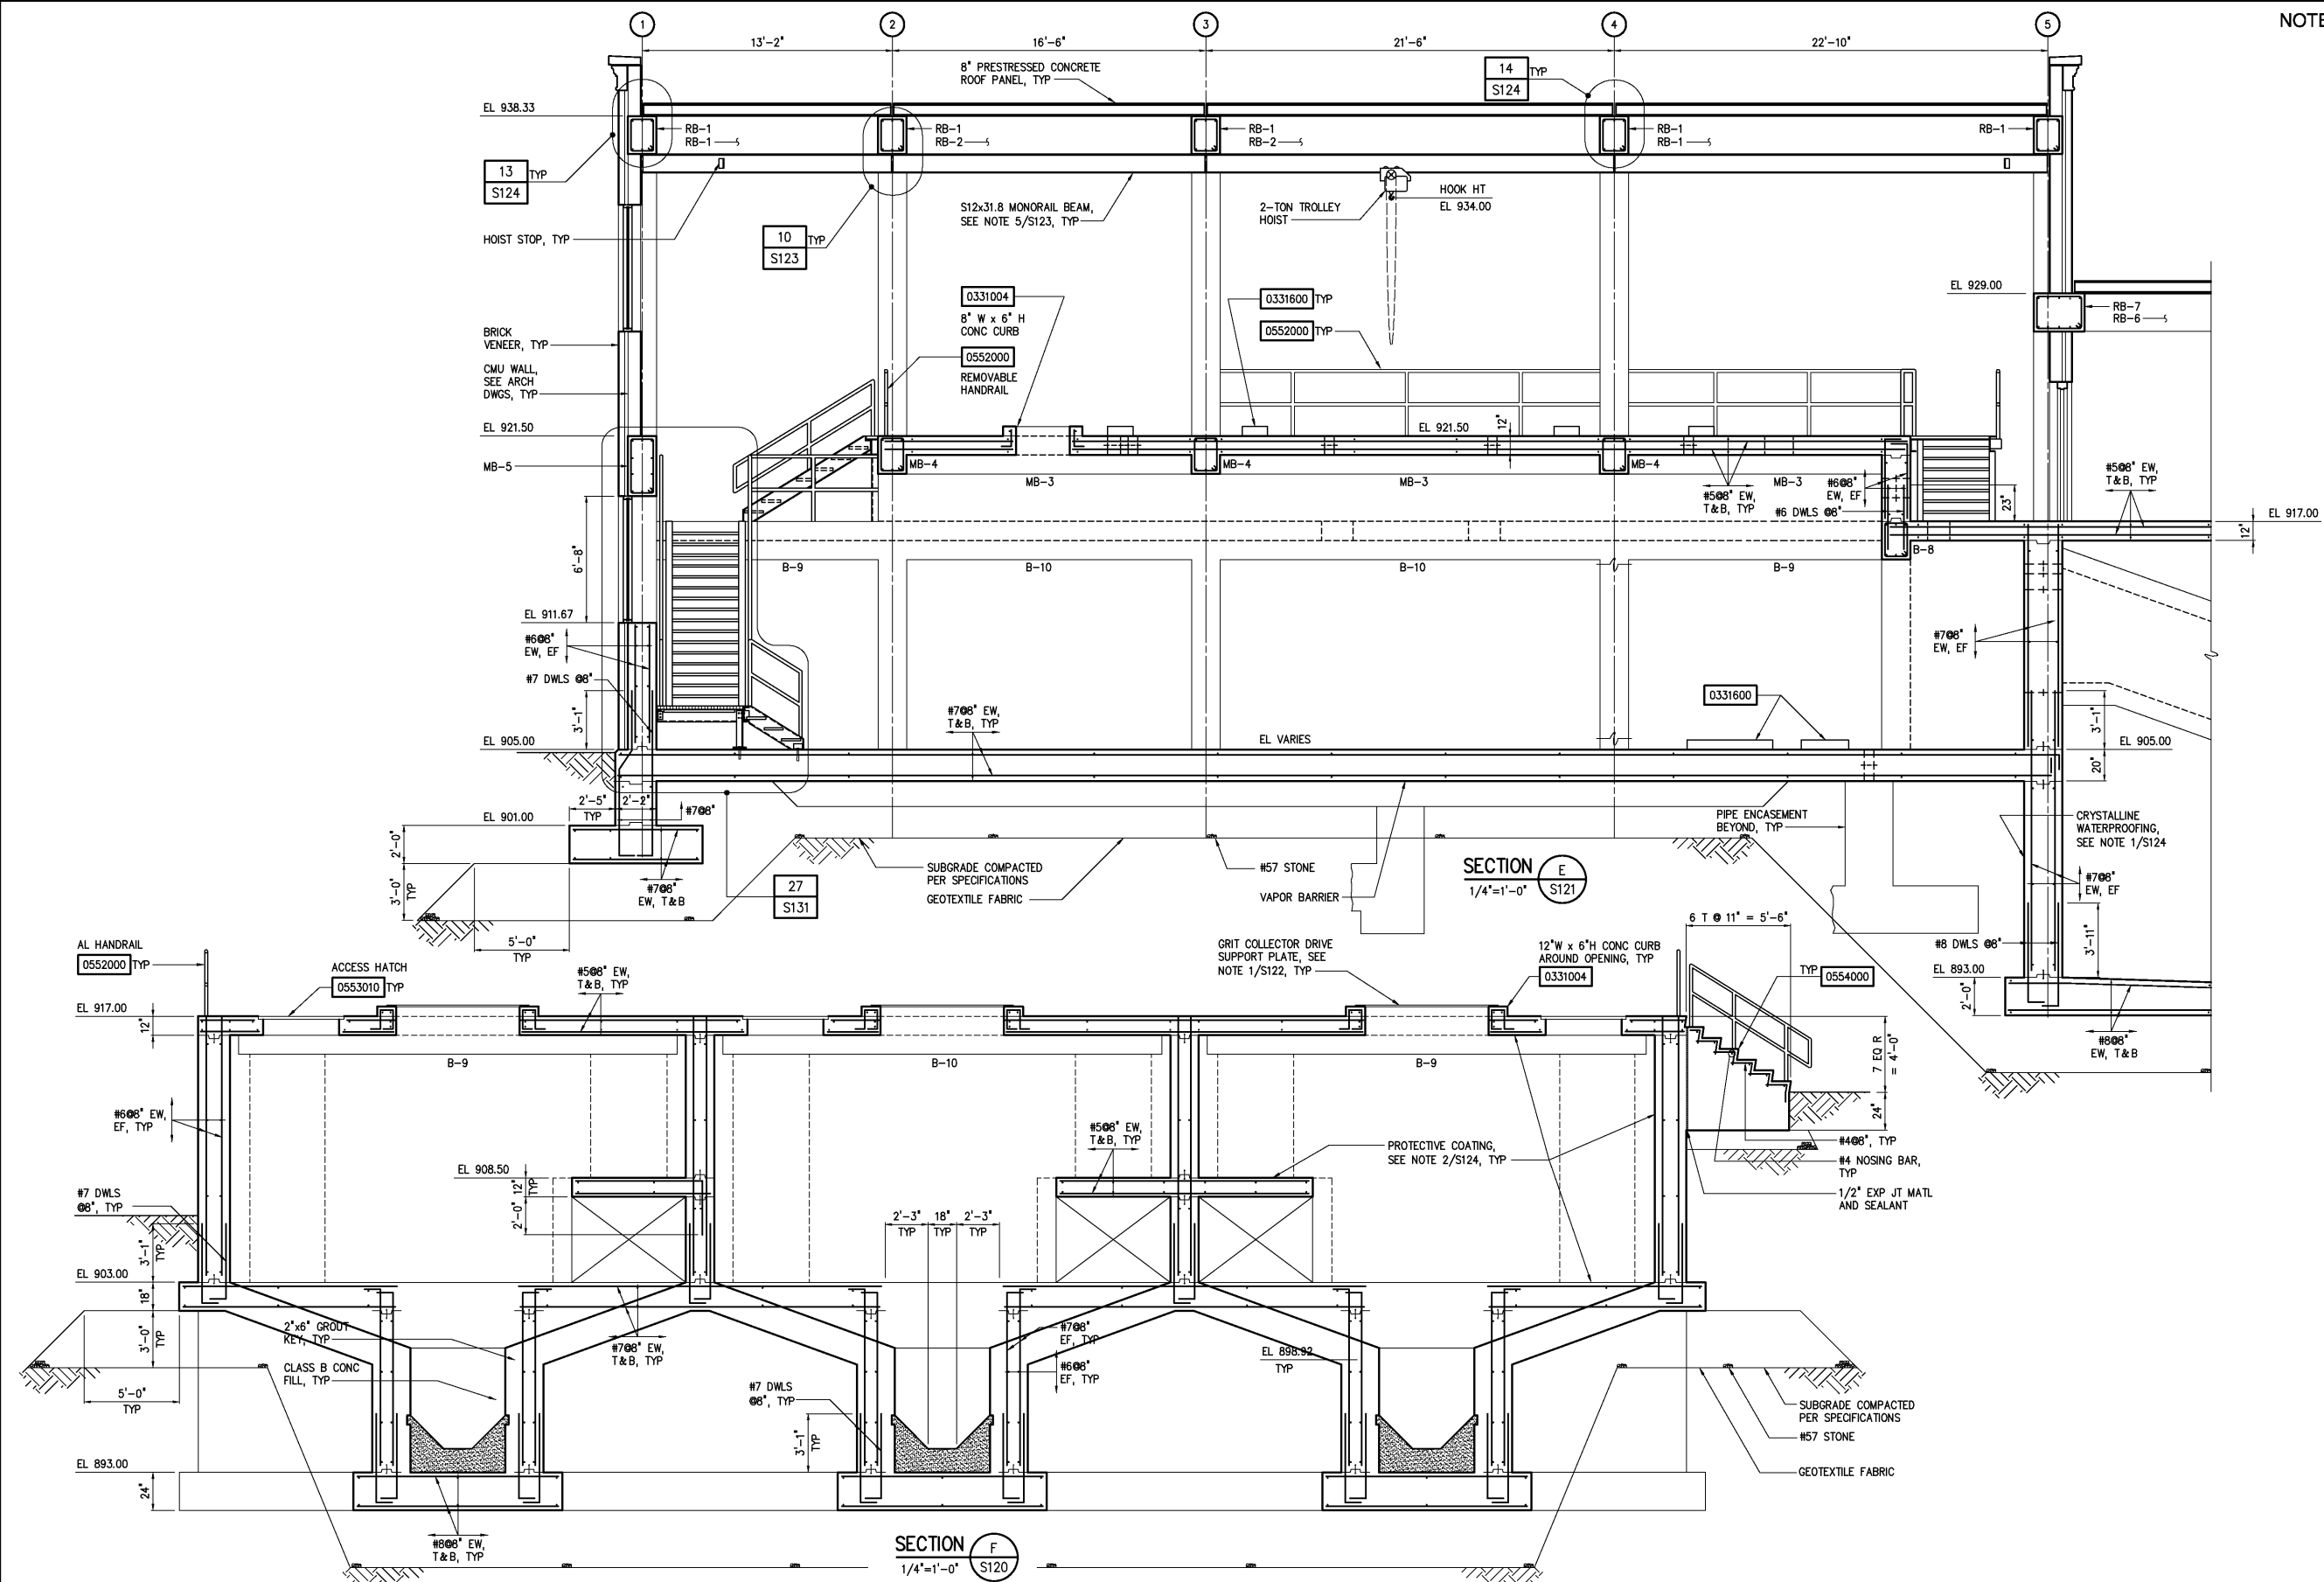

DESIGNED	WGL
DRAWN	WGL
CHECKED	
PROJ. ENGR.	DAN
ISSUED FOR	DATE
BY	APPROVED
NO.	

RECORD DRAWINGS	MAR 2008	RLT
CONSTRUCTION	MAR 2004	RLT
REGULATORY APPROVAL	NOV 2003	RLT
PRELIMINARY DESIGN	NOV 2002	RLT
ISSUED FOR	DATE	BY
NO.		APPROVED

DESIGNED	WGL
DRAWN	WGL
CHECKED	
PROJ. ENGR.	DAN
ISSUED FOR	DATE
BY	APPROVED
NO.	

RECORD DRAWING
THIS DRAWING HAS BEEN MODIFIED TO REFLECT FIELD CHANGES REPORTED BY THE CONTRACTOR OR ANOTHER PARTY, BUT NOT VERIFIED BY THE CERTIFYING ENGINEER. THIS DOCUMENT ORIGINALLY ISSUED AND SEALED BY CHRISTOPHER T. PHILLIPS, 033796. THIS MEDIA SHALL NOT BE CONSIDERED A CERTIFIED DOCUMENT.

Hazen and Sawyer
Environmental Engineers & Scientists
4011 WestChase Blvd, Raleigh, North Carolina 27607

CITY OF ROANOKE
VIRGINIA
REGIONAL WATER POLLUTION CONTROL PLANT
WET WEATHER IMPROVEMENTS

PRELIMINARY TREATMENT FACILITIES
STRUCTURAL
SECTIONS

THE SCALE BAR SHOWN BELOW MEASURES ONE INCH LONG ON THE ORIGINAL DRAWING. 	DATE JULY 2003	
	H & S JOB NUMBER 30788A	
	CONTRACT NUMBER A	DRAWING NUMBER S126