



NOTES:


- 1 C8 INDICATES AL C8x4.147.
2 C10 INDICATES AL C10x6.136.
3 C12 INDICATES AL C12x11.822.

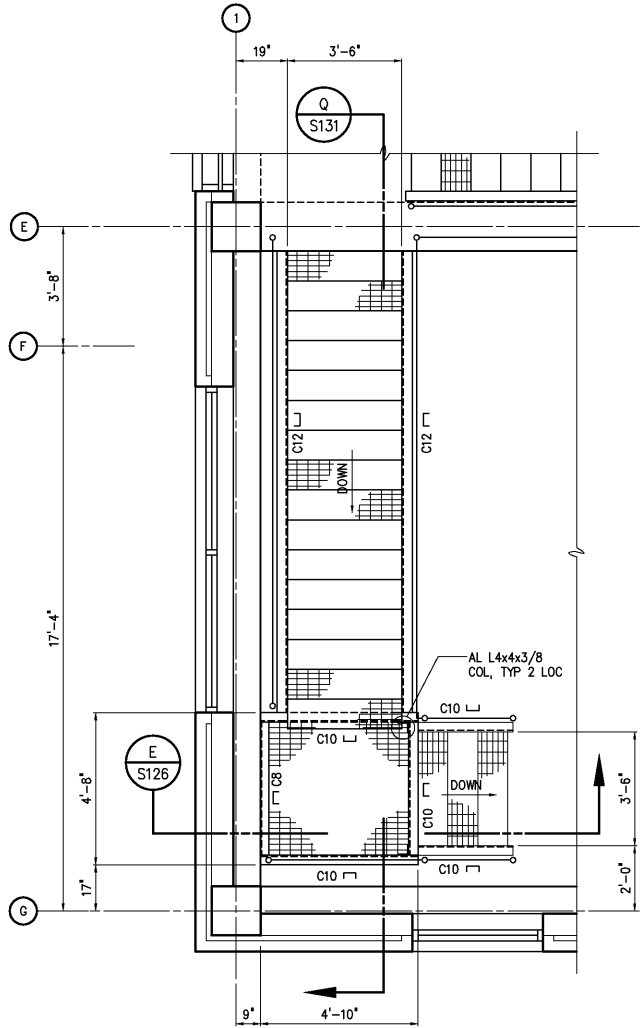


DETAIL 26
3/8"=1'-0" S121

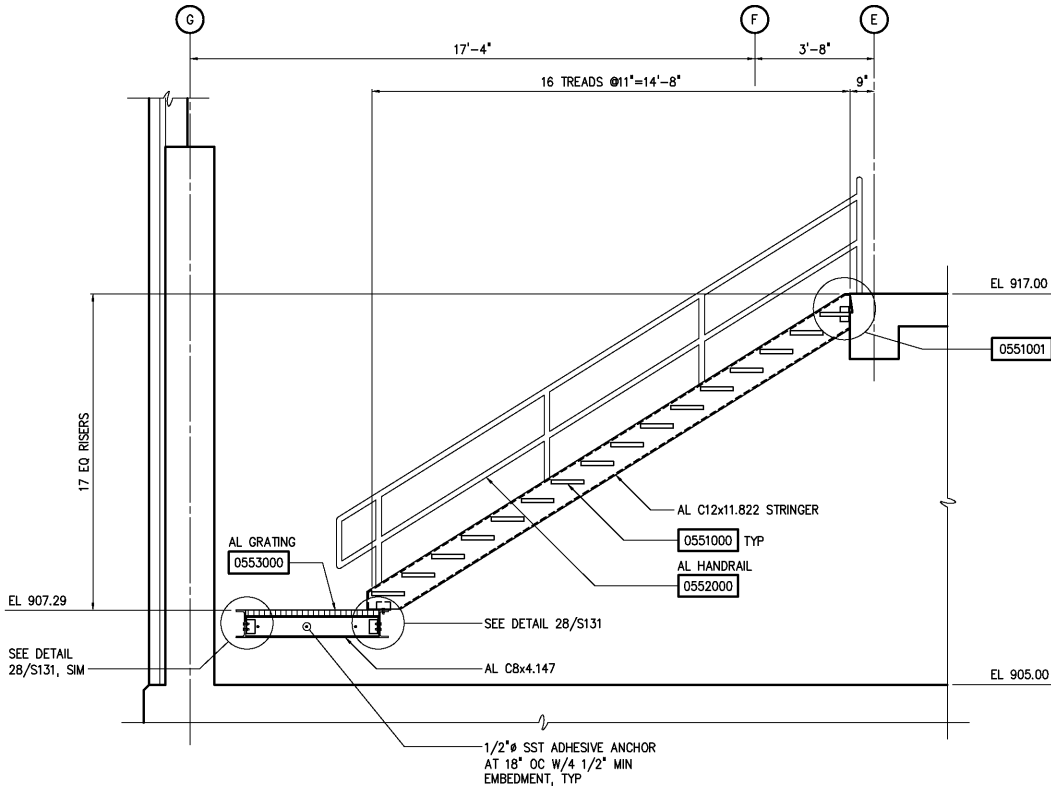

SECTION Q
3/8"=1'-0" S131

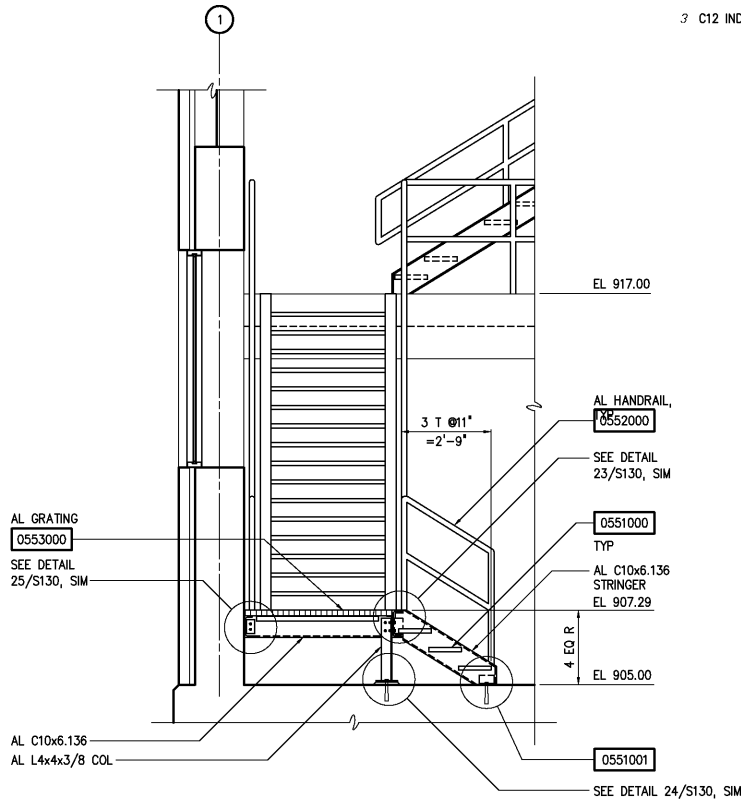

DETAIL 27
3/8"=1'-0" S126

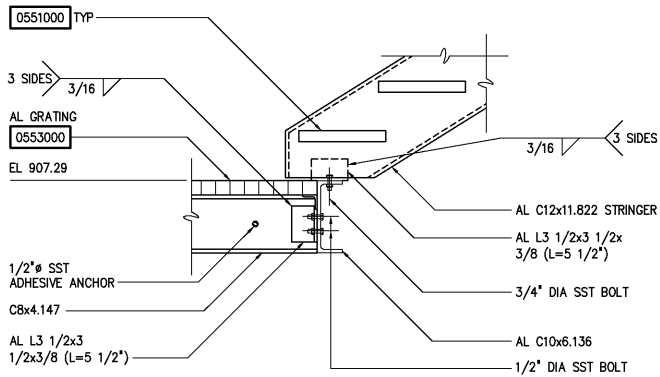

DETAIL 28
1"=1'-0" S131

DESIGNED	WGL/ARH
DRAWN	ARH
CHECKED	
PROJ. ENGR.	DAN
APPROVED	
NO.	
ISSUED FOR	DATE BY
RECORD DRAWINGS	MAR 2008 RLT
CONSTRUCTION	MAR 2004 RLT
REGULATORY APPROVAL	NOV 2003 RLT
PRELIMINARY DESIGN	NOV 2002 RLT

THIS DOCUMENT ORIGINALLY ISSUED FOR CONSTRUCTION AND SEALED BY ROBERT S. DIFIORE, SEAL NO. 22769

RECORD DRAWING

THIS DRAWING HAS BEEN MODIFIED TO REFLECT FIELD CHANGES REPORTED BY THE CONTRACTOR OR ANOTHER PARTY, BUT NOT VERIFIED BY THE CERTIFYING ENGINEER. THIS DOCUMENT ORIGINALLY ISSUED AND SEALED BY CHRISTOPHER T. PHILLIPS, 033796. THIS MEDIA SHALL NOT BE CONSIDERED A CERTIFIED DOCUMENT.

THIS DOCUMENT ORIGINALLY ISSUED FOR CONSTRUCTION AND SEALED BY RONALD L. TAYLOR, SEAL NO. 024649

HAZEN AND SAWYER
Environmental Engineers & Scientists
4011 WestChase Blvd, Raleigh, North Carolina 27607

CITY OF ROANOKE
VIRGINIA

REGIONAL WATER POLLUTION CONTROL PLANT
WET WEATHER IMPROVEMENTS

PRELIMINARY TREATMENT FACILITIES
STRUCTURAL
SECTIONS AND DETAILS

THE SCALE BAR SHOWN BELOW MEASURES ONE INCH LONG ON THE ORIGINAL DRAWING.

DATE JULY 2003
H & S JOB NUMBER 30788A
CONTRACT NUMBER A
DRAWING NUMBER S131