



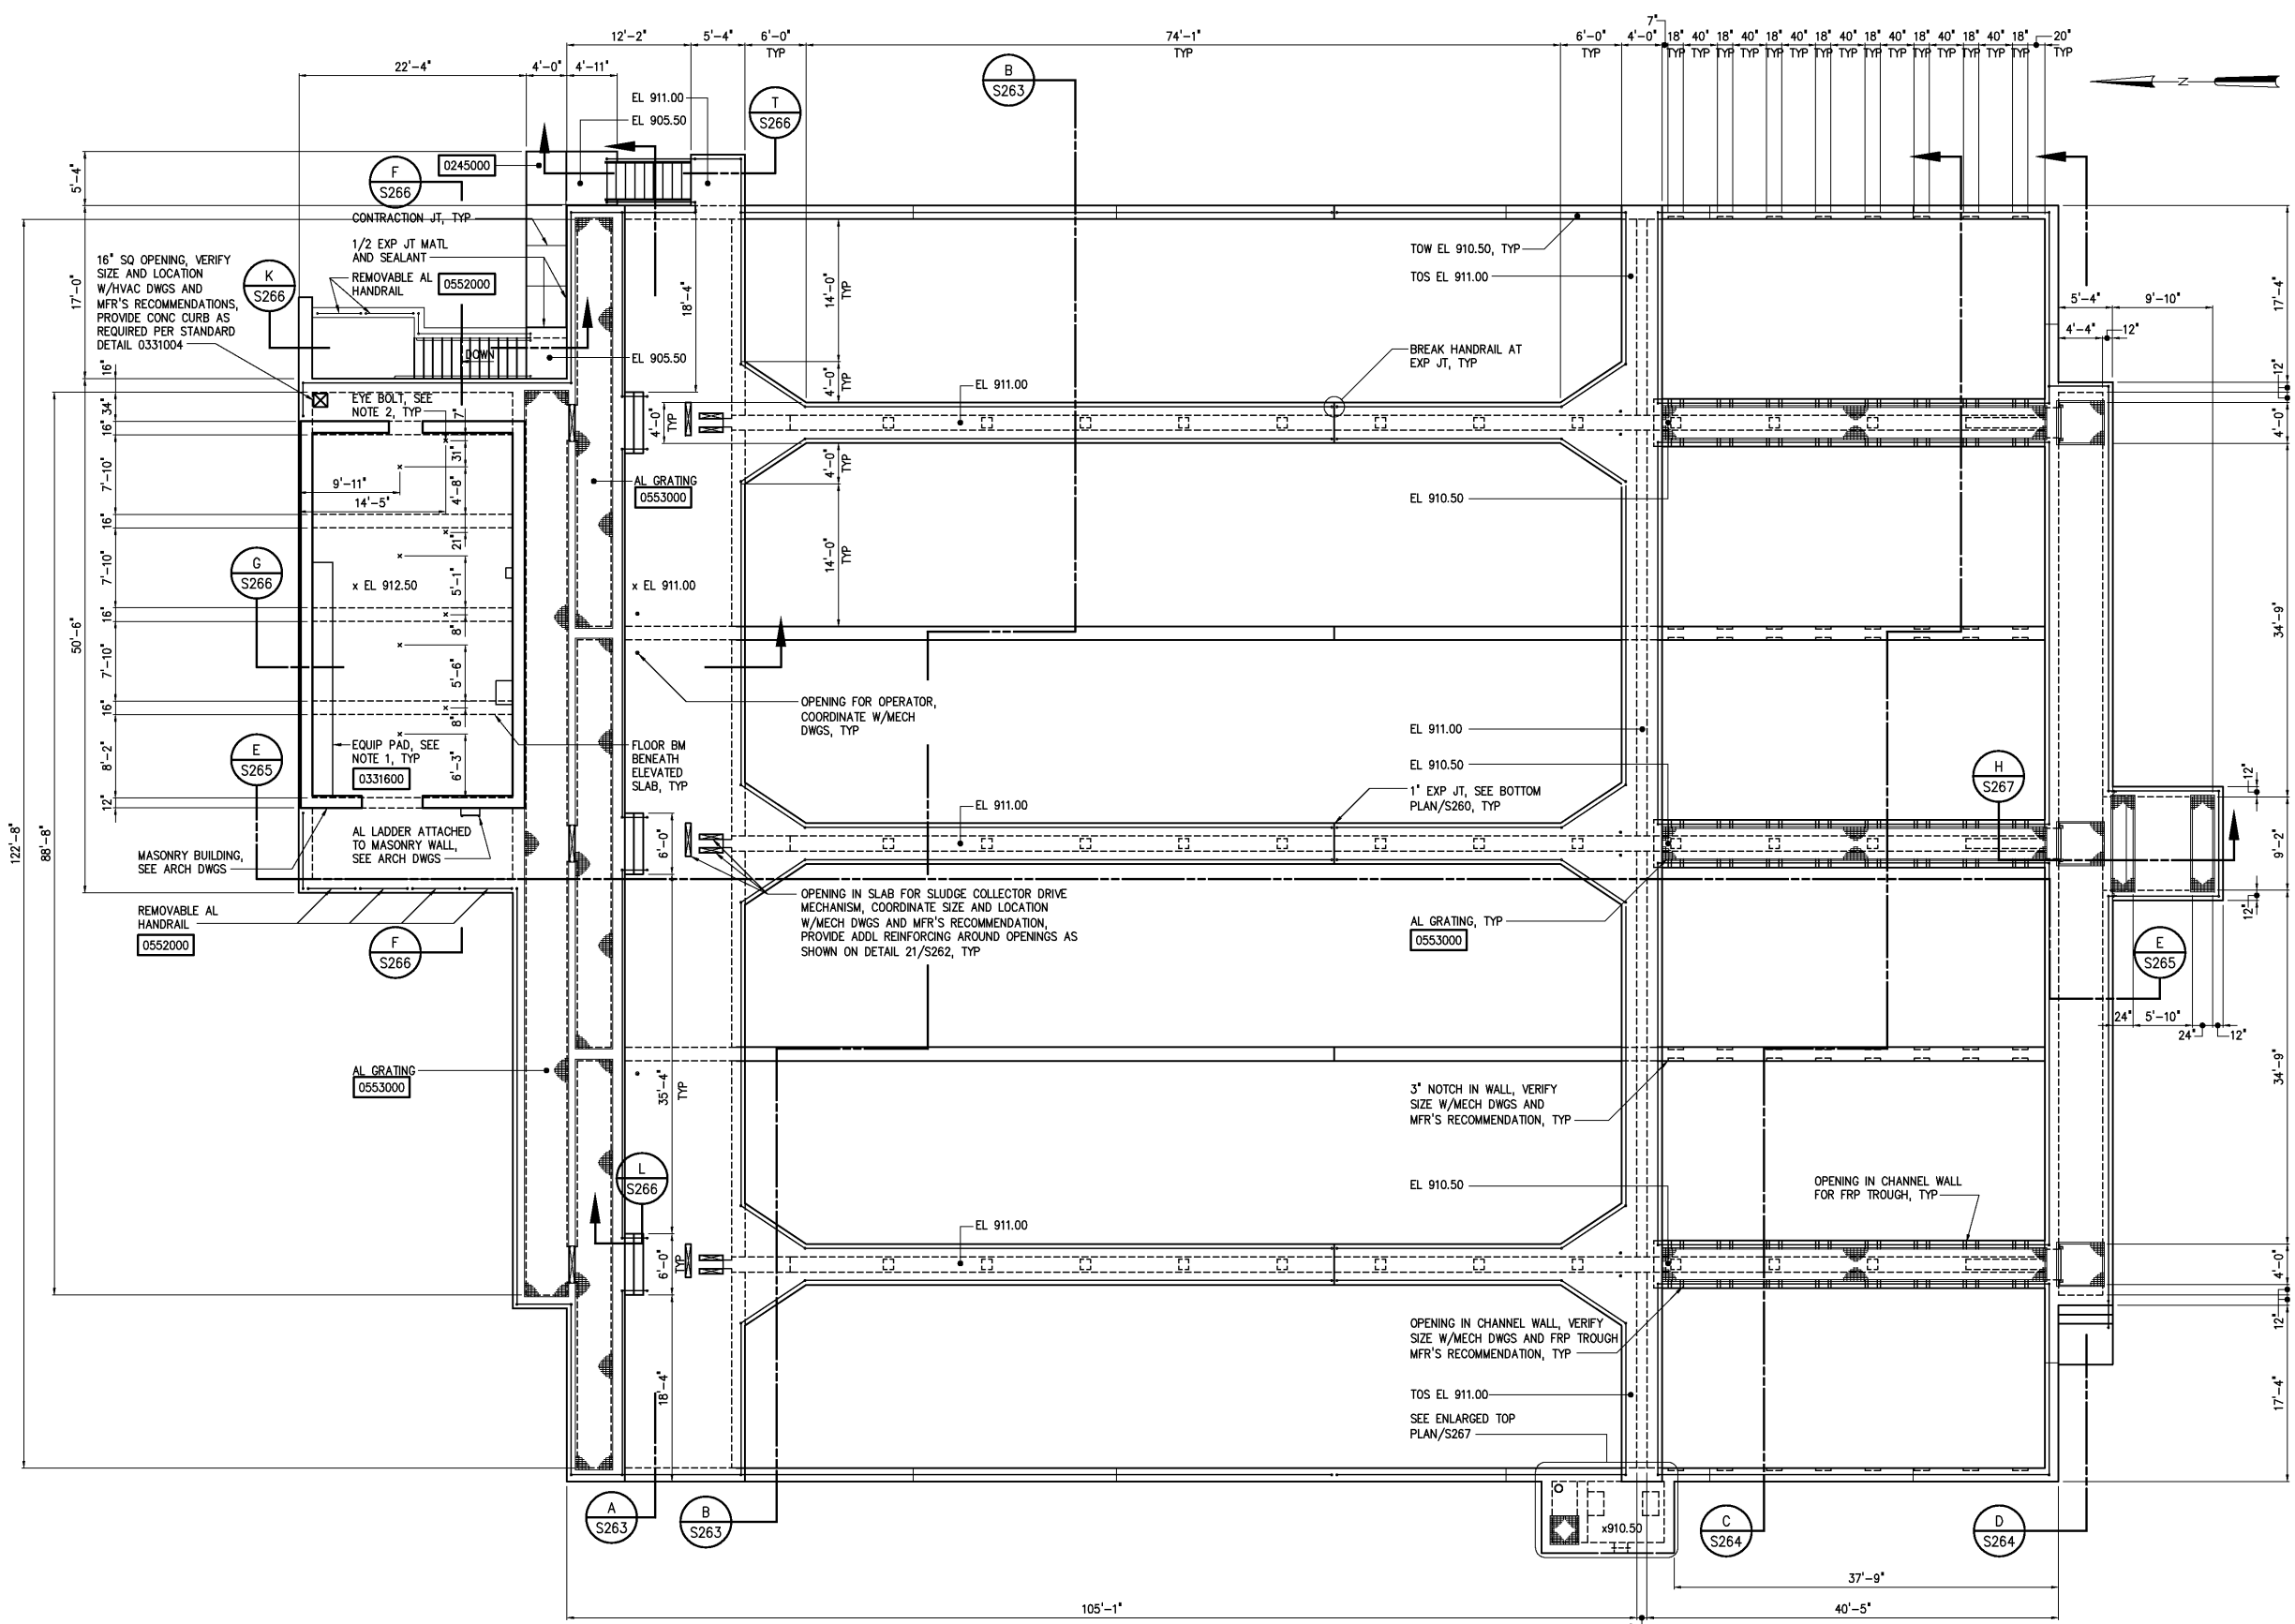

- NOTES:
- 1 CONTRACTOR SHALL COORDINATE SIZE AND LOCATION OF EQUIPMENT PADS WITH EQUIPMENT MANUFACTURERS RECOMMENDATIONS AND ELECTRICAL DRAWINGS.
 - 2 X INDICATES LOCATION WHERE EYE BOLT SHALL ATTACH TO UNDERSIDE OF SLAB. SEE STANDARD DETAIL 0550100 AND SECTION D/M264. ALLOWABLE LOAD FOR EYE BOLT SHALL BE 2.0 KIPS. A MAXIMUM OF 2 EYE BOLTS SHALL BE IN USE SIMULTANEOUSLY.

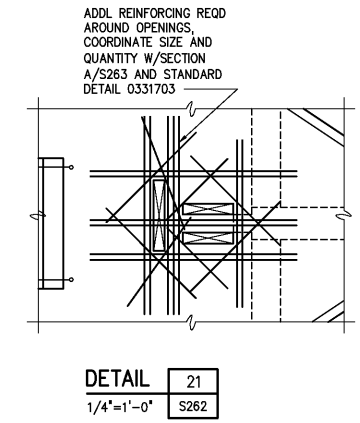

TOP PLAN
1/8"=1'-0"

DESIGNED AGM DRAWN AGM CHECKED PROJ. ENGR. DAN APPROVED				RECORD DRAWING THIS DRAWING HAS BEEN MODIFIED TO REFLECT FIELD CHANGES REPORTED BY THE CONTRACTOR OR ANOTHER PARTY, BUT NOT VERIFIED BY THE CERTIFYING ENGINEER. THIS DOCUMENT ORIGINALLY ISSUED AND SEALED BY CHRISTOPHER T. PHILLIPS, 033796. THIS MEDIA SHALL NOT BE CONSIDERED A CERTIFIED DOCUMENT.		HAZEN AND SAWYER Environmental Engineers & Scientists 4011 WestChase Blvd, Raleigh, North Carolina 27607		CITY OF ROANOKE VIRGINIA REGIONAL WATER POLLUTION CONTROL PLANT WET WEATHER IMPROVEMENTS		PRIMARY CLARIFIER NOS 7 - 9 STRUCTURAL TOP PLAN		THE SCALE BAR SHOWN BELOW MEASURES ONE INCH LONG ON THE ORIGINAL DRAWING. DATE JULY 2003 H & S JOB NUMBER 30788A CONTRACT NUMBER A DRAWING NUMBER S262	
NO.	ISSUED FOR	DATE	BY	APPROVED	THIS DOCUMENT ORIGINALLY ISSUED FOR CONSTRUCTION AND SEALED BY ROYALD L. TAYLOR, SEAL NO. 024649								
	RECORD DRAWINGS	MAR 2008	RLT										
	CONSTRUCTION	MAR 2004	RLT										
	REGULATORY APPROVAL	NOV 2003	RLT										
	PRELIMINARY DESIGN	NOV 2002	RLT										