


- NOTES:
- 1 CONTRACTOR SHALL COORDINATE THE REQUIRED RADIUS OF CLASS B CONCRETE WITH THE EQUIPMENT MANUFACTURERS RECOMMENDATION.
  - 2 CONTRACTOR SHALL COORDINATE PLACEMENT OF BACKFILL AGAINST CLARIFIER WALLS WITH GEOTECHNICAL ENGINEERS RECOMMENDATION TO ALLOW DRAINAGE OF GROUNDWATER TO PRESSURE RELIEF VALVES. SEE SHEET S260 FOR PRESSURE RELIEF VALVE LAYOUT AND REQUIREMENTS.
  - 3 SUBGRADE SHALL BE INSPECTED BY GEOTECHNICAL ENGINEER PRIOR TO PLACING OF GEOTEXTILE FABRIC AND STONE BASE.

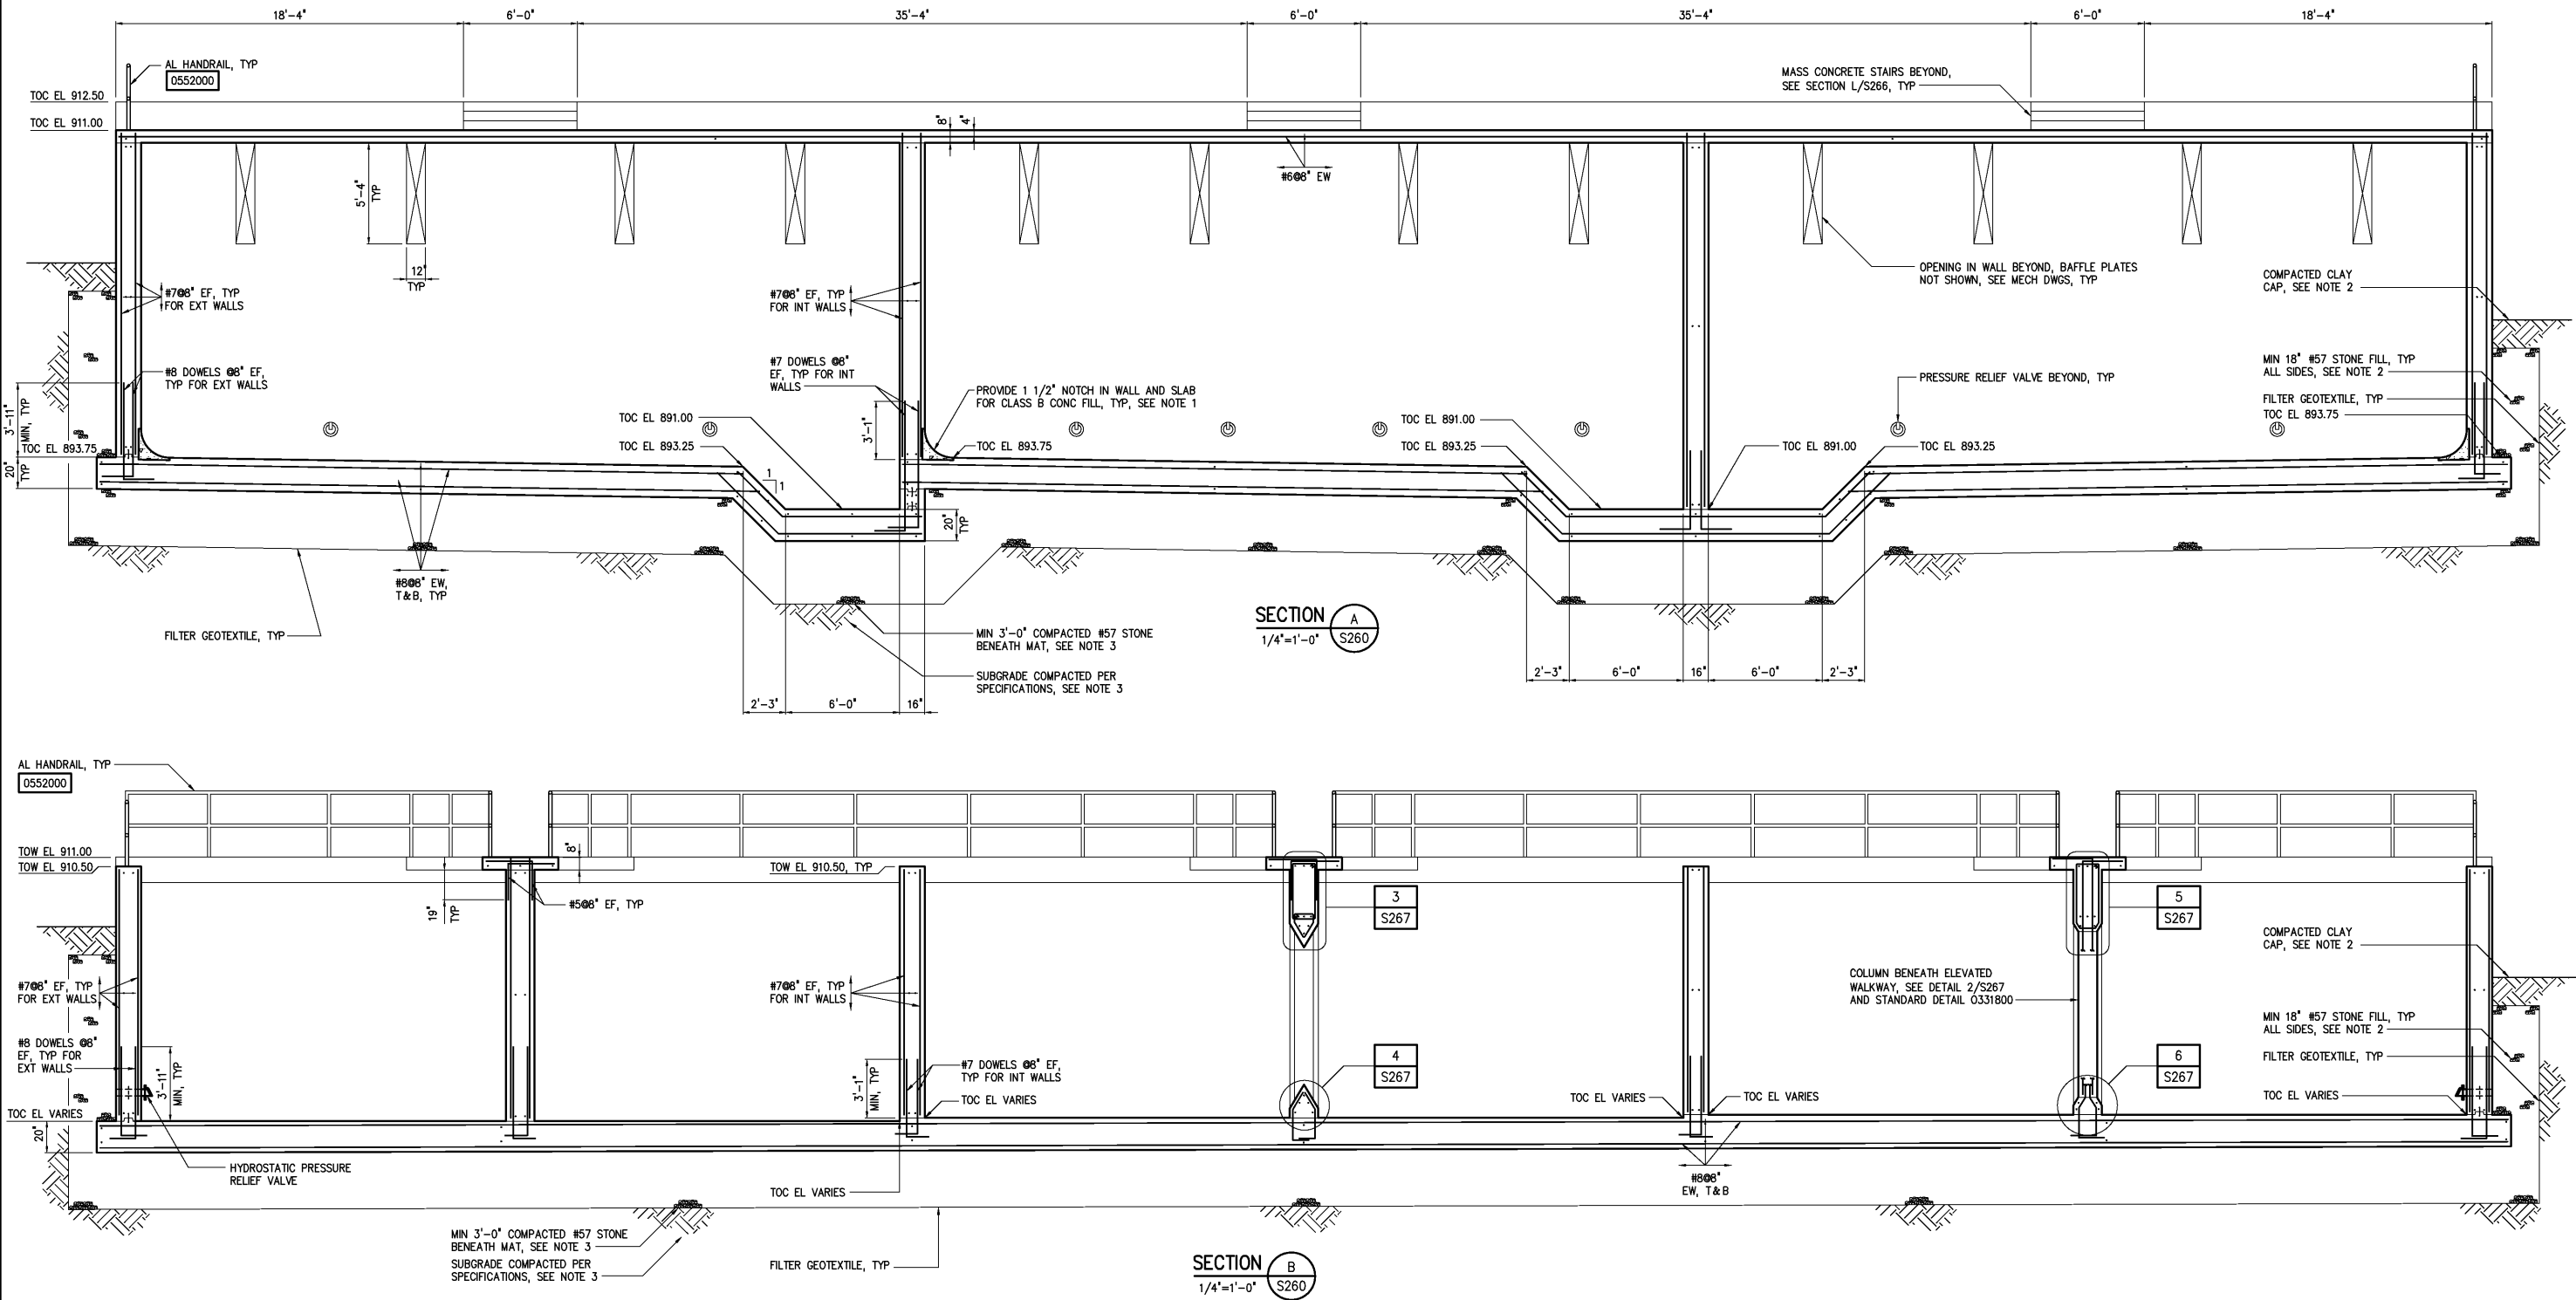

				DESIGNED _____ AGM	THIS DOCUMENT ORIGINALLY ISSUED FOR CONSTRUCTION AND SEALED BY ROBERT S. DIPIORE, SEAL NO. 22769	RECORD DRAWING  THIS DRAWING HAS BEEN MODIFIED TO REFLECT FIELD CHANGES REPORTED BY THE CONTRACTOR OR ANOTHER PARTY, BUT NOT VERIFIED BY THE CERTIFYING ENGINEER. THIS DOCUMENT ORIGINALLY ISSUED AND SEALED BY CHRISTOPHER T. PHILLIPS, 033796. THIS MEDIA SHALL NOT BE CONSIDERED A CERTIFIED DOCUMENT.	HAZEN AND SAWYER Environmental Engineers & Scientists 4011 WestChase Blvd, Raleigh, North Carolina 27607	CITY OF ROANOKE VIRGINIA	REGIONAL WATER POLLUTION CONTROL PLANT WET WEATHER IMPROVEMENTS	PRIMARY CLARIFIER NOS 7 - 9  STRUCTURAL  SECTIONS	THE SCALE BAR SHOWN BELOW MEASURES ONE INCH LONG ON THE ORIGINAL DRAWING.  _____	DATE JULY 2003 H & S JOB NUMBER 30788A CONTRACT NUMBER A DRAWING NUMBER S263
				DRAWN _____ AGM								
				CHECKED _____								
				PROJ. ENGR. _____ DAN								
	RECORD DRAWINGS	MAR 2008	RLT									
	CONSTRUCTION	MAR 2004	RLT									
	REGULATORY APPROVAL	NOV 2003	RLT									
	PRELIMINARY DESIGN	NOV 2002	RLT									
NO.	ISSUED FOR	DATE	BY	APPROVED								