

CONTRACT NUMBER

THE ORIGINAL


DRAWING.

DRAWING NUMBER

S582

STRUCTURAL

SECTIONS AND DETAILS

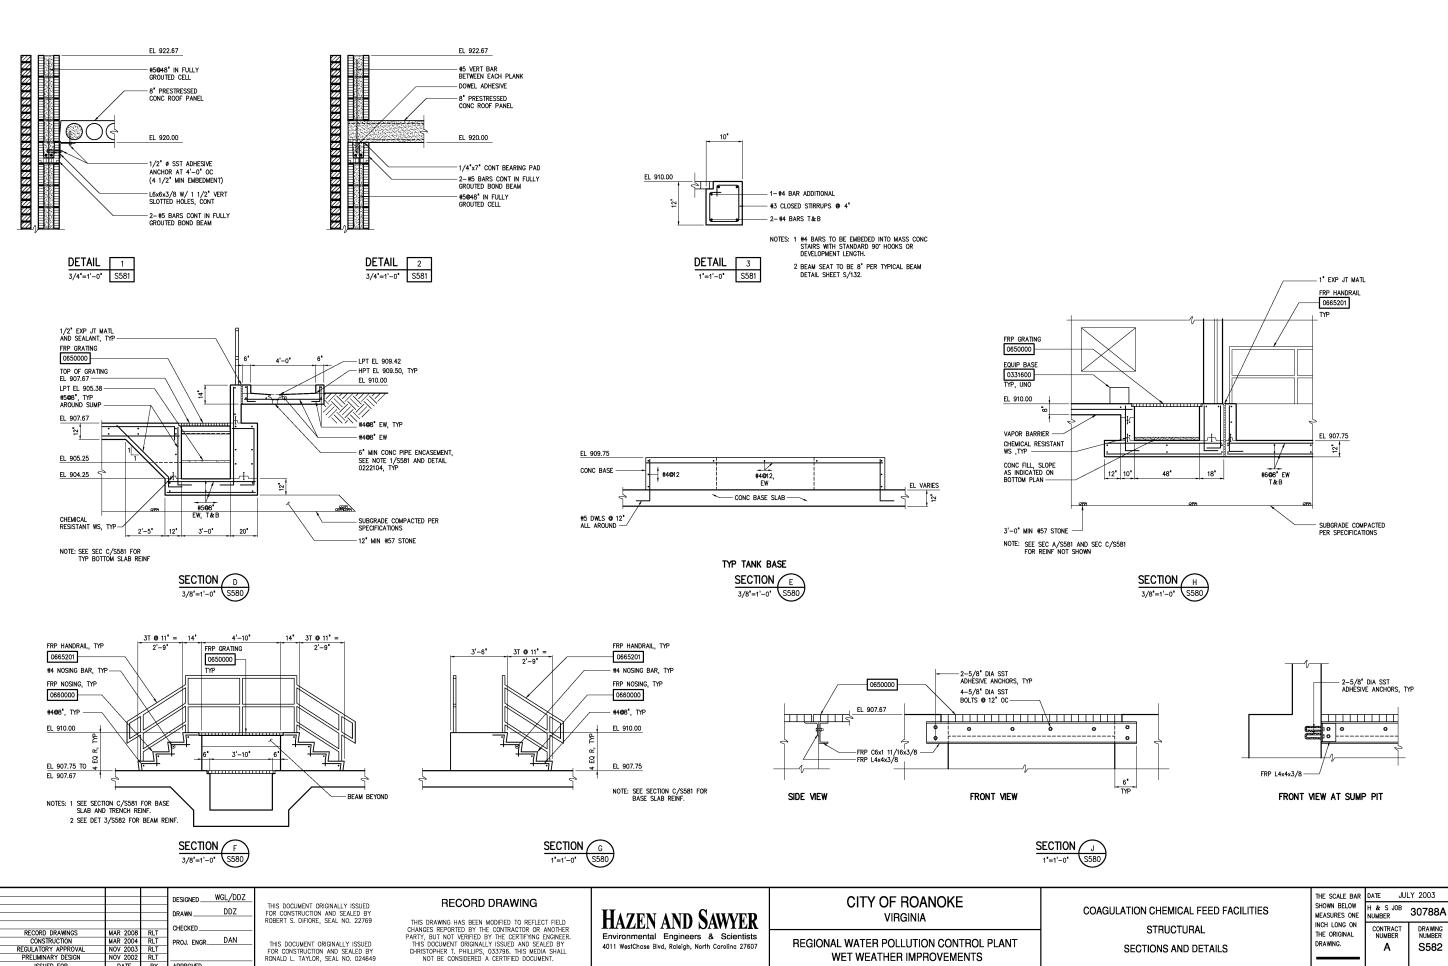

Environmental Engineers & Scientists

4011 WestChase Blvd, Raleigh, North Carolina 27607

REGIONAL WATER POLLUTION CONTROL PLANT

WET WEATHER IMPROVEMENTS

THIS DOCUMENT ORIGINALLY ISSUED FOR CONSTRUCTION AND SEALED BY RONALD L. TAYLOR, SEAL NO. 024649

CHECKED_

PROJ. ENGR._

RECORD DRAWINGS
CONSTRUCTION
REGULATORY APPROVAL