



- NOTES:
- 1 MASONRY REINF #5 @ 48" OC IN FULLY GROUTED CELLS, AT ALL CORNERS, AND ADJACENT TO ALL OPENINGS, ALL WALLS.
 - 2 DIMENSIONS GIVEN ARE TO NOMINAL FACE OF MASONRY.
 - 3 PROVIDE INSULATION FILL AS REQUIRED TO OBTAIN 1/4" PER FOOT SLOPE. PRECAST CONCRETE ROOF PANELS WILL HAVE A CAMBER.

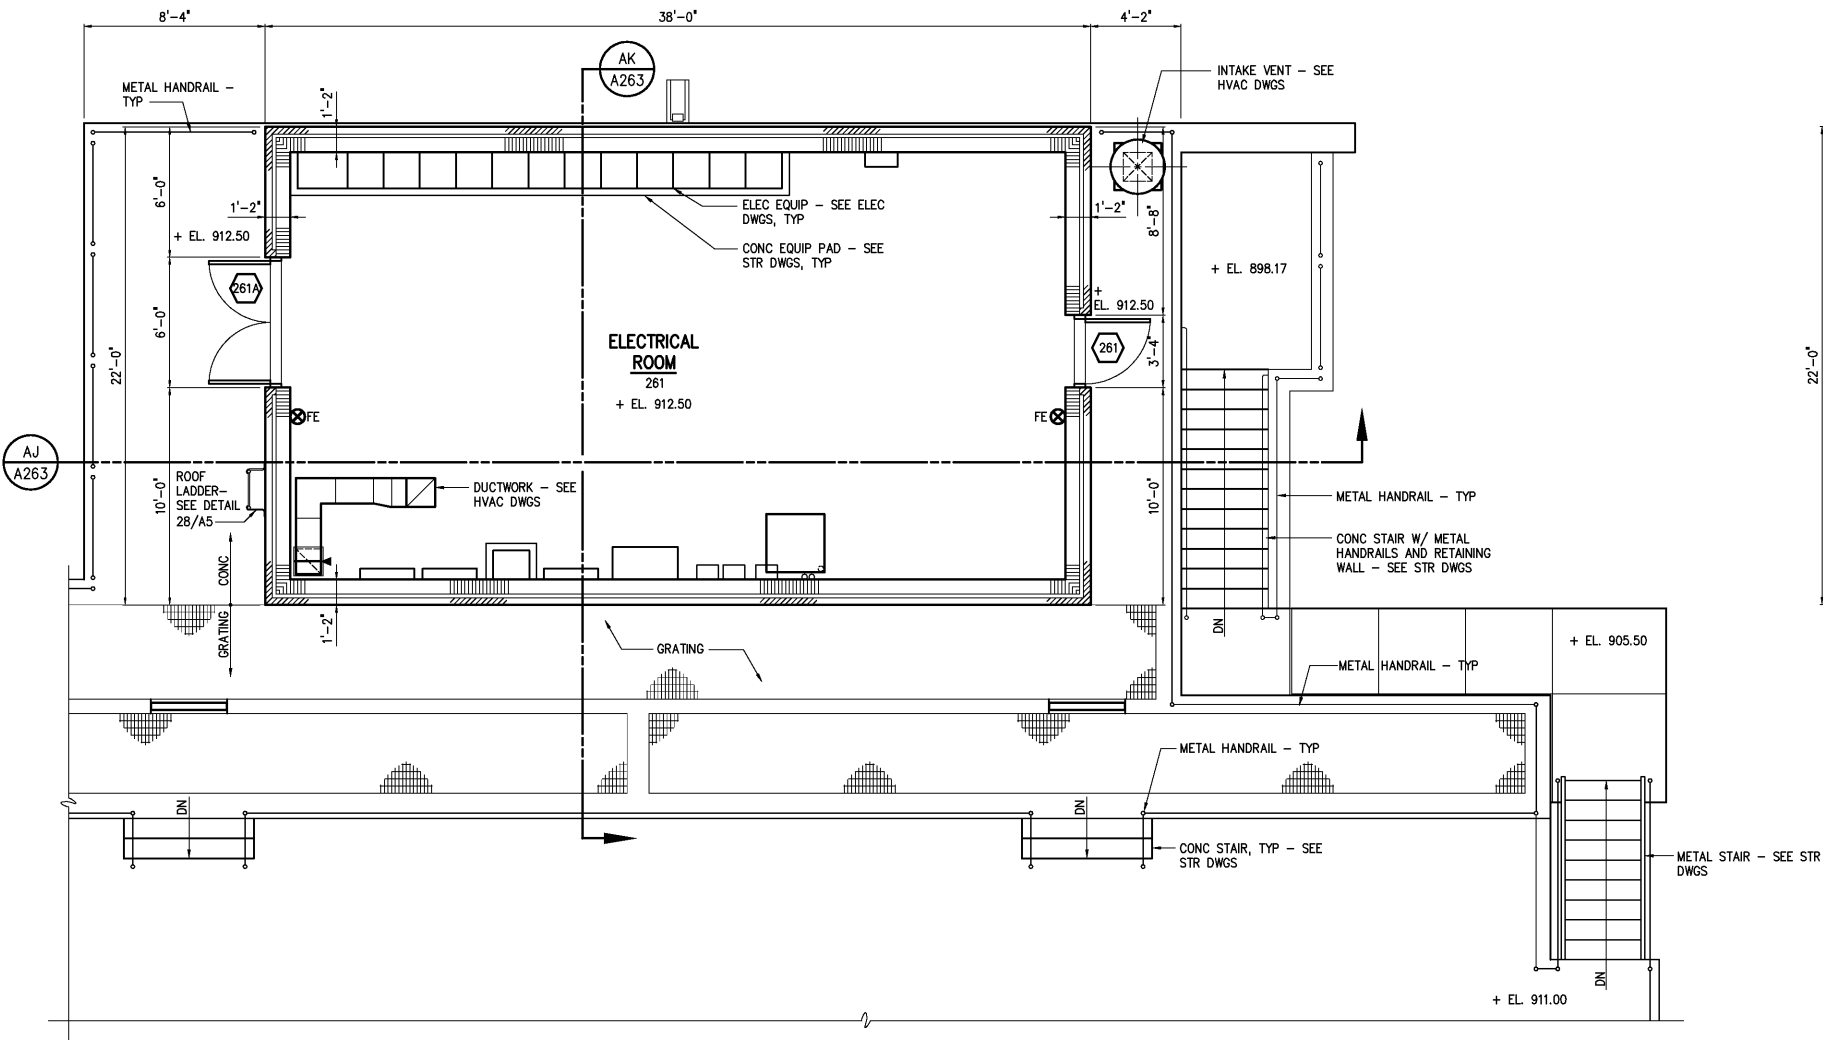

TOP PLAN
1/4"=1'-0"

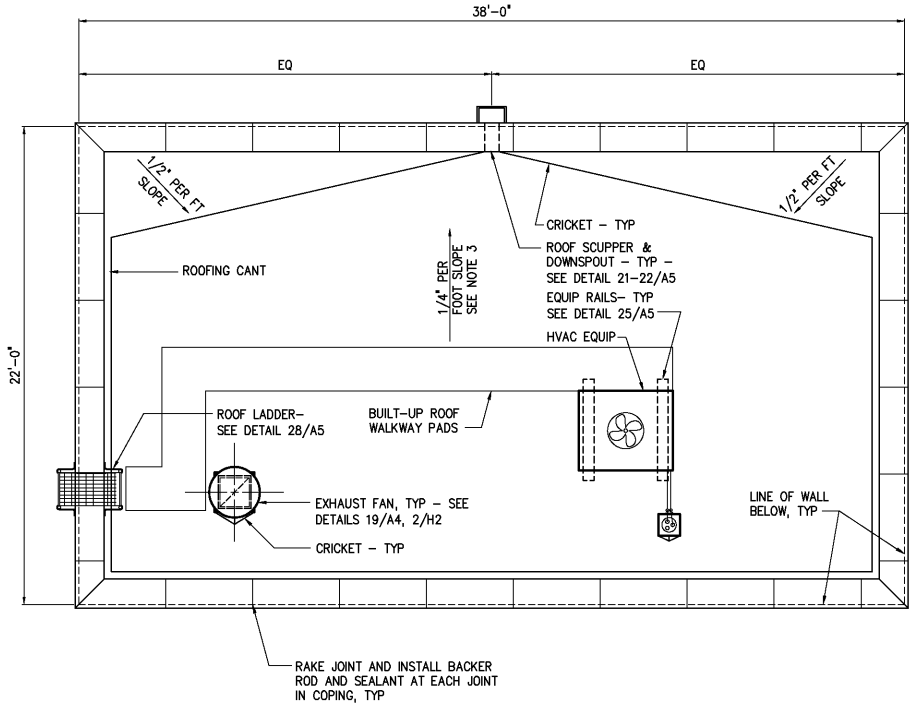

ROOF PLAN
1/4"=1'-0"

DESIGNED	WHR/DAW
DRAWN	ALB/DAW
CHECKED	
PROJ. ENGR.	DAN
APPROVED	
NO.	
RECORD DRAWINGS	MAR 2008
CONSTRUCTION	MAR 2004
REGULATORY APPROVAL	NOV 2003
PRELIMINARY DESIGN	NOV 2002
ISSUED FOR	DATE
	BY

THIS DOCUMENT ORIGINALLY ISSUED FOR CONSTRUCTION AND SEALED BY ROBERT S. DIFIORE, SEAL NO. 22769

THIS DOCUMENT ORIGINALLY ISSUED FOR CONSTRUCTION AND SEALED BY RONALD L. TAYLOR, SEAL NO. 024649

RECORD DRAWING

THIS DRAWING HAS BEEN MODIFIED TO REFLECT FIELD CHANGES REPORTED BY THE CONTRACTOR OR ANOTHER PARTY, BUT NOT VERIFIED BY THE CERTIFYING ENGINEER. THIS DOCUMENT ORIGINALLY ISSUED AND SEALED BY WILLIAM H. RUSSELL, SEAL NUMBER 008532. THIS MEDIA SHALL NOT BE CONSIDERED A CERTIFIED DOCUMENT.

HAZEN AND SAWYER
Environmental Engineers & Scientists
4011 WestChase Blvd, Raleigh, North Carolina 27607

CITY OF ROANOKE
VIRGINIA

REGIONAL WATER POLLUTION CONTROL PLANT
WET WEATHER IMPROVEMENTS

PRIMARY CLARIFIERS NOS. 7-9
ARCHITECTURAL
TOP PLAN AND ROOF PLAN

THE SCALE BAR SHOWN BELOW MEASURES ONE INCH LONG ON THE ORIGINAL DRAWING.

DATE	JULY 2003
H & S JOB NUMBER	30788A
CONTRACT NUMBER	A
DRAWING NUMBER	A261