



NOTES:  
1 PROVIDE WALL PIPE FOR 18" FRP PER STD DETAIL 1509205.

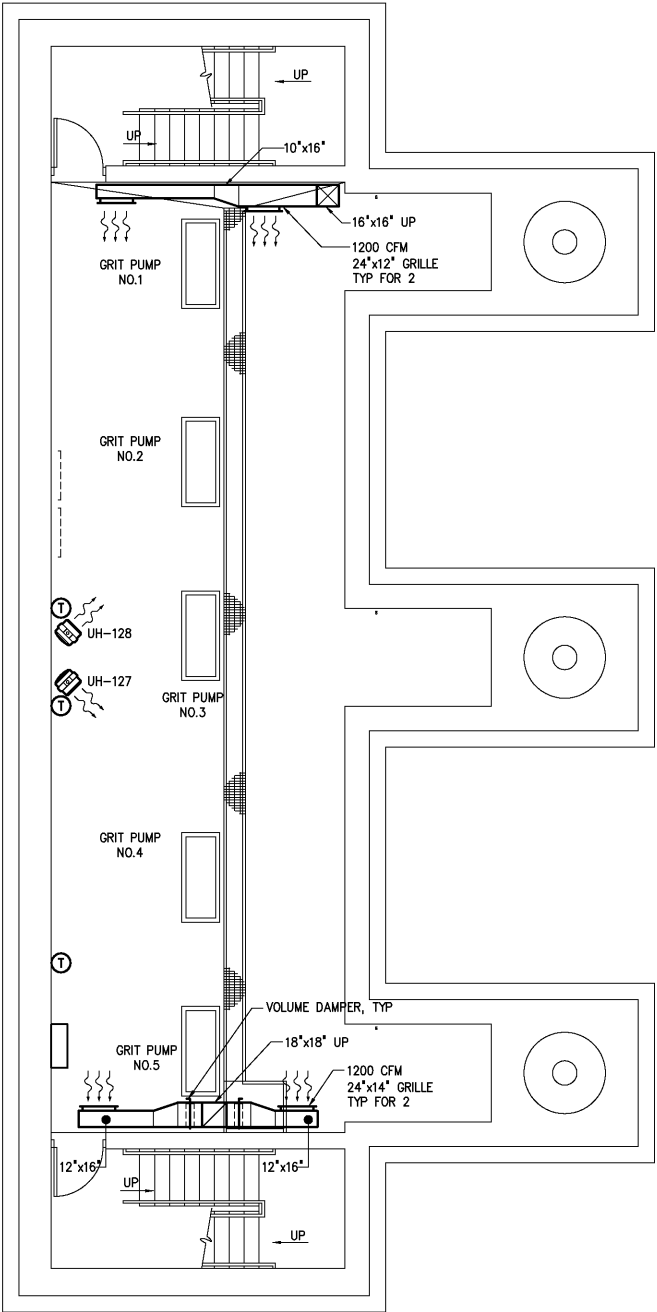

**BOTTOM PLAN**  
3/16"=1'-0"

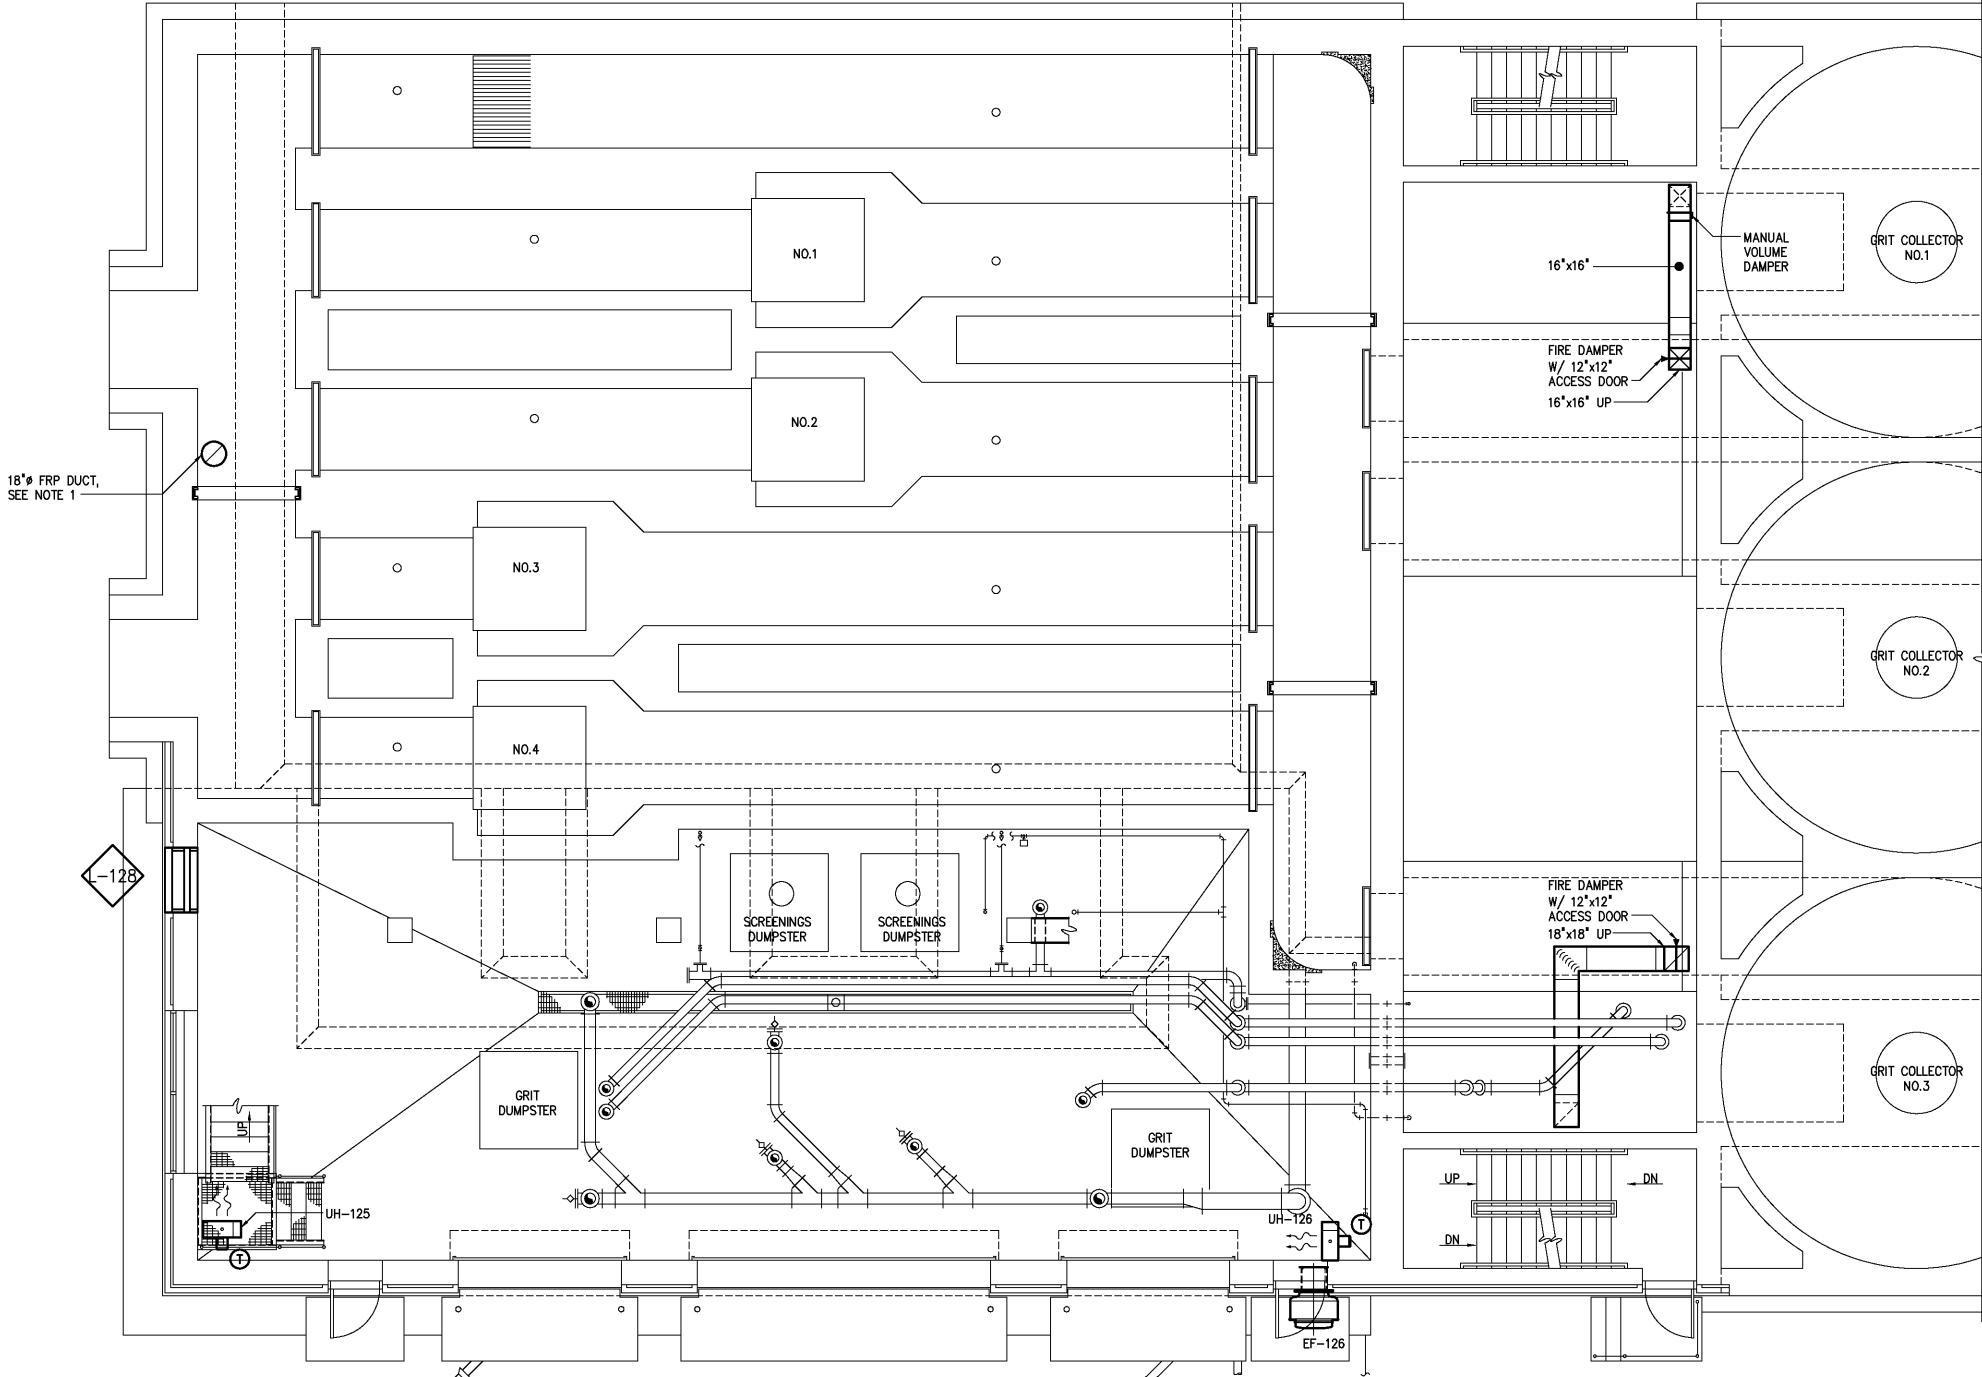

**INTERMEDIATE PLAN**  
3/16"=1'-0"

DESIGNED	H & S
DRAWN	H & S
CHECKED	
PROJ. ENGR.	DAN
APPROVED	
NO.	
ISSUED FOR	
DATE	BY
RECORD DRAWINGS	MAR 2008 RLT
CONSTRUCTION	MAR 2004 RLT
REGULATORY APPROVAL	NOV 2003 RLT
PRELIMINARY DESIGN	NOV 2002 RLT

THIS DOCUMENT ORIGINALLY ISSUED FOR CONSTRUCTION AND SEALED BY ROBERT S. DIFIORE, SEAL NO. 22769

THIS DOCUMENT ORIGINALLY ISSUED FOR CONSTRUCTION AND SEALED BY RONALD L. TAYLOR, SEAL NO. 024649

**RECORD DRAWING**

THIS DRAWING HAS BEEN MODIFIED TO REFLECT FIELD CHANGES REPORTED BY THE CONTRACTOR OR ANOTHER PARTY, BUT NOT VERIFIED BY THE CERTIFYING ENGINEER. THIS DOCUMENT ORIGINALLY ISSUED AND SEALED BY DAVID A. NAILOR, 025465. THIS MEDIA SHALL NOT BE CONSIDERED A CERTIFIED DOCUMENT.

**HAZEN AND SAWYER**  
Environmental Engineers & Scientists  
4011 WestChase Blvd, Raleigh, North Carolina 27607

**CITY OF ROANOKE**  
VIRGINIA  
**REGIONAL WATER POLLUTION CONTROL PLANT**  
**WET WEATHER IMPROVEMENTS**

**PRELIMINARY TREATMENT FACILITIES**  
**HVAC**  
**BOTTOM PLAN & INTERMEDIATE PLAN**

THE SCALE BAR SHOWN BELOW MEASURES ONE INCH LONG ON THE ORIGINAL DRAWING.	DATE JULY 2003
H & S JOB NUMBER	30788A
CONTRACT NUMBER	A
DRAWING NUMBER	H120