


NOTES:

1 THE CONTRACTOR SHALL COORDINATE THE INSTALLATION OF ALL NEW ELECTRIC SERVICES WITH AMERICAN ELECTRIC POWER (AEP). THE CONTRACTOR SHALL ALSO BE RESPONSIBLE FOR THE UTILITY TRANSFORMERS SUPPLIED BY AEP. AT EACH NEW TRANSFORMER PAD, THE CONTRACTOR SHALL FURNISH AND INSTALL A STAINLESS STEEL UNISTRUT RACK ADJACENT TO EACH TRANSFORMER FOR MOUNTING THE METERING EQUIPMENT SUPPLIED BY AEP. THE CONTRACTOR SHALL COORDINATE THE SIZE AND LOCATION OF EACH METERING EQUIPMENT RACK WITH AEP. REFERENCE SPECIFICATION SECTION 01520 FOR ADDITIONAL INFORMATION.

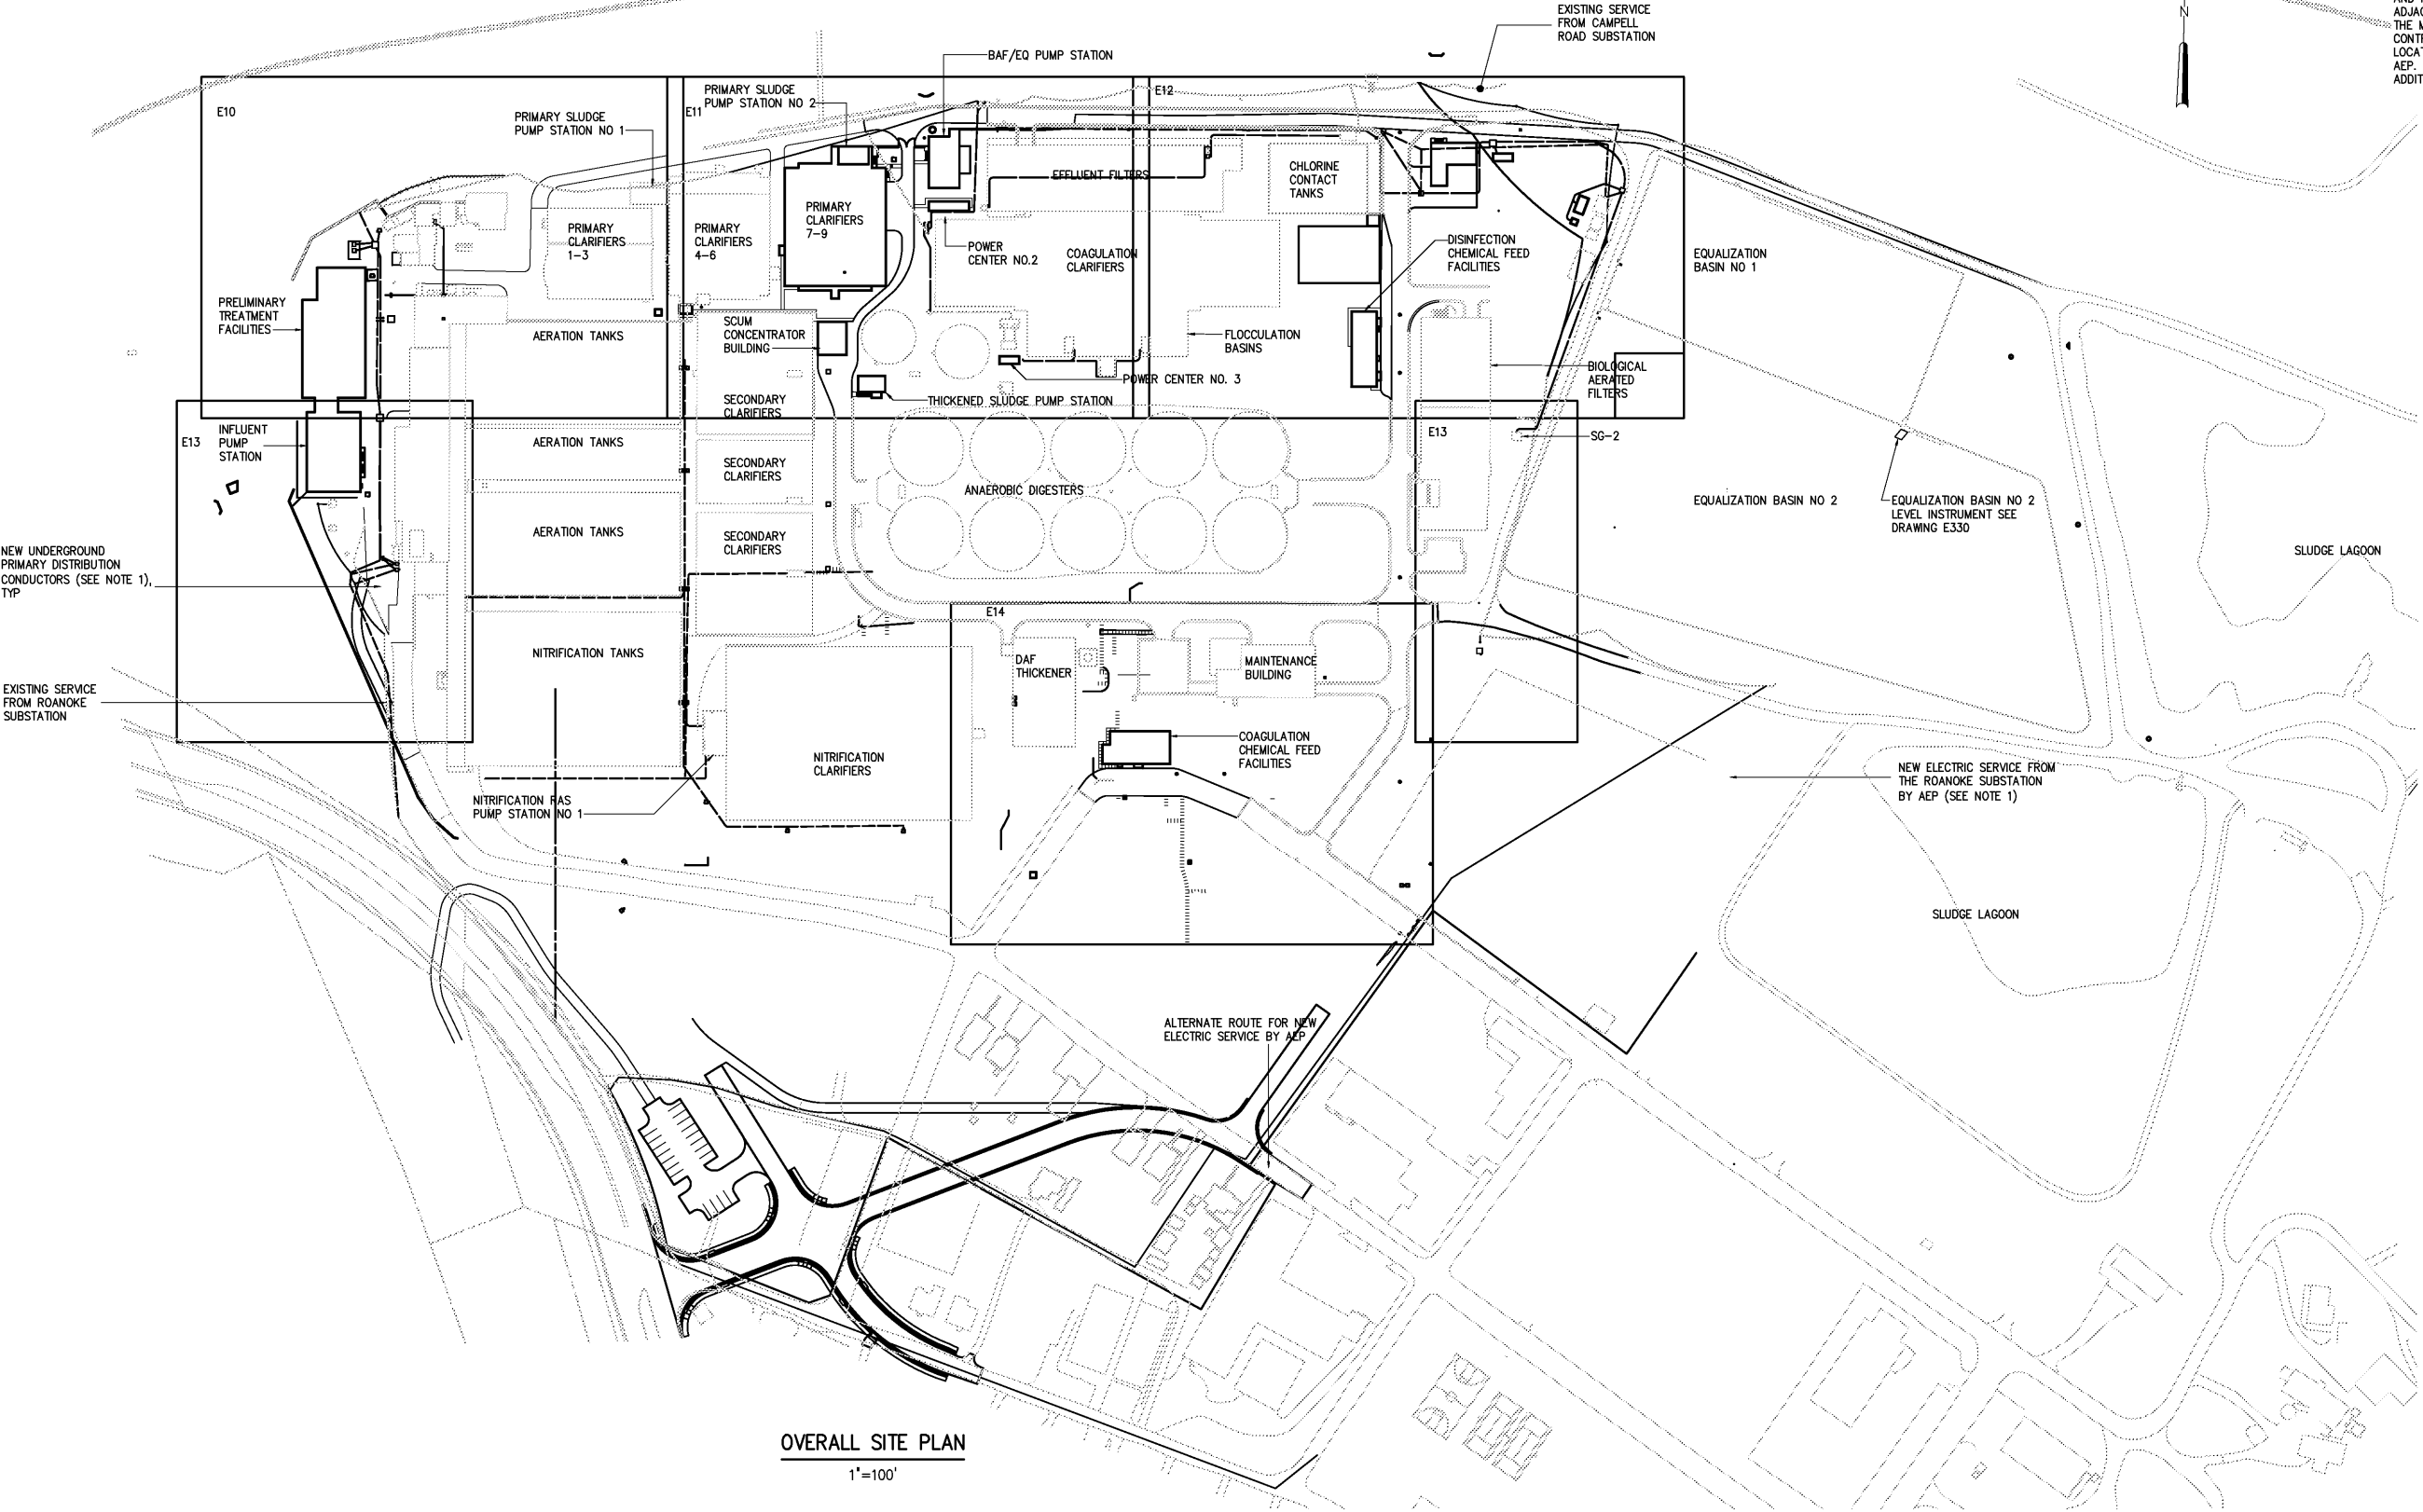

OVERALL SITE PLAN
1"=100'

				DESIGNED	BRL
				DRAWN	BRL
				CHECKED	
	RECORD DRAWINGS	MAR 2008	RLT	PROJ. ENGR.	RLT
	CONSTRUCTION	MAR 2004	RLT		
	REGULATORY APPROVAL	NOV 2003	RLT		
	PRELIMINARY DESIGN	NOV 2002	RLT		
NO.	ISSUED FOR	DATE	BY	APPROVED	

THIS DOCUMENT ORIGINALLY ISSUED FOR CONSTRUCTION AND SEALED BY ROBERT S. DIFIORE, SEAL NO. 22769

RECORD DRAWING

THIS DRAWING HAS BEEN MODIFIED TO REFLECT FIELD CHANGES REPORTED BY THE CONTRACTOR OR ANOTHER PARTY, BUT NOT VERIFIED BY THE CERTIFYING ENGINEER. THIS DOCUMENT ORIGINALLY ISSUED AND SEALED BY GERALD J. RATASKY, 026535. THIS MEDIA SHALL NOT BE CONSIDERED A CERTIFIED DOCUMENT.

THIS DOCUMENT ORIGINALLY ISSUED FOR CONSTRUCTION AND SEALED BY RONALD L. TAYLOR, SEAL NO. 024649

HAZEN AND SAWYER
Environmental Engineers & Scientists
4011 WestChase Blvd, Raleigh, North Carolina 27607

CITY OF ROANOKE
VIRGINIA

REGIONAL WATER POLLUTION CONTROL PLANT
WET WEATHER IMPROVEMENTS

SITE PLAN
ELECTRICAL
OVERALL SITE PLAN

THE SCALE BAR SHOWN BELOW MEASURES ONE INCH LONG ON THE ORIGINAL DRAWING.	DATE	JULY 2003
	H & S JOB NUMBER	30788A
	CONTRACT NUMBER	A
	DRAWING NUMBER	E2