


DUCTBANK CONDUIT AND WIRE	
NO.	DESCRIPTION
37	3#350kcmil, #4G, 3°C) 1-3'SP.C.
38	CABLE BY INSTRUMENTATION SUBCONTRACTOR, 2°C 2-2'SP.C.

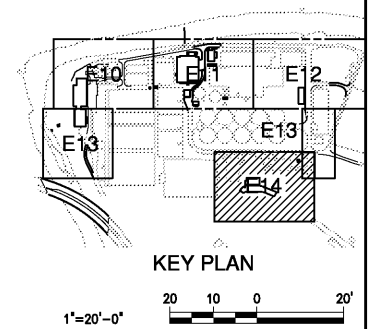

			DESIGNED	BRL	THIS DOCUMENT ORIGINALLY ISSUED FOR CONSTRUCTION AND SEALED BY ROBERT S. DIFIORE, SEAL NO. 22769	RECORD DRAWING	THIS DRAWING HAS BEEN MODIFIED TO REFLECT FIELD CHANGES REPORTED BY THE CONTRACTOR OR ANOTHER PARTY, BUT NOT VERIFIED BY THE CERTIFYING ENGINEER. THIS DOCUMENT ORIGINALLY ISSUED AND SEALED BY GERALD J. RATASKY, 026535. THIS MEDIA SHALL NOT BE CONSIDERED A CERTIFIED DOCUMENT.	HAZEN AND SAWYER Environmental Engineers & Scientists 4011 WestChase Blvd, Raleigh, North Carolina 27607	CITY OF ROANOKE VIRGINIA	REGIONAL WATER POLLUTION CONTROL PLANT WET WEATHER IMPROVEMENTS	SITE PLAN ELECTRICAL PARTIAL SITE PLAN	THE SCALE BAR SHOWN BELOW MEASURES ONE INCH LONG ON THE ORIGINAL DRAWING.	DATE	JULY 2003				
			DRAWN	BRL									H & S JOB NUMBER	30788A				
			CHECKED						THIS DOCUMENT ORIGINALLY ISSUED FOR CONSTRUCTION AND SEALED BY RONALD L. TAYLOR, SEAL NO. 024649								CONTRACT NUMBER	DRAWING NUMBER
RECORD DRAWINGS CONSTRUCTION REGULATORY APPROVAL PRELIMINARY DESIGN ISSUED FOR NO.			MAR 2008 MAR 2004 NOV 2003 NOV 2002 DATE	RLT RLT RLT RLT BY													PROJ. ENGR. DAN	A