

NOTES:

1 THE SCREEN BRUSH MOTOR SHALL BE INSTALLED FOR THE TYPE "A" SCREEN ONLY (REFERENCE SPECIFICATION 11420.) THE STARTERS FOR THE SCREEN BRUSH MOTORS SHALL BE INSTALLED AND

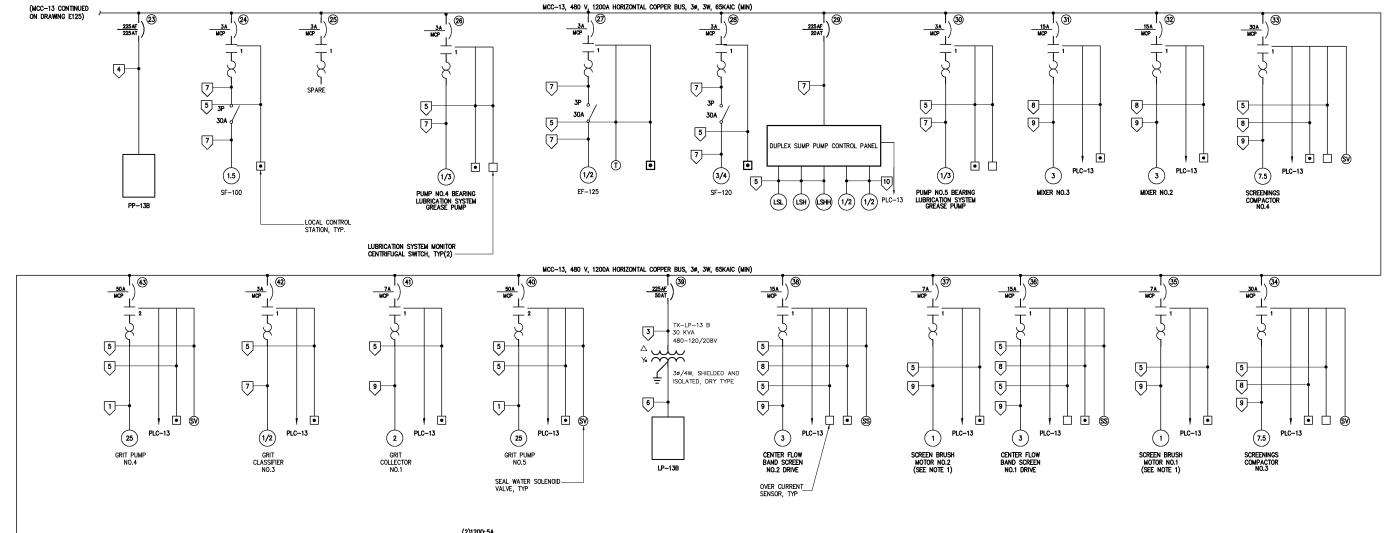

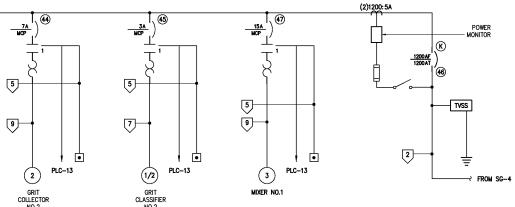

	CONDUIT AND WIRE LEGEND (NUMBERS REFERENCE THIS SHEET ONLY)				
NO.	O. DESCRIPTION				
1	3#8, 2#12, 4#14, #10G, 1*C				
2	4(3#500kcmil, #4/0G, 4°C)				
3	3#6, #8G, 1*C				
4	3#350kcmil, #4G, 4*C				
5	4#14, #14G, 3/4°C				
6	4#3, #6G, 2*C				
7	3#12, #12G, 3/4°C				
8	8#14, #14G, 3/4°C				
9	5#12, 4#14, #12G, 3/4°C				
10	CABLE BY PUMP SUPPLIER, 1°C				

MCC-13 SINGLE LINE DIAGRAM

				DESIGNED	BRL
				DRAWN	BRL
				CHECKED	
	RECORD DRAWINGS	MAR 2008	RLT	OTTE OTTE D	
	CONSTRUCTION	MAR 2004	RLT	PROJ. ENGR.	DAN
	REGULATORY APPROVAL	NOV 2003	RLT		
	PRELIMINARY DESIGN	NOV 2002	RLT		
NO.	ISSUED FOR	DATE	BY	APPROVED	

THIS DOCUMENT ORIGINALLY ISSUED FOR CONSTRUCTION AND SEALED BY ROBERT S. DIFIORE, SEAL NO. 22769

THIS DOCUMENT ORIGINALLY ISSUED FOR CONSTRUCTION AND SEALED BY RONALD L. TAYLOR, SEAL NO. 024649

RECORD DRAWING THIS DRAWING HAS BEEN MODIFIED TO REFLECT FIELD CHANGES REPORTED BY THE CONTRACTOR OR ANOTHER PARTY, BUT NOT VERRIED BY THE CERTIFYING ENGINER. THIS DOCUMENT ORIGINALLY ISSUED AND SEALED BY GERALD J. RATASKY, 028535. THIS MEDIA SHALL NOT BE CONSIDERED A CERTIFIED DOCUMENT.

HAZEN AND SAWYER Environmental Engineers & Scientists 4011 WestChase Blvd, Raleigh, North Carolina 27607 CITY OF ROANOKE VIRGINIA

REGIONAL WATER POLLUTION CONTROL PLANT WET WEATHER IMPROVEMENTS

PRELIMINARY TREATMENT FACILITIES ELECTRICAL SINGLE LINE DIAGRAM

	THE SCALE BAR SHOWN BELOW MEASURES ONE INCH LONG ON THE ORIGINAL	DATE
		H & S NUMBER
		CONTR. NUMB
	DRAWING.	Α

E BAR	DATE JUL	Y 2003
ELOW	H & S JOB	30788A
S ONE	NUMBER	30/00A
G ON	CONTRACT	DRAWING
INAL	NUMBER	NUMBER
	A	F126