



NOTES:




EF-122 EXHAUST FAN
ELEMENTARY CONTROL SCHEMATIC

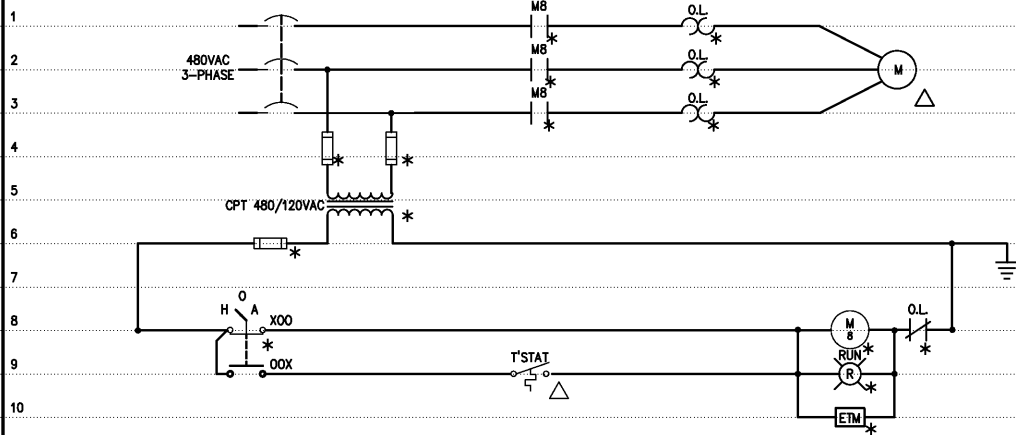


EF-123 EXHAUST FAN
ELEMENTARY CONTROL SCHEMATIC

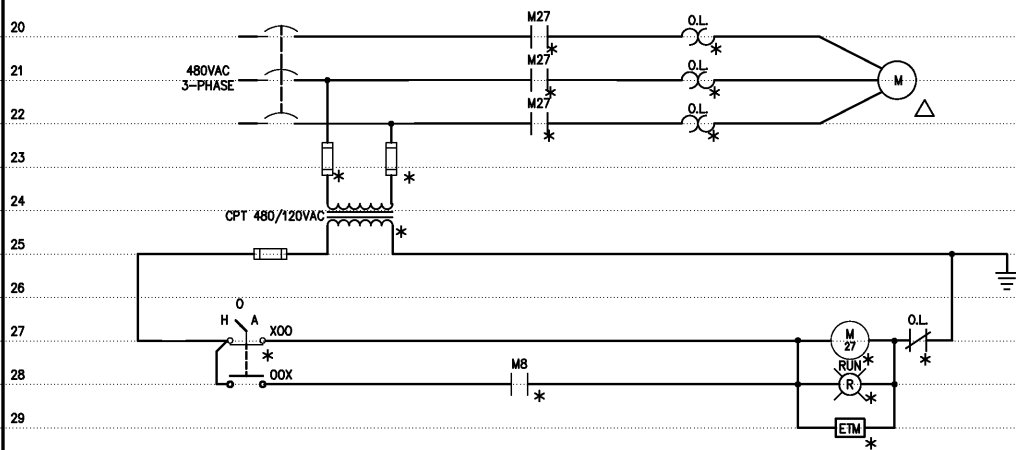


SF-100 SUPPLY FAN
ELEMENTARY CONTROL SCHEMATIC

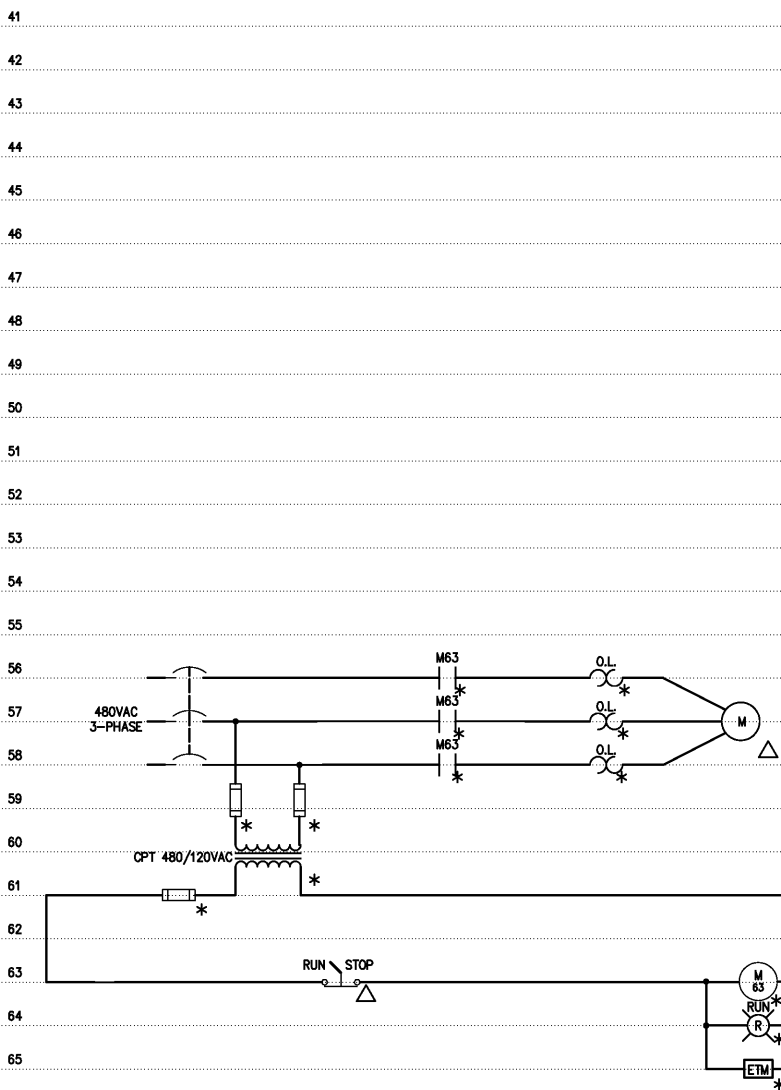


SF-120 MOTOR STARTER
ELEMENTARY CONTROL SCHEMATIC

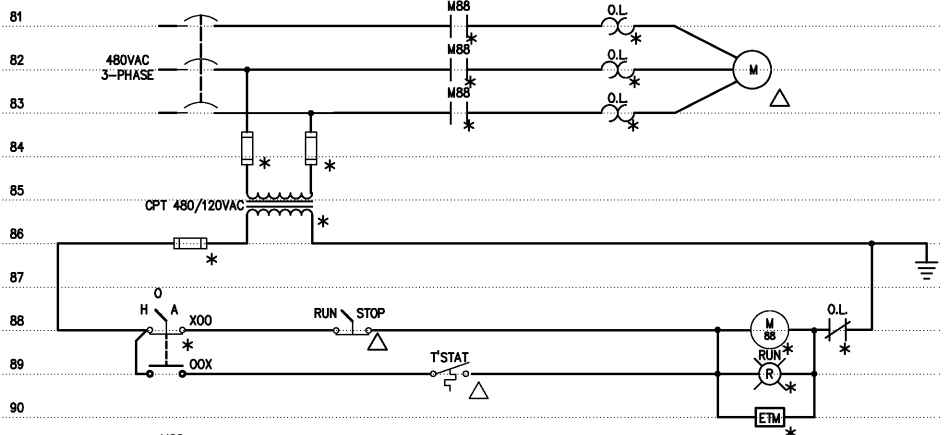

EF-125 MOTOR STARTER
ELEMENTARY CONTROL SCHEMATIC

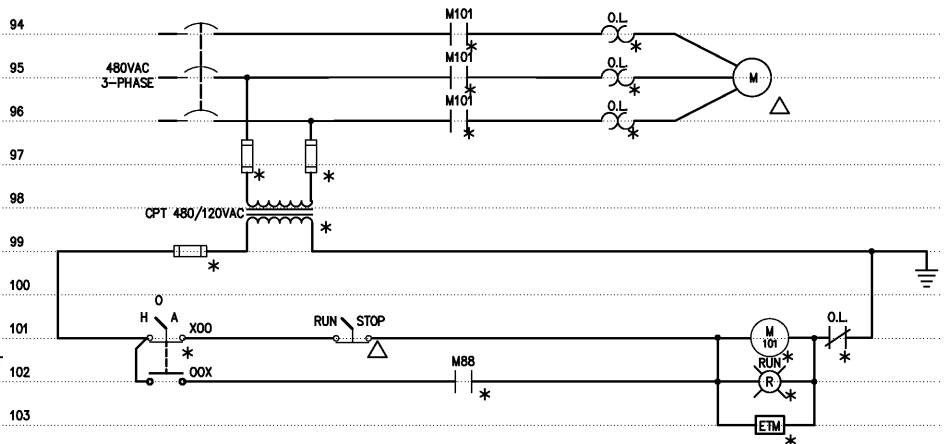

SF-120 MOTOR STARTER
ELEMENTARY CONTROL SCHEMATIC

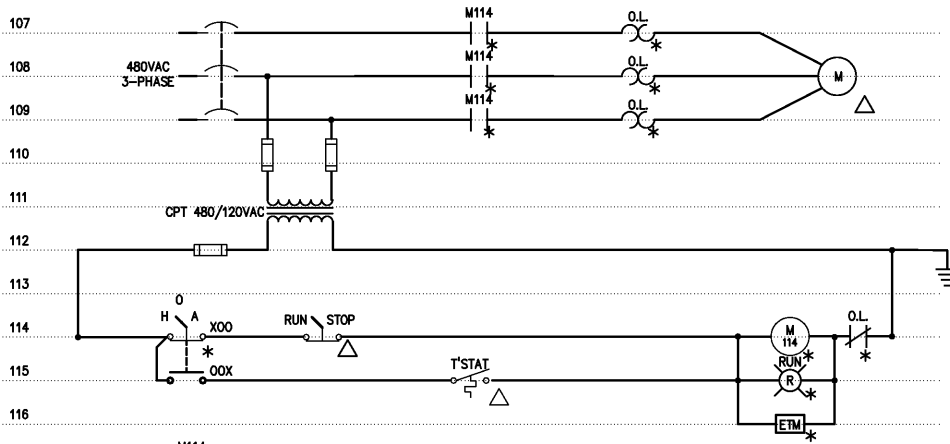

EF-126 MOTOR STARTER
ELEMENTARY CONTROL SCHEMATIC

DESIGNED	BRL
DRAWN	BRL
CHECKED	
PROJ. ENGR.	DAN
APPROVED	
NO.	

THIS DOCUMENT ORIGINALLY ISSUED
FOR CONSTRUCTION AND SEALED BY
ROBERT S. DIFIORE, SEAL NO. 22769

RECORD DRAWING

THIS DRAWING HAS BEEN MODIFIED TO REFLECT FIELD
CHANGES REPORTED BY THE CONTRACTOR OR ANOTHER
PARTY, BUT NOT VERIFIED BY THE CERTIFYING ENGINEER.
THIS DOCUMENT ORIGINALLY ISSUED AND SEALED BY
GERALD J. RATASKY, 026535. THIS MEDIA SHALL NOT
BE CONSIDERED A CERTIFIED DOCUMENT.

THIS DOCUMENT ORIGINALLY ISSUED
FOR CONSTRUCTION AND SEALED BY
RONALD L. TAYLOR, SEAL NO. 024649

HAZEN AND SAWYER
Environmental Engineers & Scientists
4011 WestChase Blvd, Raleigh, North Carolina 27607

CITY OF ROANOKE
VIRGINIA

REGIONAL WATER POLLUTION CONTROL PLANT
WET WEATHER IMPROVEMENTS

PRELIMINARY TREATMENT FACILITIES
ELECTRICAL
ELEMENTARY CONTROL SCHEMATICS

THE SCALE BAR SHOWN BELOW MEASURES ONE INCH LONG ON THE ORIGINAL DRAWING.	DATE JULY 2003
H & S JOB NUMBER 30788A	CONTRACT NUMBER A
DRAWING NUMBER E131	