



NOTES:

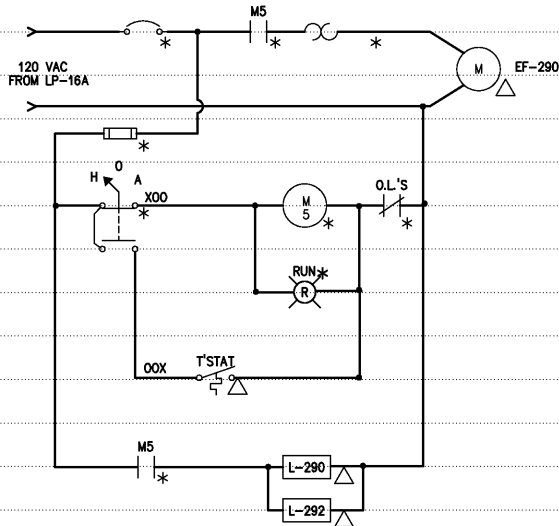


EXHAUST FAN EF-290

ELEMENTARY CONTROL SCHEMATIC

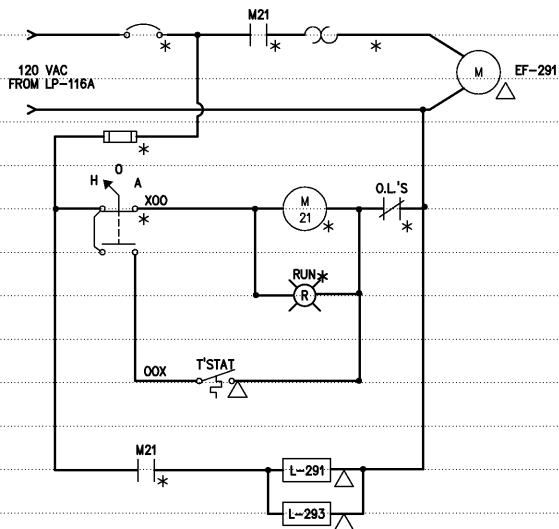

EXHAUST FAN EF-291

ELEMENTARY CONTROL SCHEMATIC

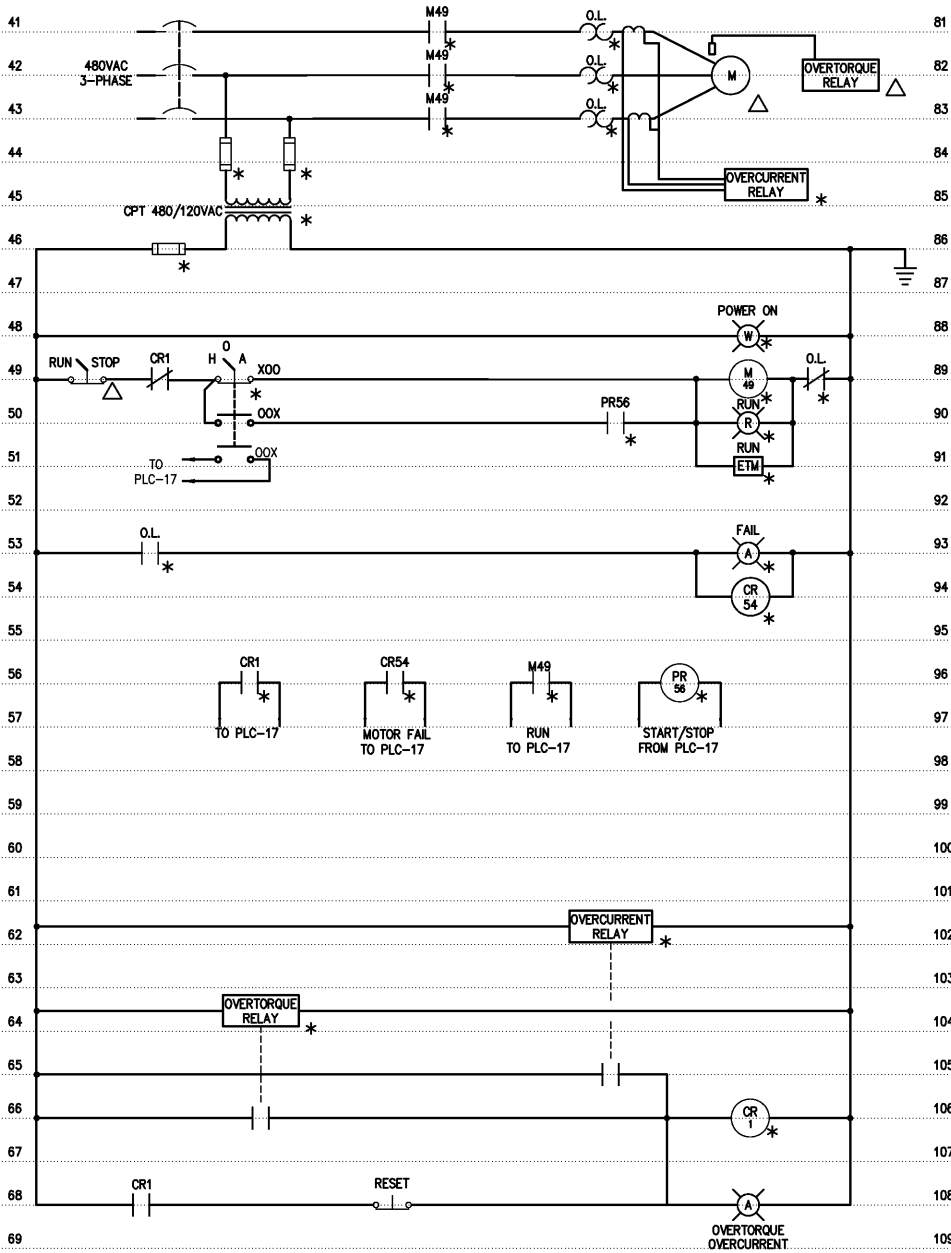

SCUM CONCENTRATOR NO. 1 MOTOR CONTROLLER

ELEMENTARY CONTROL SCHEMATIC

DESIGNED BRL				RECORD DRAWING		CITY OF ROANOKE VIRGINIA		SCUM CONCENTRATOR BUILDING		DATE JULY 2003	
DRAWN BRL				THIS DOCUMENT ORIGINALLY ISSUED FOR CONSTRUCTION AND SEALED BY ROBERT S. DIFIORE, SEAL NO. 22769		HAZEN AND SAWYER Environmental Engineers & Scientists 4011 WestChase Blvd, Raleigh, North Carolina 27607		ELECTRICAL		H & S JOB NUMBER 30788A	
CHECKED				THIS DRAWING HAS BEEN MODIFIED TO REFLECT FIELD CHANGES REPORTED BY THE CONTRACTOR OR ANOTHER PARTY, BUT NOT VERIFIED BY THE CERTIFYING ENGINEER.		REGIONAL WATER POLLUTION CONTROL PLANT WET WEATHER IMPROVEMENTS		ELEMENTARY CONTROL SCHEMATICS		CONTRACT NUMBER A	
PROJ. ENGR. DAN				THIS DOCUMENT ORIGINALLY ISSUED FOR CONSTRUCTION AND SEALED BY RONALD L. TAYLOR, SEAL NO. 024649						DRAWING NUMBER E291	
ISSUED FOR											
DATE BY											
APPROVED											

THE SCALE BAR SHOWN BELOW MEASURES ONE INCH LONG ON THE ORIGINAL DRAWING.