
NOTES:

1 MOUNT LIT-33402 ON HANDRAIL.

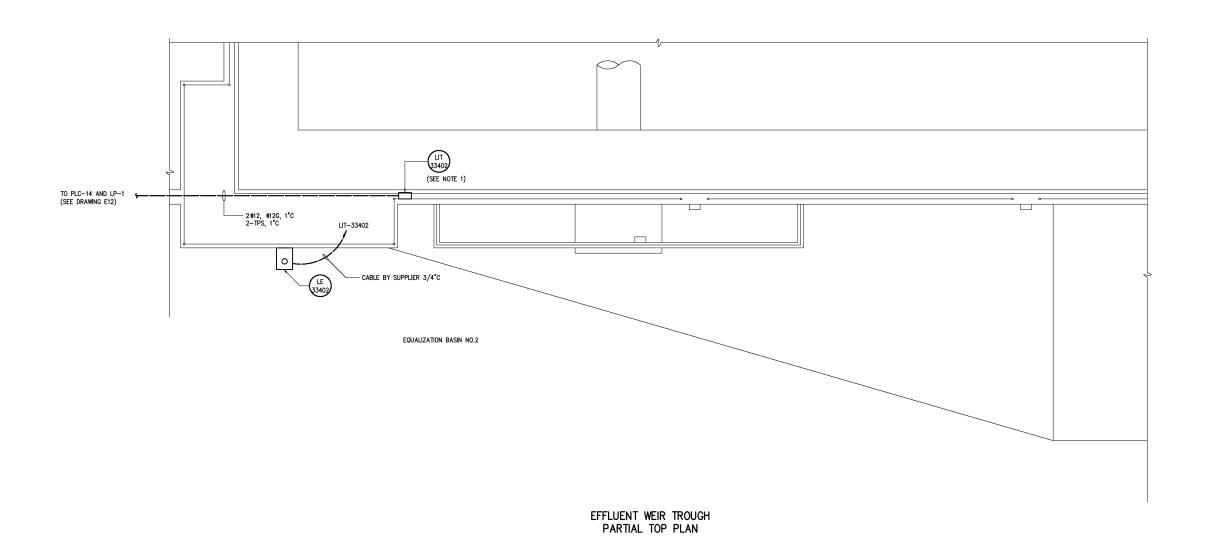

			DESIGNED	BRL	
			DRAWN	BKJ	
RECORD DRAWINGS	MAR 2008	RLT	CHECKED		
CONSTRUCTION	MAR 2004	RLT	PROJ. ENGR	DAN	ı
REGULATORY APPROVAL	NOV 2003	RLT			ı
PRELIMINARY DESIGN	NOV 2002	RLT			ı

THIS DOCUMENT ORIGINALLY ISSUED FOR CONSTRUCTION AND SEALED BY ROBERT S. DIFIORE, SEAL NO. 22769

THIS DRAWING HAS BEEN MODIFIED TO REFLECT FIELD CHANGES REPORTED BY THE CONTRACTOR OR ANOTHER PARTY, BUT NOT VERIFIED BY THE CERTIFYING ENGINEER. THIS DOCUMENT ORIGINALLY ISSUED AND SEALED BY GEALD J. RATASKY, 0265.35. THIS MEDIA SHALL NOT BE CONSIDERED A CERTIFIED DOCUMENT. THIS DOCUMENT ORIGINALLY ISSUED FOR CONSTRUCTION AND SEALED BY RONALD L. TAYLOR, SEAL NO. 024649

RECORD DRAWING

HAZEN AND SAWYER

Environmental Engineers & Scientists 4011 WestChase Blvd, Raleigh, North Carolina 27607 CITY OF ROANOKE VIRGINIA

REGIONAL WATER POLLUTION CONTROL PLANT WET WEATHER IMPROVEMENTS

FLOW EQUALIZATION BASIN MODIFICATIONS ELECTRICAL PLANS

THE SCALE BAR SHOWN BELOW MEASURES ONE INCH LONG ON THE ORIGINAL DRAWING.

THE SCALE BAR SALE JULY 2003

H & S JOB OTRACT ONTRACT NUMBER

CONTRACT NUMBER

A E330 H & S JOB 30788A DRAWING NUMBER E330

DATE BY APPROVED ISSUED FOR