


- NOTES:
- 1 EXISTING BAF WONDERWARE INTOUCH HMI APPLICATION SHALL BE REPLACED WITH NEW INTELLUTION-BASED HMI APPLICATION TO MATCH REMAINDER OF CONTROL AND INFORMATION SYSTEM. REFER TO SPECIFICATIONS.
- 2 CONTROL SYSTEM EQUIPMENT SHOWN ON THIS DRAWING WILL BE FURNISHED UNDER TWO CONTRACTS, AS SHOWN. REFER TO SPECIFICATIONS FOR FURTHER DETAILS.

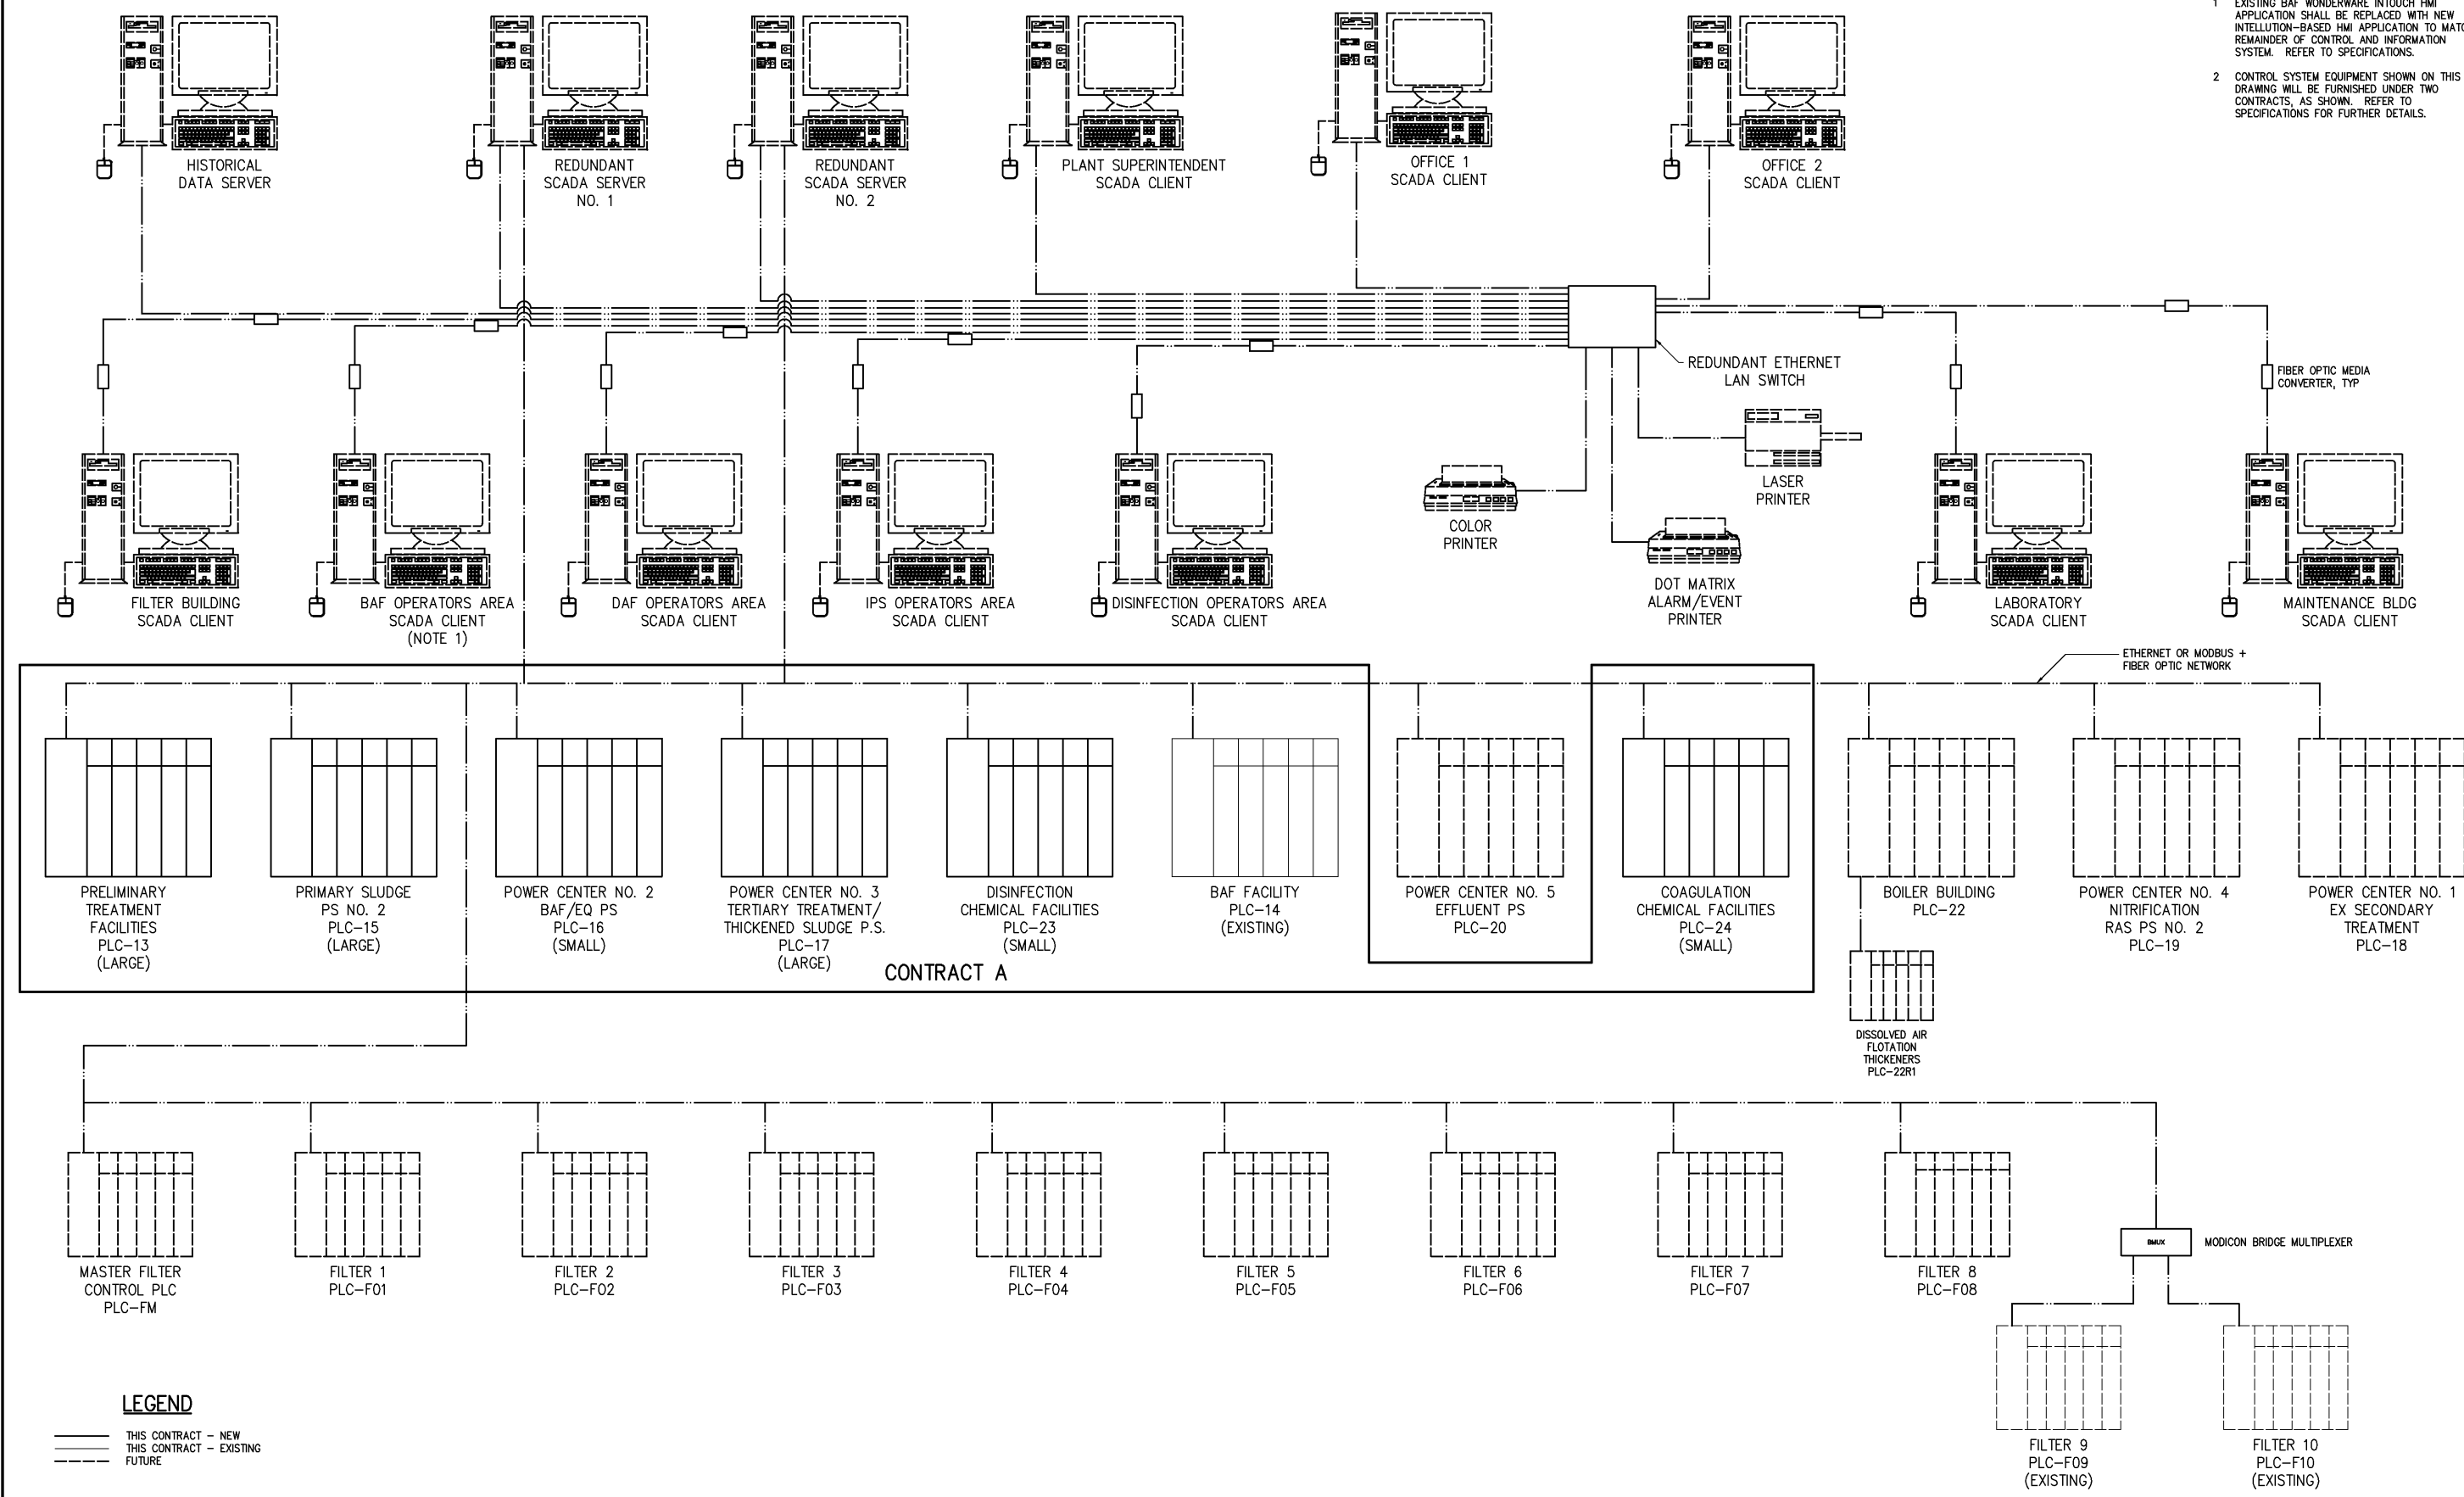

				DESIGNED _____ DBE				RECORD DRAWING				CITY OF ROANOKE VIRGINIA				THE SCALE BAR SHOWN BELOW MEASURES ONE INCH LONG ON THE ORIGINAL DRAWING.				DATE JULY 2003			
				DRAWN _____ EWN																H & S JOB NUMBER 30788A			
				CHECKED _____				THIS DRAWING HAS BEEN MODIFIED TO REFLECT FIELD CHANGES REPORTED BY THE CONTRACTOR OR ANOTHER PARTY, BUT NOT VERIFIED BY THE CERTIFYING ENGINEER. THIS DOCUMENT ORIGINALLY ISSUED AND SEALED BY DANIEL B. EDWARDS, SEAL NUMBER 024960. THIS MEDIA SHALL NOT BE CONSIDERED A CERTIFIED DOCUMENT.				HAZEN AND SAWYER Environmental Engineers & Scientists 4011 WestChase Blvd, Raleigh, North Carolina 27607				CONTROL SYSTEM BLOCK DIAGRAM				CONTRACT NUMBER A		DRAWING NUMBER 12	
				PROJ. ENGR. _____ DAN																THIS DOCUMENT ORIGINALLY ISSUED FOR CONSTRUCTION AND SEALED BY RONALD L. TAYLOR, SEAL NO. 024649		REGIONAL WATER POLLUTION CONTROL PLANT WET WEATHER IMPROVEMENTS	
NO.				ISSUED FOR _____				APPROVED _____															
				DATE _____																			
				BY _____																			
				RECORD DRAWINGS				MAR 2008				RLT											
				CONSTRUCTION				MAR 2004				RLT											
				REGULATORY APPROVAL				NOV 2003				RLT											
				PRELIMINARY DESIGN				NOV 2002				RLT											