


NOTES:
1 ALL INFLUENT PUMP STATION TAG NUMBERS ARE PRECEDED BY '10'. ALL SCREENINGS TAG NUMBERS ARE PRECEDED BY '12'.

INTERLOCK LEGEND:
1 OPEN SPRAY WATER VALVE WHEN SCREEN IS RUNNING.
2 SUSPEND SCREENINGS PRODUCTION FOR AN ADJUSTABLE TIME PERIOD TO ALLOW FOR DUMPSTER CHANGE.

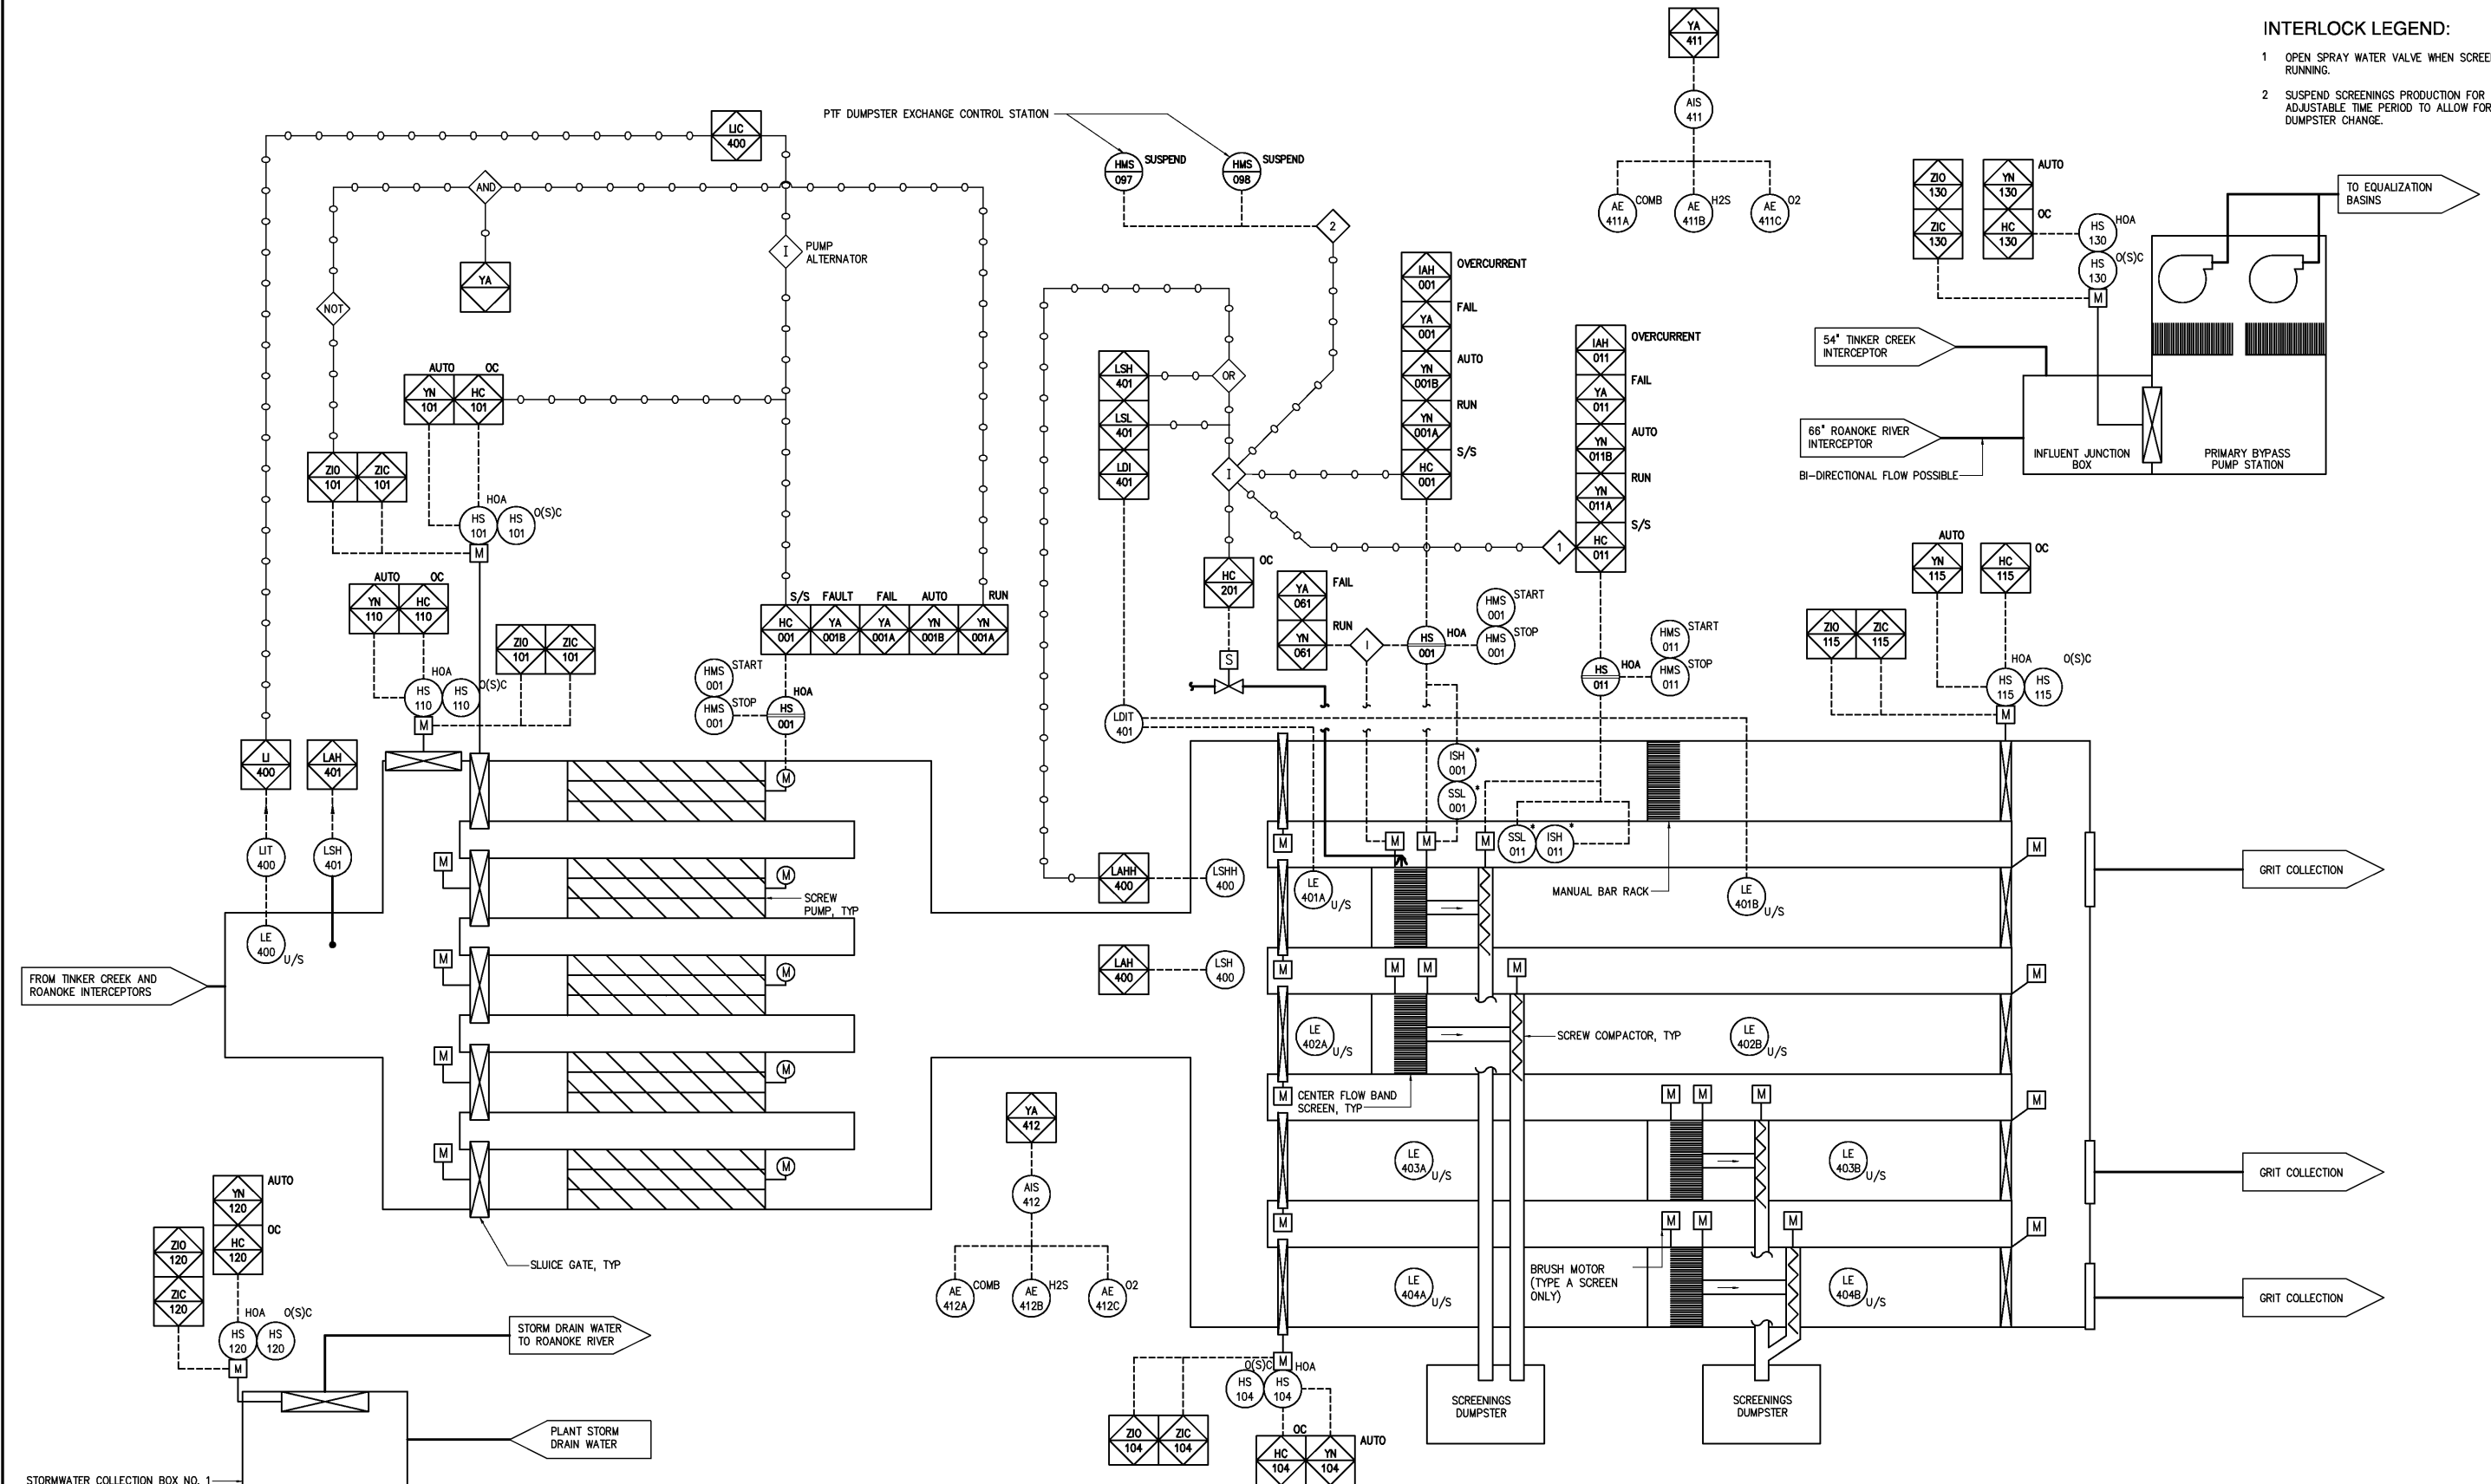

				DESIGNED DBE		RECORD DRAWING		CITY OF ROANOKE VIRGINIA		INSTRUMENTATION AND CONTROL		THE SCALE BAR SHOWN BELOW MEASURES ONE INCH LONG ON THE ORIGINAL DRAWING.		DATE JUL	
				DRAWN JAD		THIS DOCUMENT ORIGINALLY ISSUED FOR CONSTRUCTION AND SEALED BY ROBERT S. DIFIORE, SEAL NO. 22769		HAZEN AND SAWYER Environmental Engineers & Scientists 4011 WestChase Blvd, Raleigh, North Carolina 27607		INFLUENT PUMP STATION AND		H & S JOB NUMBER		CONTRACT NUMBER	
RECORD DRAWINGS				MAR 2008		RLT				SCREENING FACILITIES		DRAWING		A	
CONSTRUCTION				MAR 2004		RLT				REGIONAL WATER POLLUTION CONTROL PLANT					
REGULATORY APPROVAL				NOV 2003		RLT				WET WEATHER IMPROVEMENTS					
PRELIMINARY DESIGN				NOV 2002		RLT						PROCESS AND INSTRUMENTATION DIAGRAM			
NO.				ISSUED FOR		DATE BY		APPROVED							