


- NOTES:
- 1 TERTIARY TREATMENT FACILITIES WILL BE MODIFIED/UPGRADED DURING CONTRACT B. ALL I/O AND CONTROLS FOR THESE FACILITIES SHALL BE PROVIDED UNDER CONTRACT A, AS SPECIFIED.
- 2 ALL TERTIARY TREATMENT TAG NUMBERS ARE PRECEDED BY "56".
- INTERLOCK LEGEND:
- 1 MASTER TIMER TO ALTERNATELY CYCLE THROUGH PUMPS FOR ADJUSTABLE TIME INTERVALS. AN ADJUSTABLE OFF-CYCLE TIMER SHALL ALSO BE PROVIDED.

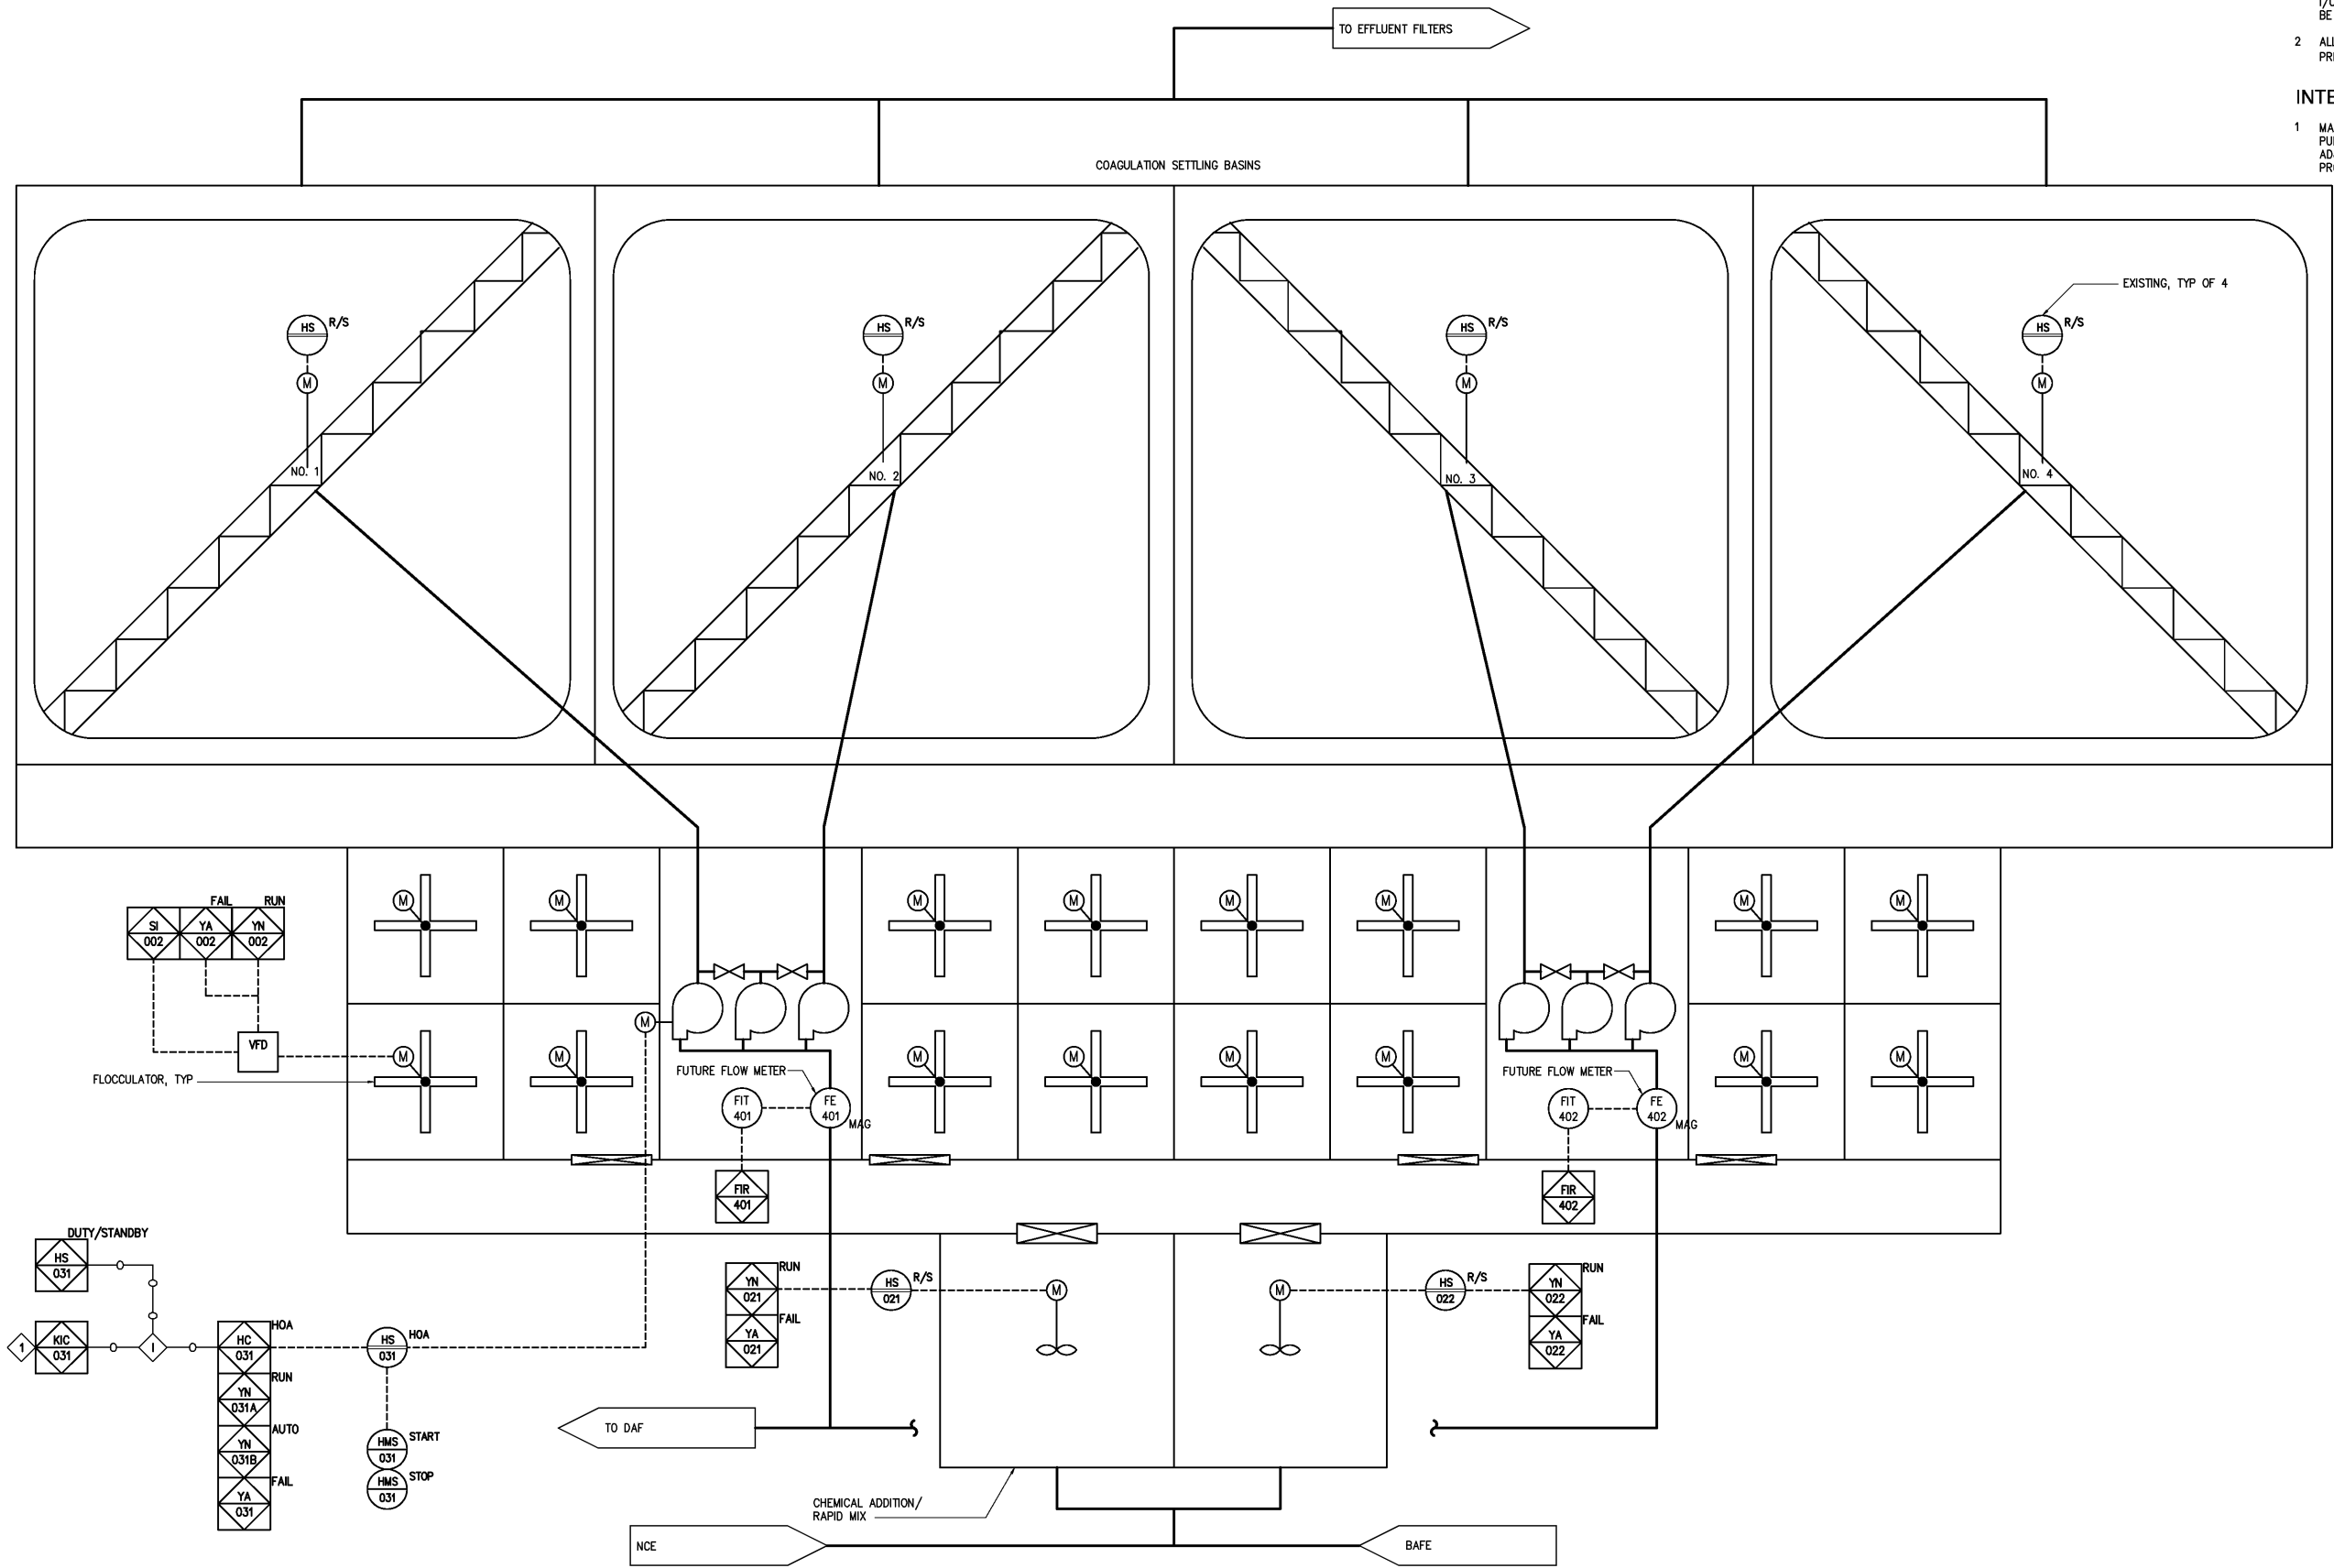

DESIGNED	DBE
DRAWN	JAD
CHECKED	
PROJ. ENGR.	DAN
APPROVED	
RECORD DRAWINGS	MAR 2008
CONSTRUCTION	MAR 2004
REGULATORY APPROVAL	NOV 2003
PRELIMINARY DESIGN	NOV 2002
ISSUED FOR	DATE
NO.	BY

THIS DOCUMENT ORIGINALLY ISSUED FOR CONSTRUCTION AND SEALED BY ROBERT S. DIFIORE, SEAL NO. 22769

THIS DOCUMENT ORIGINALLY ISSUED FOR CONSTRUCTION AND SEALED BY RONALD L. TAYLOR, SEAL NO. 024649

RECORD DRAWING

THIS DRAWING HAS BEEN MODIFIED TO REFLECT FIELD CHANGES REPORTED BY THE CONTRACTOR OR ANOTHER PARTY, BUT NOT VERIFIED BY THE CERTIFYING ENGINEER. THIS DOCUMENT ORIGINALLY ISSUED AND SEALED BY DANIEL B. EDWARDS, SEAL NUMBER 024980. THIS MEDIA SHALL NOT BE CONSIDERED A CERTIFIED DOCUMENT.

HAZEN AND SAWYER
Environmental Engineers & Scientists
4011 WestChase Blvd, Raleigh, North Carolina 27607

CITY OF ROANOKE
VIRGINIA

REGIONAL WATER POLLUTION CONTROL PLANT
WET WEATHER IMPROVEMENTS

INSTRUMENTATION AND CONTROL
COAGULATION SETTLING BASINS
PROCESS AND INSTRUMENTATION DIAGRAM

THE SCALE BAR SHOWN BELOW MEASURES ONE INCH LONG ON THE ORIGINAL DRAWING.	DATE	JULY 2003
	H & S JOB NUMBER	30788A
	CONTRACT NUMBER	A
	DRAWING NUMBER	1560