


1 ALL DISINFECTION CHEMICAL FEED TAG NUMBERS
ARE PRECEDED BY '66'.

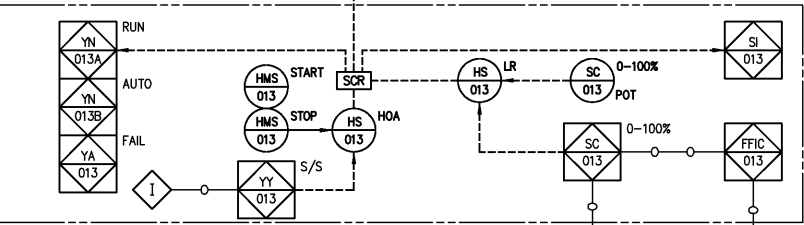

				DESIGNED	DBE
				DRAWN	EWN
				CHECKED	
	RECORD DRAWINGS	MAR 2008	RLT		
	CONSTRUCTION	MAR 2004	RLT	PROJ. ENGR.	DAN
	REGULATORY APPROVAL	NOV 2003	RLT		
	PRELIMINARY DESIGN	NOV 2002	RLT		
NO.	ISSUED FOR	DATE	BY	APPROVED	

THIS DOCUMENT ORIGINALLY ISSUED
FOR CONSTRUCTION AND SEALED BY
RONALD L. TAYLOR, SEAL NO. 024649

THIS DRAWING HAS BEEN MODIFIED TO REFLECT FIELD CHANGES REPORTED BY THE CONTRACTOR OR ANOTHER PARTY, BUT NOT VERIFIED BY THE CERTIFYING ENGINEER. THIS DOCUMENT ORIGINALLY ISSUED AND SEALED BY DANIEL B. EDWARDS, SEAL NUMBER 024960. THIS MEDIA SHALL NOT BE CONSIDERED A CERTIFIED DOCUMENT.

4011 WestChase Blvd, Raleigh, North Carolina 27607

REGIONAL WATER POLLUTION CONTROL PLANT WET WEATHER IMPROVEMENTS

DISINFECTION CHEMICAL FEED FACILITIES
SODIUM HYPOCHLORITE
PROCESS AND INSTRUMENTATION DIAGRAM

THE SCALE BAR SHOWN BELOW MEASURES ONE INCH LONG ON THE ORIGINAL DRAWING.	DATE JULY 2003	
	H & S JOB NUMBER 30788A	
	CONTRACT NUMBER A	DRAWING NUMBER 1660