


CITY OF ROANOKE, VIRGINIA




REGIONAL WATER POLLUTION CONTROL PLANT  
CONTRACT B - PROCESS TRAIN IMPROVEMENTS

SRF PROJECT NO. C-515294  
CITY PROJECT NO. 6521  
BID NO. 04-01-04  
MARCH 2004

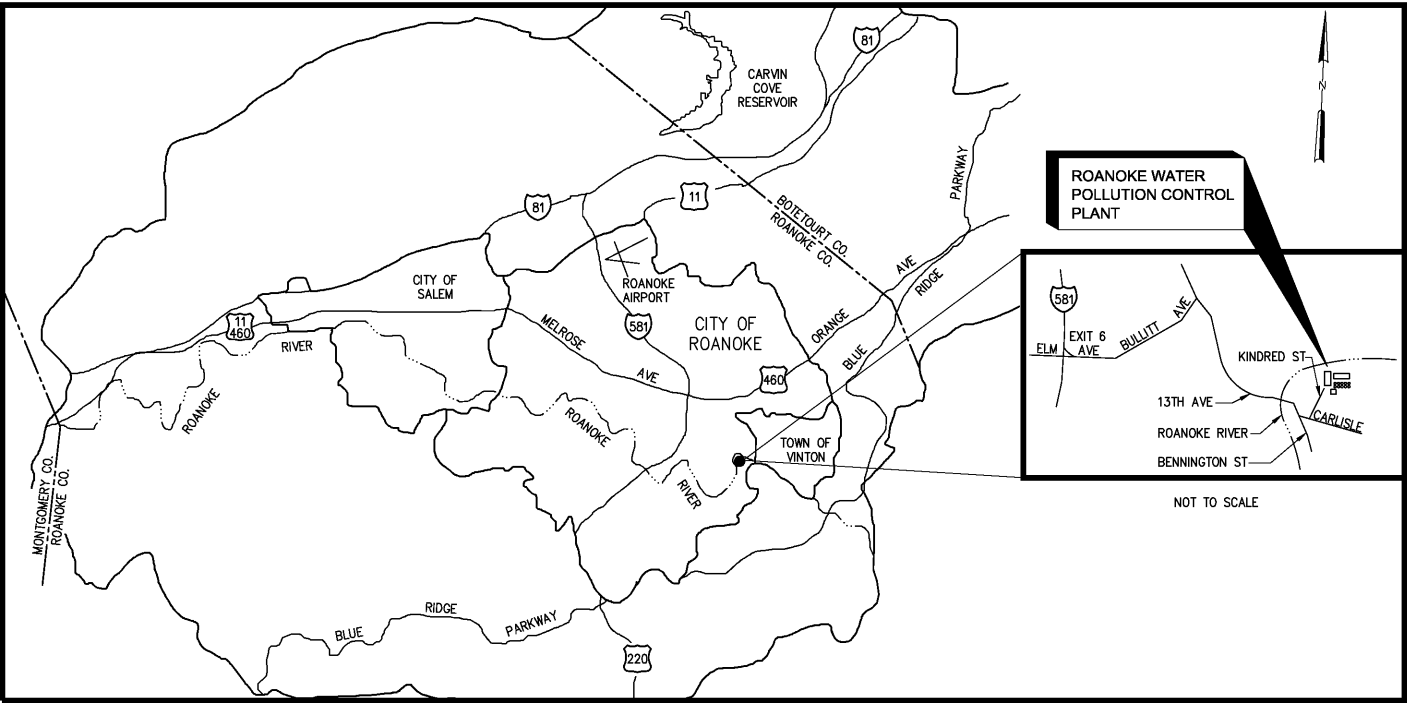

LOCATION PLAN

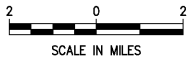

**HAZEN AND SAWYER**  
Environmental Engineers & Scientists  
4011 WestChase Blvd, Raleigh, North Carolina 27607



**RECORD DRAWING**  
THIS DRAWING HAS BEEN MODIFIED TO  
REFLECT FIELD CHANGES REPORTED BY  
THE CONTRACTOR OR ANOTHER PARTY,  
BUT NOT VERIFIED BY THE CERTIFYING  
ENGINEER

THIS DOCUMENT ORIGINALLY ISSUED  
FOR CONSTRUCTION AND SEALED BY  
ROBERT S. DIFIORE, SEAL 22769  
THIS DOCUMENT ORIGINALLY ISSUED  
FOR CONSTRUCTION AND SEALED BY  
RONALD L. TAYLOR, SEAL 24649