


- NOTES**
- SEE NOTES ON DRAWING G2.
 - NEW ASPHALT PAVEMENT. REMOVAL OF EXISTING PAVEMENT SHALL BE TO SUBGRADE.
 - CONTRACTOR SHALL CONSTRUCT MODULAR CONCRETE RETAINING WALL IN LOCATION SHOWN ON CONTRACT DRAWING PER SPECIFICATION 13100. CONTRACTOR SHALL SUBMIT SHOP DRAWINGS TO ENGINEER FOR APPROVAL PRIOR TO CONSTRUCTION OF WALL. APPROXIMATE LENGTH OF WALL IS 60 FEET, SEE DRAWING S741 FOR WALL SECTION.

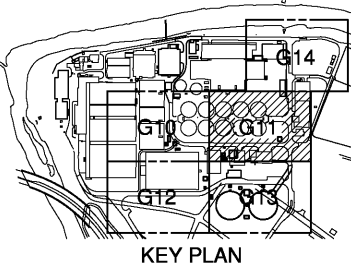

3	AS BUILT	OCT 2007	RLT
2	CONSTRUCTION	MAR 2004	RLT
1	REGULATORY APPROVAL	NOV 2003	RLT
NO.	ISSUED FOR	DATE	BY

DESIGNED	DAN
DRAWN	RWB
CHECKED	
PROJ. ENGR.	DAN
APPROVED	

RECORD DRAWING

THIS DOCUMENT ORIGINALLY ISSUED FOR CONSTRUCTION AND SEALED BY ROBERT S. DIFIORE, SEAL NO. 22769

THIS DRAWING HAS BEEN MODIFIED TO REFLECT FIELD CHANGES REPORTED BY THE CONTRACTOR OR ANOTHER PARTY, BUT NOT VERIFIED BY THE CERTIFYING ENGINEER. THIS DOCUMENT ORIGINALLY ISSUED AND SEALED BY DAVID A. NAILOR, 025465. THIS MEDIA SHALL NOT BE CONSIDERED A CERTIFIED DOCUMENT.

HAZEN AND SAWYER
Environmental Engineers & Scientists
4011 WestChase Blvd, Raleigh, North Carolina 27607

CITY OF ROANOKE
VIRGINIA

REGIONAL WATER POLLUTION CONTROL PLANT
PROCESS TRAIN IMPROVEMENTS

SITE PLAN
GENERAL
PARTIAL SITE PLAN 2

THE SCALE BAR SHOWN BELOW MEASURES ONE INCH LONG ON THE ORIGINAL DRAWING.	DATE	MARCH 2004
	H & S JOB NUMBER	30788B
	CONTRACT NUMBER	B
	DRAWING NUMBER	G11