
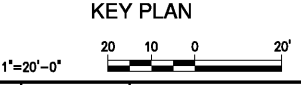


- NOTES**
- 1 SEE NOTES ON DRAWING G2.
 - 2 SEE DRAWING S880 FOR DETAILS OF POWER CENTER SLAB.
 - 3 HATCHED AREA SHALL BE LINED WITH STRAW WITH NET LINING WITH A MINIMUM SHEAR STRESS OF 1.5 LB/SF. LINING SHALL MEET REQUIREMENTS IN SPECIFICATION 02276 - EROSION AND SEDIMENTATION CONTROL.
- OUTLET PROTECTION
7'W x 12'L x 2' THICK
CLASS A1 STONE
- HEADWALL
INV 907.00

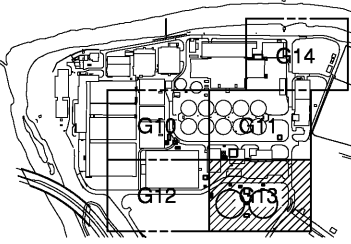

<div><div>3</div><div>2</div><div>1</div><div>NO.</div></div> <div><div>AS BUILT</div><div>CONSTRUCTION</div><div>REGULATORY APPROVAL</div><div>ISSUED FOR</div></div> <div><div>OCT 2007</div><div>MAR 2004</div><div>NOV 2003</div><div>DATE</div></div> <div><div>RLT</div><div>RLT</div><div>RLT</div><div>BY</div></div>	<div><div>DESIGNED</div><div>DRAWN</div><div>CHECKED</div><div>PROJ. ENGR.</div><div>APPROVED</div></div> <div><div>DAN</div><div>RWB</div><div></div><div>DAN</div><div></div></div>	<div>THIS DOCUMENT ORIGINALLY ISSUED FOR CONSTRUCTION AND SEALED BY ROBERT S. DIFIORE, SEAL NO. 22769</div> <div>THIS DOCUMENT ORIGINALLY ISSUED FOR CONSTRUCTION AND SEALED BY RONALD L. TAYLOR, SEAL NO. 024649</div>	<div>RECORD DRAWING</div> <div>THIS DRAWING HAS BEEN MODIFIED TO REFLECT FIELD CHANGES REPORTED BY THE CONTRACTOR OR ANOTHER PARTY, BUT NOT VERIFIED BY THE CERTIFYING ENGINEER. THIS DOCUMENT ORIGINALLY ISSUED AND SEALED BY DAVID A. NAILOR, 025465. THIS MEDIA SHALL NOT BE CONSIDERED A CERTIFIED DOCUMENT.</div>	<div><div>HAZEN AND SAWYER</div><div>Environmental Engineers & Scientists</div><div>4011 WestChase Blvd, Raleigh, North Carolina 27607</div></div>	<div><div>CITY OF ROANOKE</div><div>VIRGINIA</div><div>REGIONAL WATER POLLUTION CONTROL PLANT</div><div>PROCESS TRAIN IMPROVEMENTS</div></div>	<div><div>SITE PLAN</div><div>GENERAL</div><div>PARTIAL SITE PLAN 4</div></div>	<div>THE SCALE BAR SHOWN BELOW MEASURES ONE INCH LONG ON THE ORIGINAL DRAWING.</div> <div>DATE MARCH 2004</div> <div>H & S JOB NUMBER 30788B</div> <div>CONTRACT NUMBER B</div> <div>DRAWING NUMBER G13</div>
---	---	---	--	--	--	---	---