


NOTES

- 1 SEE NOTES ON DRAWING G2.
- 2 NEW ASPHALT PAVEMENT. REMOVAL OF EXISTING PAVEMENT SHALL BE TO SUBGRADE.
- 3 AGGREGATE BASE COURSE FOR ROAD WILL BE INSTALLED UNDER CONTRACT A. CONTRACT B CONTRACTOR SHALL VERIFY THICKNESS OF AGGREGATE BASE COURSE, GRADE AS REQUIRED TO ACHIEVE APPROPRIATE FINISHED GRADE, COMPACT AGGREGATE BASE COURSE AS REQUIRED BY THE SPECIFICATIONS, AND SHALL PROVIDE BINDER AND SURFACE COURSE AS SHOWN ON DETAIL 0251000.

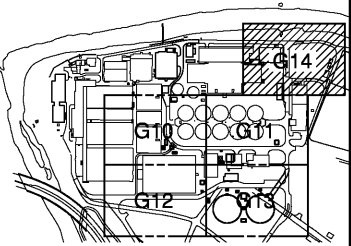

KEY PLAN

1"=20'-0"

				DESIGNED	DAN
				DRAWN	RWB
				CHECKED	
3	AS BUILT	OCT 2007	RLT	PROJ. ENGR.	DAN
2	CONSTRUCTION	MAR 2004	RLT		
1	REGULATORY APPROVAL	NOV 2003	RLT		
NO.	ISSUED FOR	DATE	BY	APPROVED	

THIS DOCUMENT ORIGINALLY ISSUED FOR CONSTRUCTION AND SEALED BY ROBERT S. DIFIORE, SEAL NO. 22769

THIS DOCUMENT ORIGINALLY ISSUED FOR CONSTRUCTION AND SEALED BY RONALD L. TAYLOR, SEAL NO. 024649

RECORD DRAWING

THIS DRAWING HAS BEEN MODIFIED TO REFLECT FIELD CHANGES REPORTED BY THE CONTRACTOR OR ANOTHER PARTY, BUT NOT VERIFIED BY THE CERTIFYING ENGINEER. THIS DOCUMENT ORIGINALLY ISSUED AND SEALED BY DAVID A. NAILOR, 025465. THIS MEDIA SHALL NOT BE CONSIDERED A CERTIFIED DOCUMENT.

**HAZEN AND SAWYER**  
Environmental Engineers & Scientists  
4011 WestChase Blvd, Raleigh, North Carolina 27607

CITY OF ROANOKE  
VIRGINIA

REGIONAL WATER POLLUTION CONTROL PLANT  
PROCESS TRAIN IMPROVEMENTS

SITE PLAN  
GENERAL  
PARTIAL SITE PLAN 5

THE SCALE BAR SHOWN BELOW MEASURES ONE INCH LONG ON THE ORIGINAL DRAWING.	DATE	MARCH 2004
	H & S JOB NUMBER	30788B
	CONTRACT NUMBER	B
	DRAWING NUMBER	G14