

MATCHLINE - SEE DRAWING G24

NOTES:

- 1 EXISTING STEAM PIPING INSULATION MAY CONTAIN ASBESTOS MATERIALS. DEMOLITION OF INSULATION SHALL COMPLY WITH ALL FEDERAL, NATIONAL, STATE AND LOCAL REGULATIONS.

1" HOCL IN 4"
CASING PIPE —

HANDHOLE

SECONDARY
ANAEROBIC
DIGESTER A

SECONDARY ANAEROBIC DIGESTER B

PRIMARY ANAEROBIC DIGESTER NO 6

SECONDARY ANAEROBIC DIGESTER C

BIOLOGICAL AERATED FILTERS

PRIMARY
ANAEROBIC
DIGESTER
NO 3

PRIMARY ANAEROBIC DIGESTER NO 4

PRIMARY ANAEROBIC DIGESTER NO 5

PRIMARY ANAEROBIC DIGESTER NO 7

8" SLUDGE

8" SLUDGE

SLUDGE

MAINTENANCE BUILDING


LEGEND



TO BE DEMOLISHED



TO BE ABANDONED IN PLACE

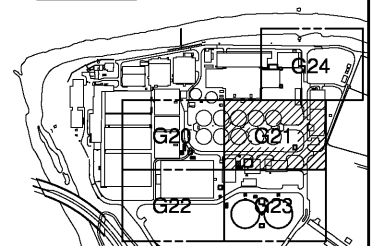

KEY PLAN

$$1^{\circ} = 20' - 0^{\circ}$$

DAF THICKENERS

MATCHLINE - SEE DRAWING G23

					DESIGNED	DAN
					DRAWN	RWB
					CHECKED	
3	AS BUILT	OCT 2007	RLT		PROJ. ENGR.	DAN
2	CONSTRUCTION	MAR 2004	RLT			
1	REGULATORY APPROVAL	NOV 2003	RLT			
NO.	ISSUED FOR	DATE	BY		APPROVED	

THIS DOCUMENT ORIGINALLY ISSUED
FOR CONSTRUCTION AND SEALED BY
ROBERT S. DIFIORE, SEAL NO. 22769

RECORD DRAWING

THIS DRAWING HAS BEEN MODIFIED TO REFLECT FIELD CHANGES REPORTED BY THE CONTRACTOR OR ANOTHER PARTY, BUT NOT VERIFIED BY THE CERTIFYING ENGINEER. THIS DOCUMENT ORIGINALLY ISSUED AND SEALED BY DAVID A. NAILOR, 025465. THIS MEDIA SHALL NOT BE CONSIDERED A CERTIFIED DOCUMENT.

THIS DOCUMENT ORIGINALLY ISSUED
FOR CONSTRUCTION AND SEALED BY
RONALD L. TAYLOR, SEAL NO. 024649

HAZEN AND SAWYER
Environmental Engineers & Scientists
4011 WestChase Blvd, Raleigh, North Carolina 27607

CITY OF ROANOKE
VIRGINIA

REGIONAL WATER POLLUTION CONTROL PLANT PROCESS TRAIN IMPROVEMENTS

PARTIAL SITE PLAN
GENERAL
DEMOLITION

THE SCALE BAR SHOWN BELOW MEASURES ONE INCH LONG ON THE ORIGINAL DRAWING.	DATE MARCH 2004	
	H & S JOB NUMBER 30788B	
	CONTRACT NUMBER B	DRAWING NUMBER G21