
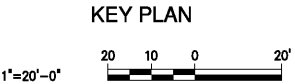


- NOTES:
- 1 REMOVE ABANDONED STEAM PIPING AS REQUIRED IN WAY OF NEW PIPING. EXISTING STEAM PIPING INSULATION MAY CONTAIN ASBESTOS MATERIALS. DEMOLITION OF INSULATION SHALL COMPLY WITH ALL FEDERAL, NATIONAL, STATE AND LOCAL REGULATIONS.

LEGEND

TO BE DEMOLISHED

TO BE ABANDONED IN PLACE

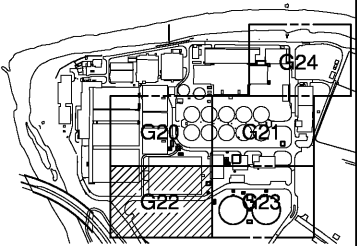

				DESIGNED	DAN	<p>THIS DOCUMENT ORIGINALLY ISSUED FOR CONSTRUCTION AND SEALED BY ROBERT S. DIFIORE, SEAL NO. 22769</p> <p>RECORD DRAWING</p> <p>THIS DRAWING HAS BEEN MODIFIED TO REFLECT FIELD CHANGES REPORTED BY THE CONTRACTOR OR ANOTHER PARTY, BUT NOT VERIFIED BY THE CERTIFYING ENGINEER. THIS DOCUMENT ORIGINALLY ISSUED AND SEALED BY DAVID A. NAILOR, 025465. THIS MEDIA SHALL NOT BE CONSIDERED A CERTIFIED DOCUMENT.</p>	<p>HAZEN AND SAWYER</p> <p>Environmental Engineers & Scientists</p> <p>4011 WestChase Blvd, Raleigh, North Carolina 27607</p>	<p>CITY OF ROANOKE</p> <p>VIRGINIA</p> <p>REGIONAL WATER POLLUTION CONTROL PLANT</p> <p>PROCESS TRAIN IMPROVEMENTS</p>	<p>PARTIAL SITE PLAN</p> <p>GENERAL</p> <p>DEMOLITION</p>	<p>THE SCALE BAR SHOWN BELOW MEASURES ONE INCH LONG ON THE ORIGINAL DRAWING.</p> <p>DATE</p> <p>MARCH 2004</p> <table><tr><td>H & S JOB NUMBER</td><td>30788B</td></tr><tr><td>CONTRACT NUMBER</td><td>DRAWING NUMBER</td></tr><tr><td>B</td><td>G22</td></tr></table>	H & S JOB NUMBER	30788B	CONTRACT NUMBER	DRAWING NUMBER	B	G22
H & S JOB NUMBER	30788B															
CONTRACT NUMBER	DRAWING NUMBER															
B	G22															
				DRAWN	RWB											
				CHECKED												
3	AS BUILT	OCT 2007	RLT	PROJ. ENGR.	DAN											
2	CONSTRUCTION	MAR 2004	RLT													
1	REGULATORY APPROVAL	NOV 2003	RLT													
NO.	ISSUED FOR	DATE	BY	APPROVED												