
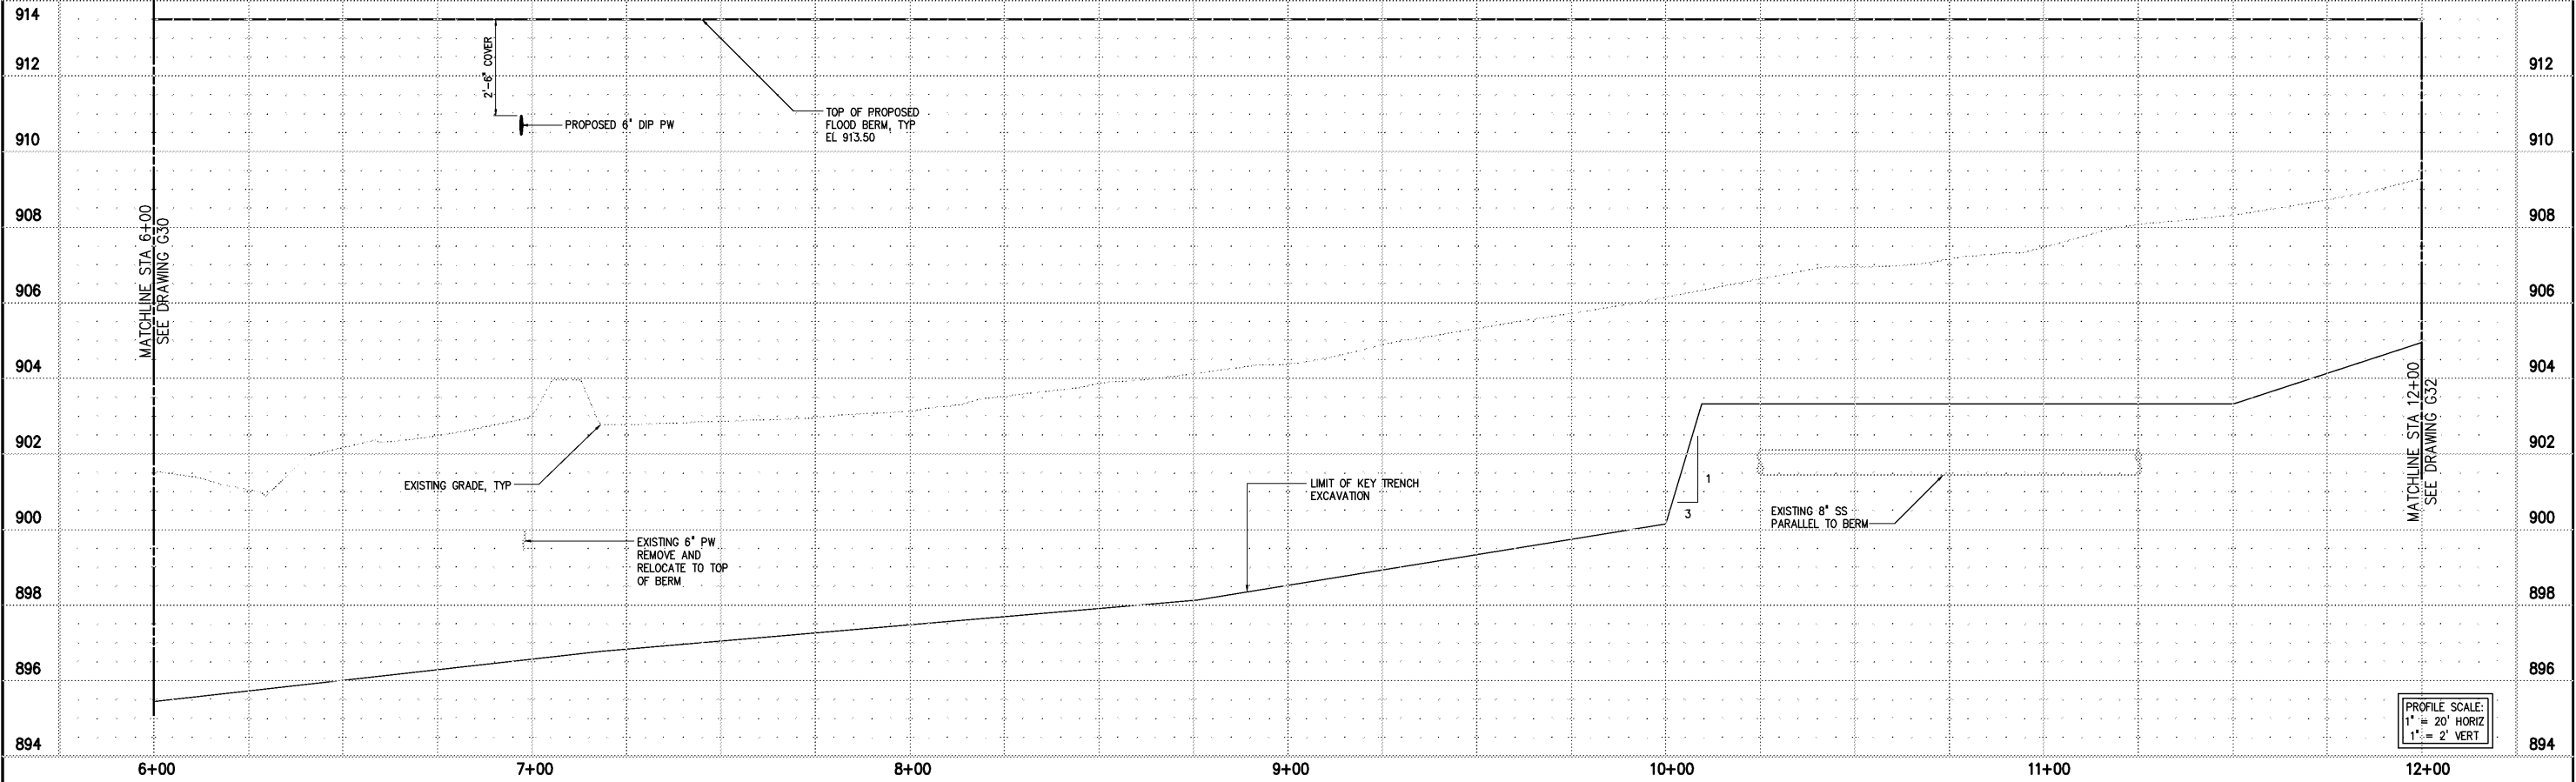


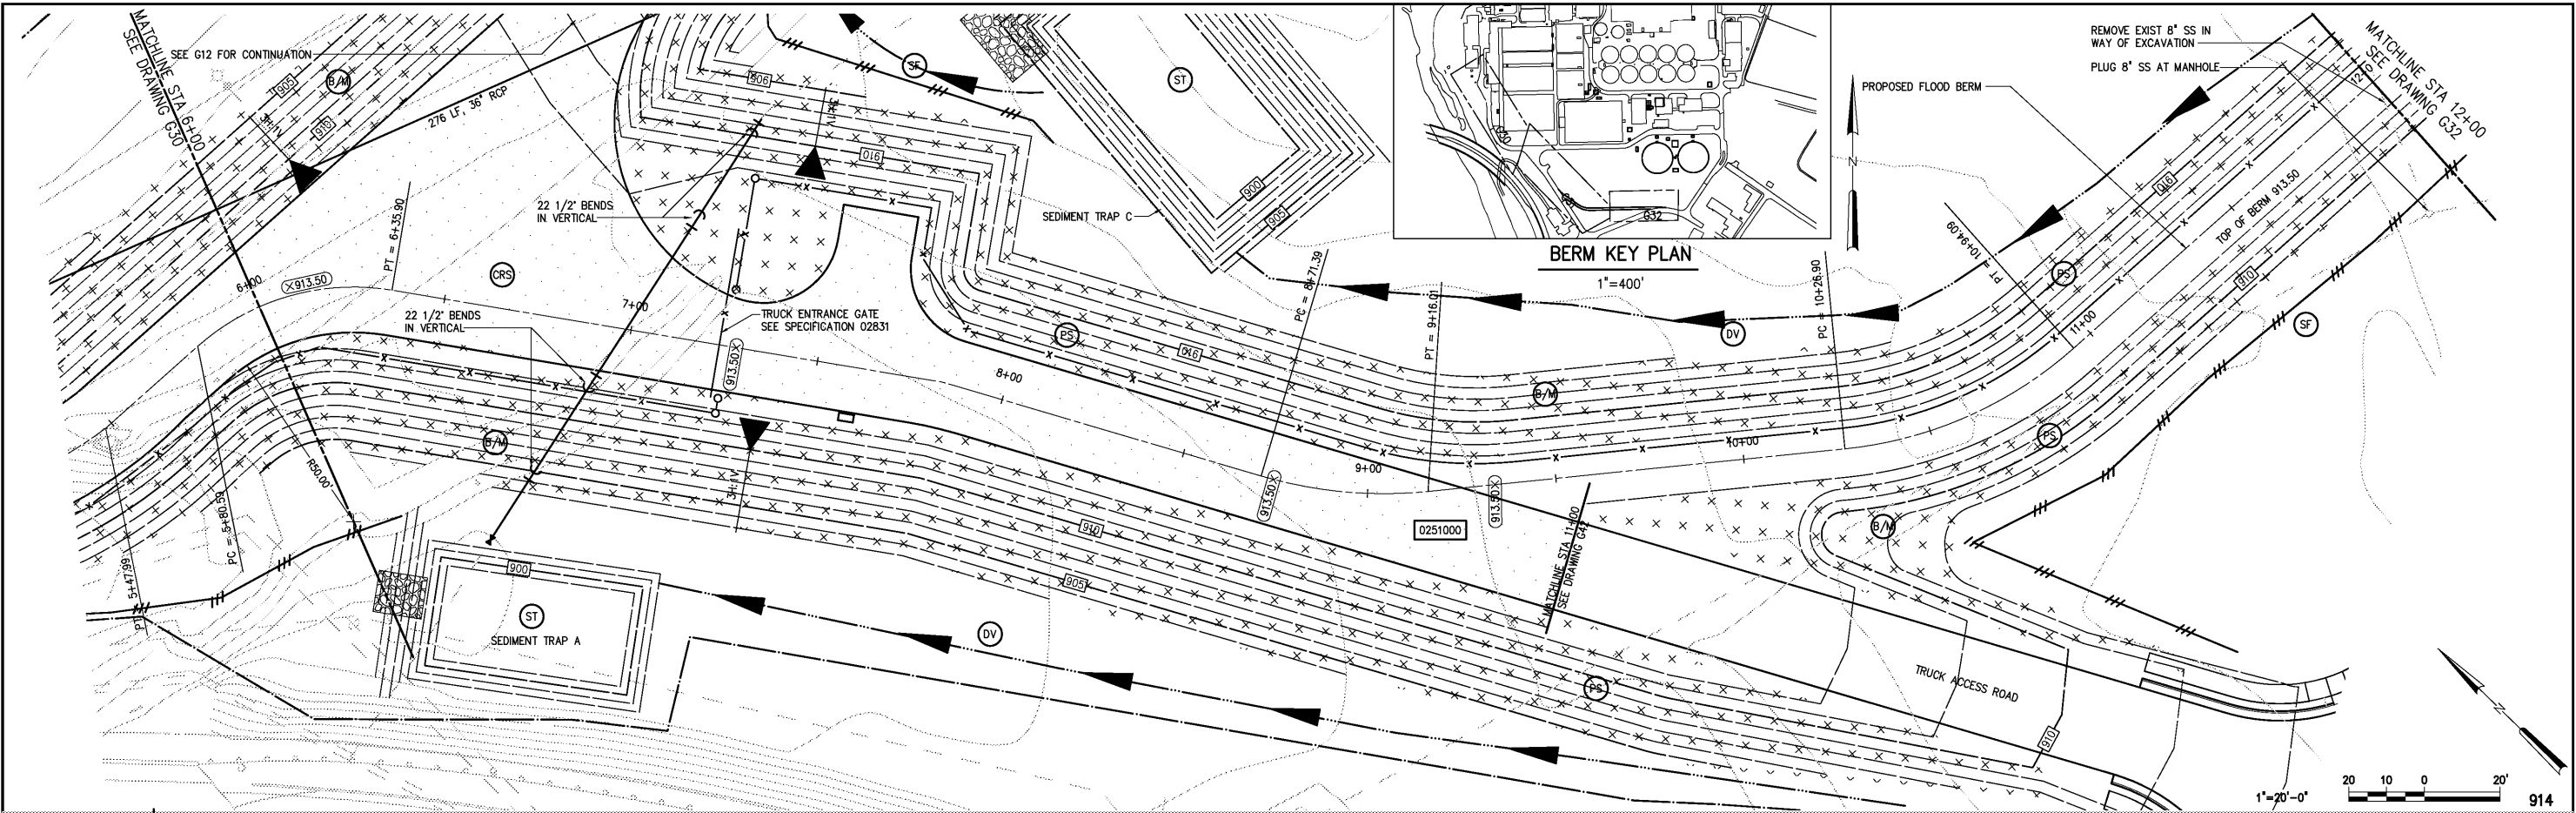

|                     |  |  |  |                                                                                                                                                                                                                                                                                   |  |                                                                                                                |  |                                     |  |                         |  |
|---------------------|--|--|--|-----------------------------------------------------------------------------------------------------------------------------------------------------------------------------------------------------------------------------------------------------------------------------------|--|----------------------------------------------------------------------------------------------------------------|--|-------------------------------------|--|-------------------------|--|
| DESIGNED DAN        |  |  |  | RECORD DRAWING                                                                                                                                                                                                                                                                    |  | CITY OF ROANOKE<br>VIRGINIA                                                                                    |  | PLAN AND PROFILE                    |  | DATE MARCH 2004         |  |
| DRAWN JTC           |  |  |  | THIS DOCUMENT ORIGINALLY ISSUED FOR CONSTRUCTION AND SEALED BY ROBERT S. DIFIORE, SEAL NO. 22769                                                                                                                                                                                  |  | HAZEN AND SAWYER<br>Environmental Engineers & Scientists<br>4011 WestChase Blvd, Raleigh, North Carolina 27607 |  | GENERAL                             |  | H & S JOB NUMBER 30788B |  |
| CHECKED             |  |  |  | THIS DRAWING HAS BEEN MODIFIED TO REFLECT FIELD CHANGES REPORTED BY THE CONTRACTOR OR ANOTHER PARTY, BUT NOT VERIFIED BY THE CERTIFYING ENGINEER. THIS DOCUMENT ORIGINALLY ISSUED AND SEALED BY DAVID A. NAILOR, 025465. THIS MEDIA SHALL NOT BE CONSIDERED A CERTIFIED DOCUMENT. |  | REGIONAL WATER POLLUTION CONTROL PLANT<br>PROCESS TRAIN IMPROVEMENTS                                           |  | FLOOD PROTECTION BERM AND FLOODWALL |  | CONTRACT NUMBER B       |  |
| PROJ. ENGR. DAN     |  |  |  | THIS DOCUMENT ORIGINALLY ISSUED FOR CONSTRUCTION AND SEALED BY RONALD L. TAYLOR, SEAL NO. 024649                                                                                                                                                                                  |  |                                                                                                                |  |                                     |  | DRAWING NUMBER G31      |  |
| APPROVED            |  |  |  |                                                                                                                                                                                                                                                                                   |  |                                                                                                                |  |                                     |  |                         |  |
| NO.                 |  |  |  |                                                                                                                                                                                                                                                                                   |  |                                                                                                                |  |                                     |  |                         |  |
| ISSUED FOR          |  |  |  |                                                                                                                                                                                                                                                                                   |  |                                                                                                                |  |                                     |  |                         |  |
| DATE                |  |  |  |                                                                                                                                                                                                                                                                                   |  |                                                                                                                |  |                                     |  |                         |  |
| BY                  |  |  |  |                                                                                                                                                                                                                                                                                   |  |                                                                                                                |  |                                     |  |                         |  |
| AS BUILT            |  |  |  |                                                                                                                                                                                                                                                                                   |  |                                                                                                                |  |                                     |  |                         |  |
| CONSTRUCTION        |  |  |  |                                                                                                                                                                                                                                                                                   |  |                                                                                                                |  |                                     |  |                         |  |
| REGULATORY APPROVAL |  |  |  |                                                                                                                                                                                                                                                                                   |  |                                                                                                                |  |                                     |  |                         |  |
| OCT 2007            |  |  |  |                                                                                                                                                                                                                                                                                   |  |                                                                                                                |  |                                     |  |                         |  |
| MAR 2004            |  |  |  |                                                                                                                                                                                                                                                                                   |  |                                                                                                                |  |                                     |  |                         |  |
| NOV 2003            |  |  |  |                                                                                                                                                                                                                                                                                   |  |                                                                                                                |  |                                     |  |                         |  |
| RT                  |  |  |  |                                                                                                                                                                                                                                                                                   |  |                                                                                                                |  |                                     |  |                         |  |
| RT                  |  |  |  |                                                                                                                                                                                                                                                                                   |  |                                                                                                                |  |                                     |  |                         |  |
| BY                  |  |  |  |                                                                                                                                                                                                                                                                                   |  |                                                                                                                |  |                                     |  |                         |  |