


1 SEE NOTES ON DRAWING G2.



RIVER SIDE

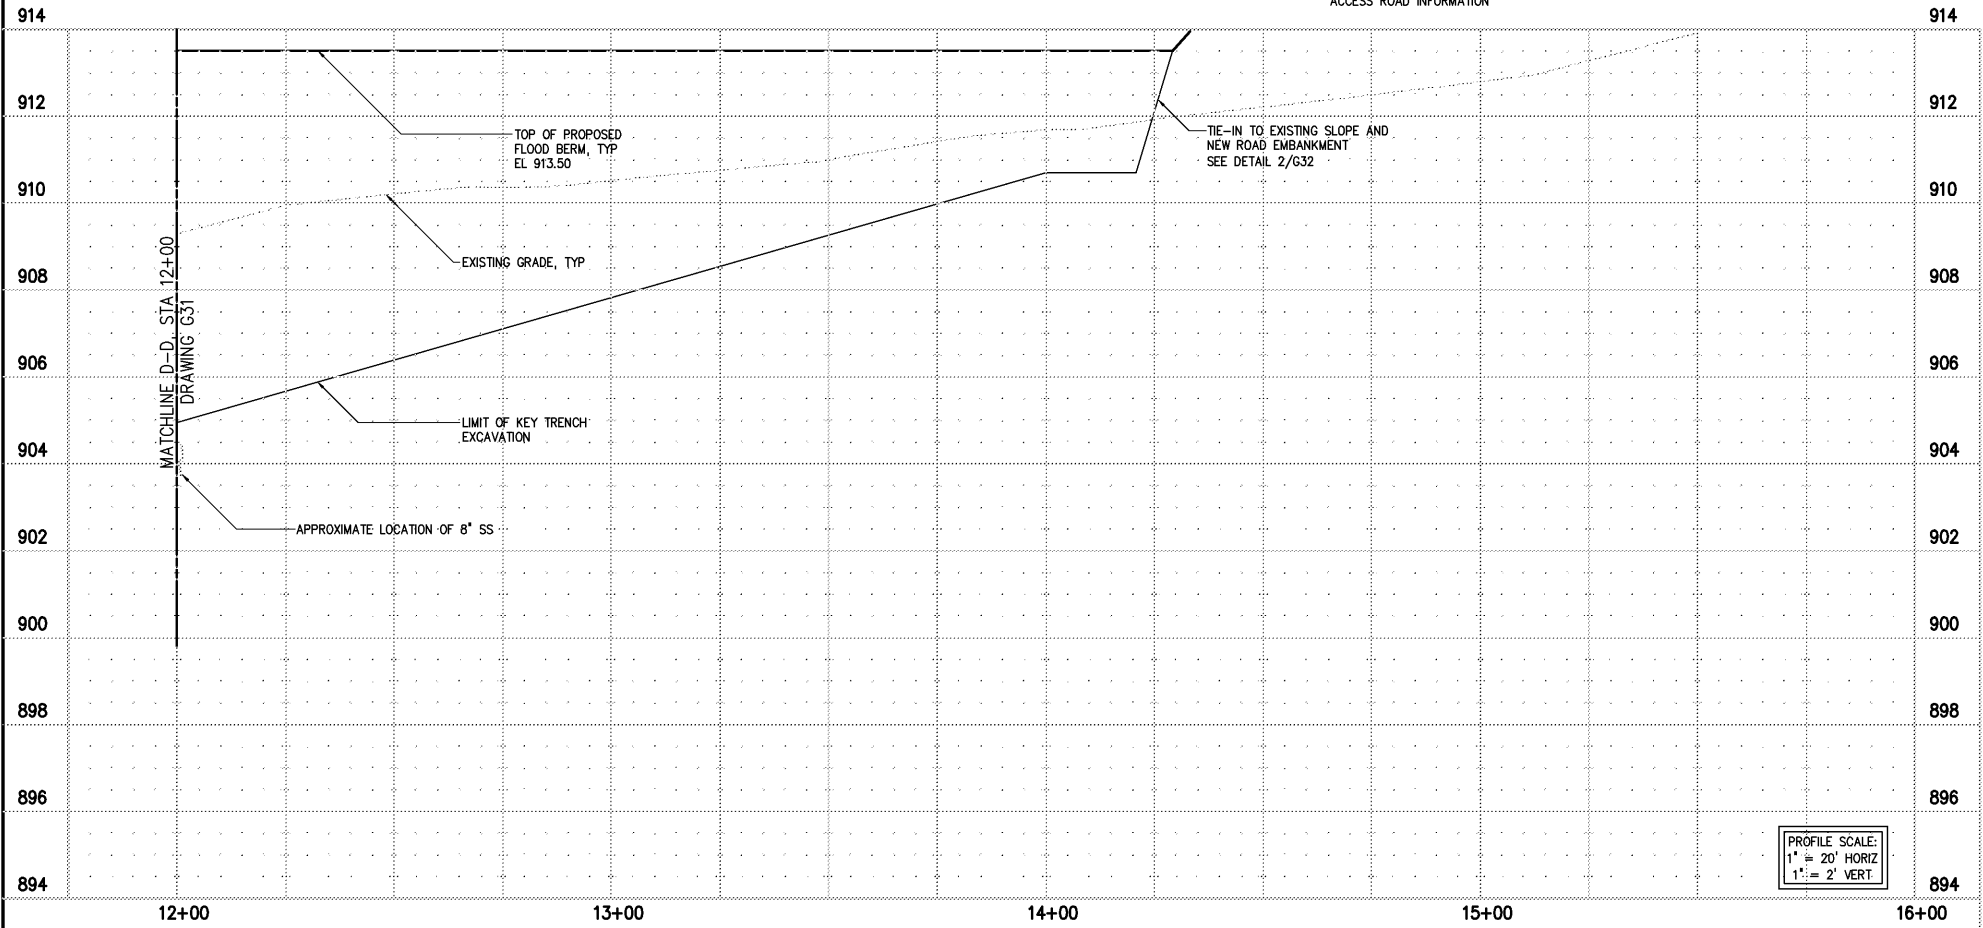

- 1 KEY BENCH SHALL BE HORIZONTAL AND TERMINATE IN SUITABLE SOILS AS OUTLINED IN SECTION 02200 - EARTHWORK OF THE SPECIFICATIONS.
- 2 SEGREGATE AND DISPOSE OF MATERIAL EXCAVATED FROM BENCH WHERE SPECIFIED.
- 3 CONSTRUCT EMBANKMENT FILL IN CONTINUOUS HORIZONTAL LIFTS.

DETAIL	2
NOT TO SCALE	G30


$$1^{\circ}=400'$$
$$1^{\circ}=20^{\circ}-0^{\circ}$$


DESIGNED _____ DAN
DRAWN _____ JTC
CHECKED _____
PROJ. ENGR. _____ DAN
APPROVED _____

THIS DOCUMENT ORIGINALLY ISSUED
FOR CONSTRUCTION AND SEALED BY
ROBERT S. DIFIORE, SEAL NO. 22769

THIS DOCUMENT ORIGINALLY ISSUED
FOR CONSTRUCTION AND SEALED BY
RONALD L. TAYLOR, SEAL NO. 024649

THIS DRAWING HAS BEEN MODIFIED TO REFLECT FIELD
CHANGES REPORTED BY THE CONTRACTOR OR ANOTHER
PARTY, BUT NOT VERIFIED BY THE CERTIFYING ENGINEER.
THIS DOCUMENT ORIGINALLY ISSUED AND SEALED BY
DAVID A. NAILOR, 025465. THIS MEDIA SHALL NOT BE
CONSIDERED A CERTIFIED DOCUMENT.

HAZEN AND SAWYER
Environmental Engineers & Scientists
4011 WestChase Blvd, Raleigh, North Carolina 27607

CITY OF ROANOKE
VIRGINIA

REGIONAL WATER POLLUTION CONTROL PLANT PROCESS TRAIN IMPROVEMENTS

PLAN AND PROFILE
GENERAL
FLOOD PROTECTION BERM AND FLOODWALL

THE SCALE BAR SHOWN BELOW MEASURES ONE INCH LONG ON THE ORIGINAL DRAWING.	DATE MARCH 2004	
	H & S JOB NUMBER 30788B	
	CONTRACT NUMBER B	DRAWING NUMBER G32