
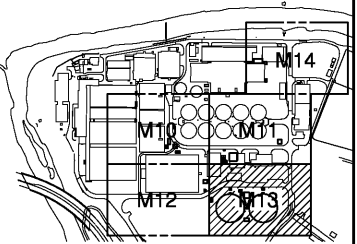 


- NOTES:**
- 1 CONTRACTOR SHALL PROVIDE ALL FITTINGS, ADAPTERS AND RESTRAINT DEVICES REQUIRED TO MAKE ALL TIE-INS BETWEEN NEW PIPING AND EXISTING PIPING AND STRUCTURES.
  - 2 CONTRACTOR SHALL EXCAVATE AND FIELD VERIFY LOCATIONS, ELEVATIONS AND PIPE MATERIALS AT ALL CONNECTIONS TO EXISTING PIPING OR STRUCTURES PRIOR TO ORDERING MATERIALS.
  - 3 UNDERGROUND CHEMICAL LINES SHALL BE BRAIDED PVC TUBING IN PVC CASING PIPE AND WILL HAVE ONE DUTY AND ONE SPARE.
  - 4 CONTRACTOR SHALL PROVIDE A MANUAL AIR RELEASE VALVE IN HANDHOLES TO RELEASE GAS-TRAPPED IN HIGH POINTS IN CHEMICAL LINES. AIR RELEASE VALVE SHALL BE PVC BALL VALVE.



3	AS BUILT	OCT 2007	RLT		
2	CONSTRUCTION	MAR 2004	RLT		
1	REGULATORY APPROVAL	NOV 2003	RLT		
NO.	ISSUED FOR	DATE	BY		

DESIGNED	DAN
DRAWN	RWB
CHECKED	
PROJ. ENGR.	DAN
APPROVED	

THIS DOCUMENT ORIGINALLY ISSUED FOR CONSTRUCTION AND SEALED BY ROBERT S. DIFIORE, SEAL NO. 22769

THIS DOCUMENT ORIGINALLY ISSUED FOR CONSTRUCTION AND SEALED BY RONALD L. TAYLOR, SEAL NO. 024649

**RECORD DRAWING**

THIS DRAWING HAS BEEN MODIFIED TO REFLECT FIELD CHANGES REPORTED BY THE CONTRACTOR OR ANOTHER PARTY, BUT NOT VERIFIED BY THE CERTIFYING ENGINEER. THIS DOCUMENT ORIGINALLY ISSUED AND SEALED BY DAVID A. NAILOR, 025465. THIS MEDIA SHALL NOT BE CONSIDERED A CERTIFIED DOCUMENT.

**HAZEN AND SAWYER**  
Environmental Engineers & Scientists  
4011 WestChase Blvd, Raleigh, North Carolina 27607

**CITY OF ROANOKE**  
VIRGINIA

**REGIONAL WATER POLLUTION CONTROL PLANT**  
PROCESS TRAIN IMPROVEMENTS

**PARTIAL SITE PLAN**  
MECHANICAL  
YARD PIPING

THE SCALE BAR SHOWN BELOW MEASURES ONE INCH LONG ON THE ORIGINAL DRAWING.	DATE MARCH 2004
H & S JOB NUMBER 30788B	CONTRACT NUMBER B
DRAWING NUMBER M13	