


SECTION H  
3/16"=1'-0" M403

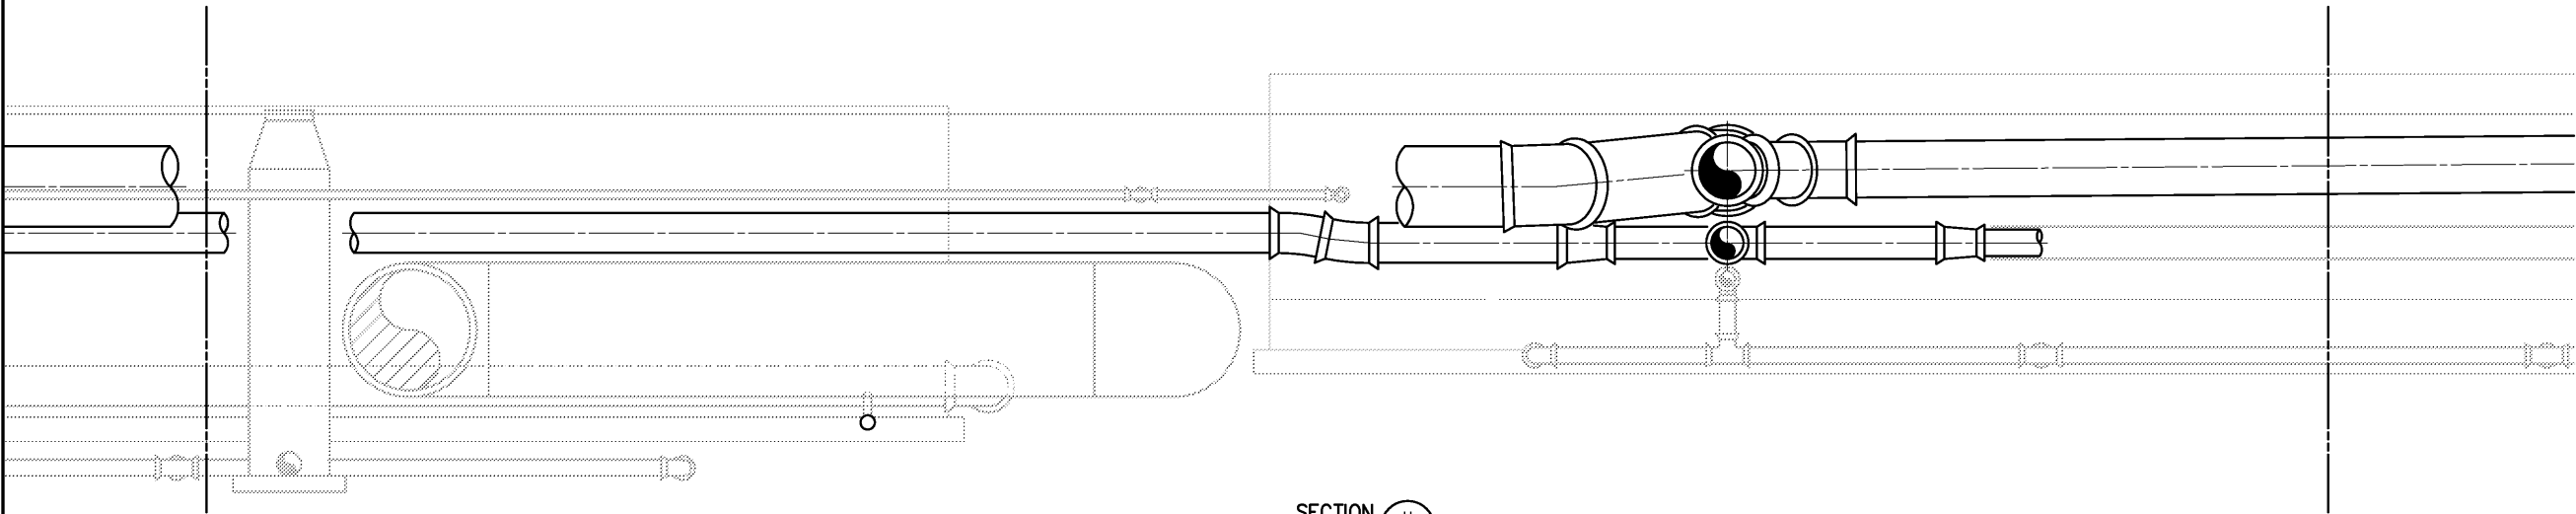

SECTION H  
3/16"=1'-0" M403

				DESIGNED	DAN	RECORD DRAWING	HAZEN AND SAWYER Environmental Engineers & Scientists 4011 WestChase Blvd, Raleigh, North Carolina 27607	CITY OF ROANOKE VIRGINIA	AERATION TANK MODIFICATIONS	MECHANICAL SECTIONS	THE SCALE BAR SHOWN BELOW MEASURES ONE INCH LONG ON THE ORIGINAL DRAWING.	DATE MARCH 2004						
				DRAWN	RWB							THIS DOCUMENT ORIGINALLY ISSUED FOR CONSTRUCTION AND SEALED BY ROBERT S. DIFIORE, SEAL NO. 22769	H & S JOB NUMBER 30788B					
				CHECKED														
3	AS BUILT	OCT 2007	R/LT	PROJ. ENGR.	DAN	THIS DOCUMENT ORIGINALLY ISSUED FOR CONSTRUCTION AND SEALED BY RONALD L. TAYLOR, SEAL NO. 024649						THIS DRAWING HAS BEEN MODIFIED TO REFLECT FIELD CHANGES REPORTED BY THE CONTRACTOR OR ANOTHER PARTY, BUT NOT VERIFIED BY THE CERTIFYING ENGINEER. THIS DOCUMENT ORIGINALLY ISSUED AND SEALED BY DAVID A. NAILOR, 025465. THIS MEDIA SHALL NOT BE CONSIDERED A CERTIFIED DOCUMENT.	REGIONAL WATER POLLUTION CONTROL PLANT PROCESS TRAIN IMPROVEMENTS				CONTRACT NUMBER B	DRAWING NUMBER M405
2	CONSTRUCTION	MAR 2004	R/LT															
1	REGULATORY APPROVAL	NOV 2003	R/LT															
NO.	ISSUED FOR	DATE	BY	APPROVED														