


NOTES:  
1. INSTALLATION OF MIXER NO 2 SHALL BE SIMILAR TO DETAILS SHOWN FOR INSTALLATION OF MIXER NO 1.

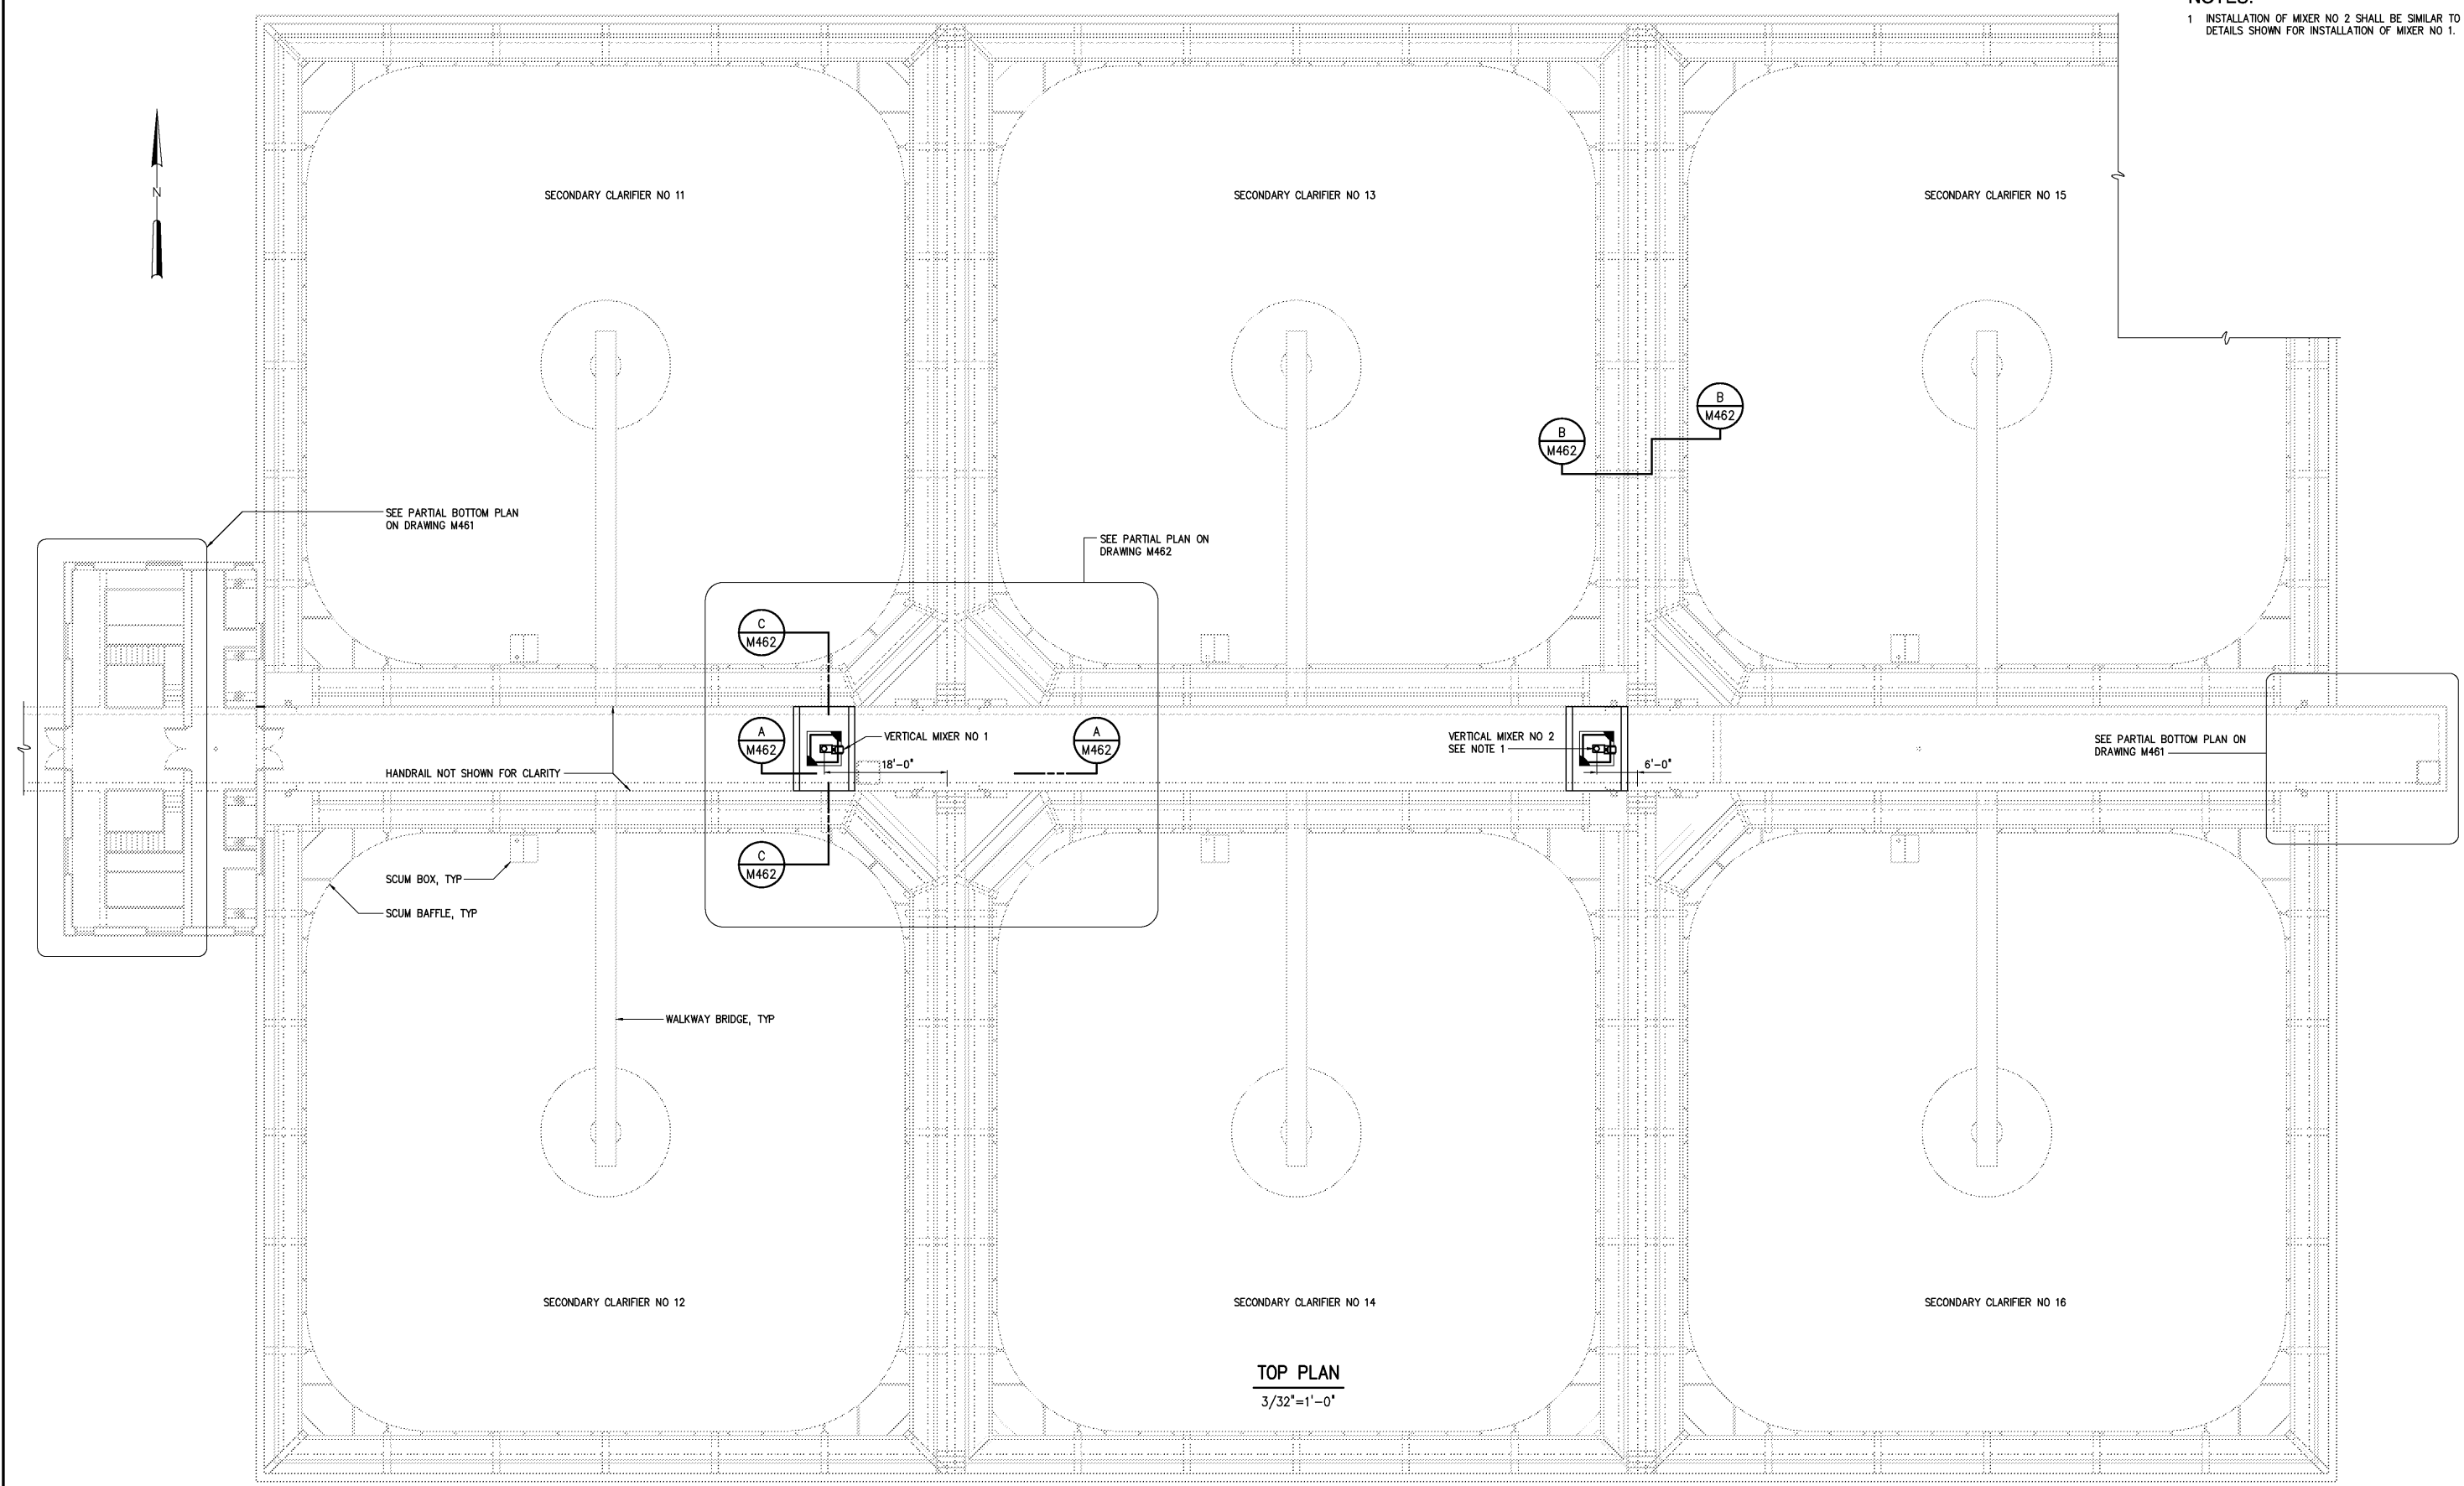

TOP PLAN  
3/32"=1'-0"

				DESIGNED	DAN	RECORD DRAWING	THIS DOCUMENT ORIGINALLY ISSUED FOR CONSTRUCTION AND SEALED BY ROBERT S. DIFIORE, SEAL NO. 22769	THIS DRAWING HAS BEEN MODIFIED TO REFLECT FIELD CHANGES REPORTED BY THE CONTRACTOR OR ANOTHER PARTY, BUT NOT VERIFIED BY THE CERTIFYING ENGINEER. THIS DOCUMENT ORIGINALLY ISSUED AND SEALED BY DAVID A. NAILOR, 025465. THIS MEDIA SHALL NOT BE CONSIDERED A CERTIFIED DOCUMENT.	HAZEN AND SAWYER Environmental Engineers & Scientists 4011 WestChase Blvd, Raleigh, North Carolina 27607	CITY OF ROANOKE VIRGINIA	REGIONAL WATER POLLUTION CONTROL PLANT PROCESS TRAIN IMPROVEMENTS	SECONDARY CLARIFIERS NO 11-16 MODIFICATIONS	THE SCALE BAR SHOWN BELOW MEASURES ONE INCH LONG ON THE ORIGINAL DRAWING.	DATE	MARCH 2004	
				DRAWN	BRC									H & S JOB NUMBER	30788B	
				CHECKED										CONTRACT NUMBER	DRAWING NUMBER	
3	AS BUILT	OCT 2007	RLT	PROJ. ENGR.	H & S									B	M460	
2	CONSTRUCTION	MAR 2004	RLT													
1	REGULATORY APPROVAL	NOV 2003	RLT													
NO.	ISSUED FOR	DATE	BY	APPROVED												