


- NOTES:
- 1 ALL EXISTING PIPING, CONDUITS, UTILITIES, ETC IN THE DAF PUMP ROOM IS NOT SHOWN ON THIS DEMOLITION PLAN. THE CONTRACTOR SHALL NOT REMOVE, DISTURB ANY EXISTING UTILITIES BEYOND THOSE SHOWN TO BE DEMOLISHED WITHOUT THE PERMISSION OF THE OWNER OR OWNER'S REPRESENTATIVE.
- 2 SEE SPECIFICATION SECTION 01520 FOR SEQUENCING OF DEMOLITION AND FOR TEMPORARY PIPING REQUIREMENTS.

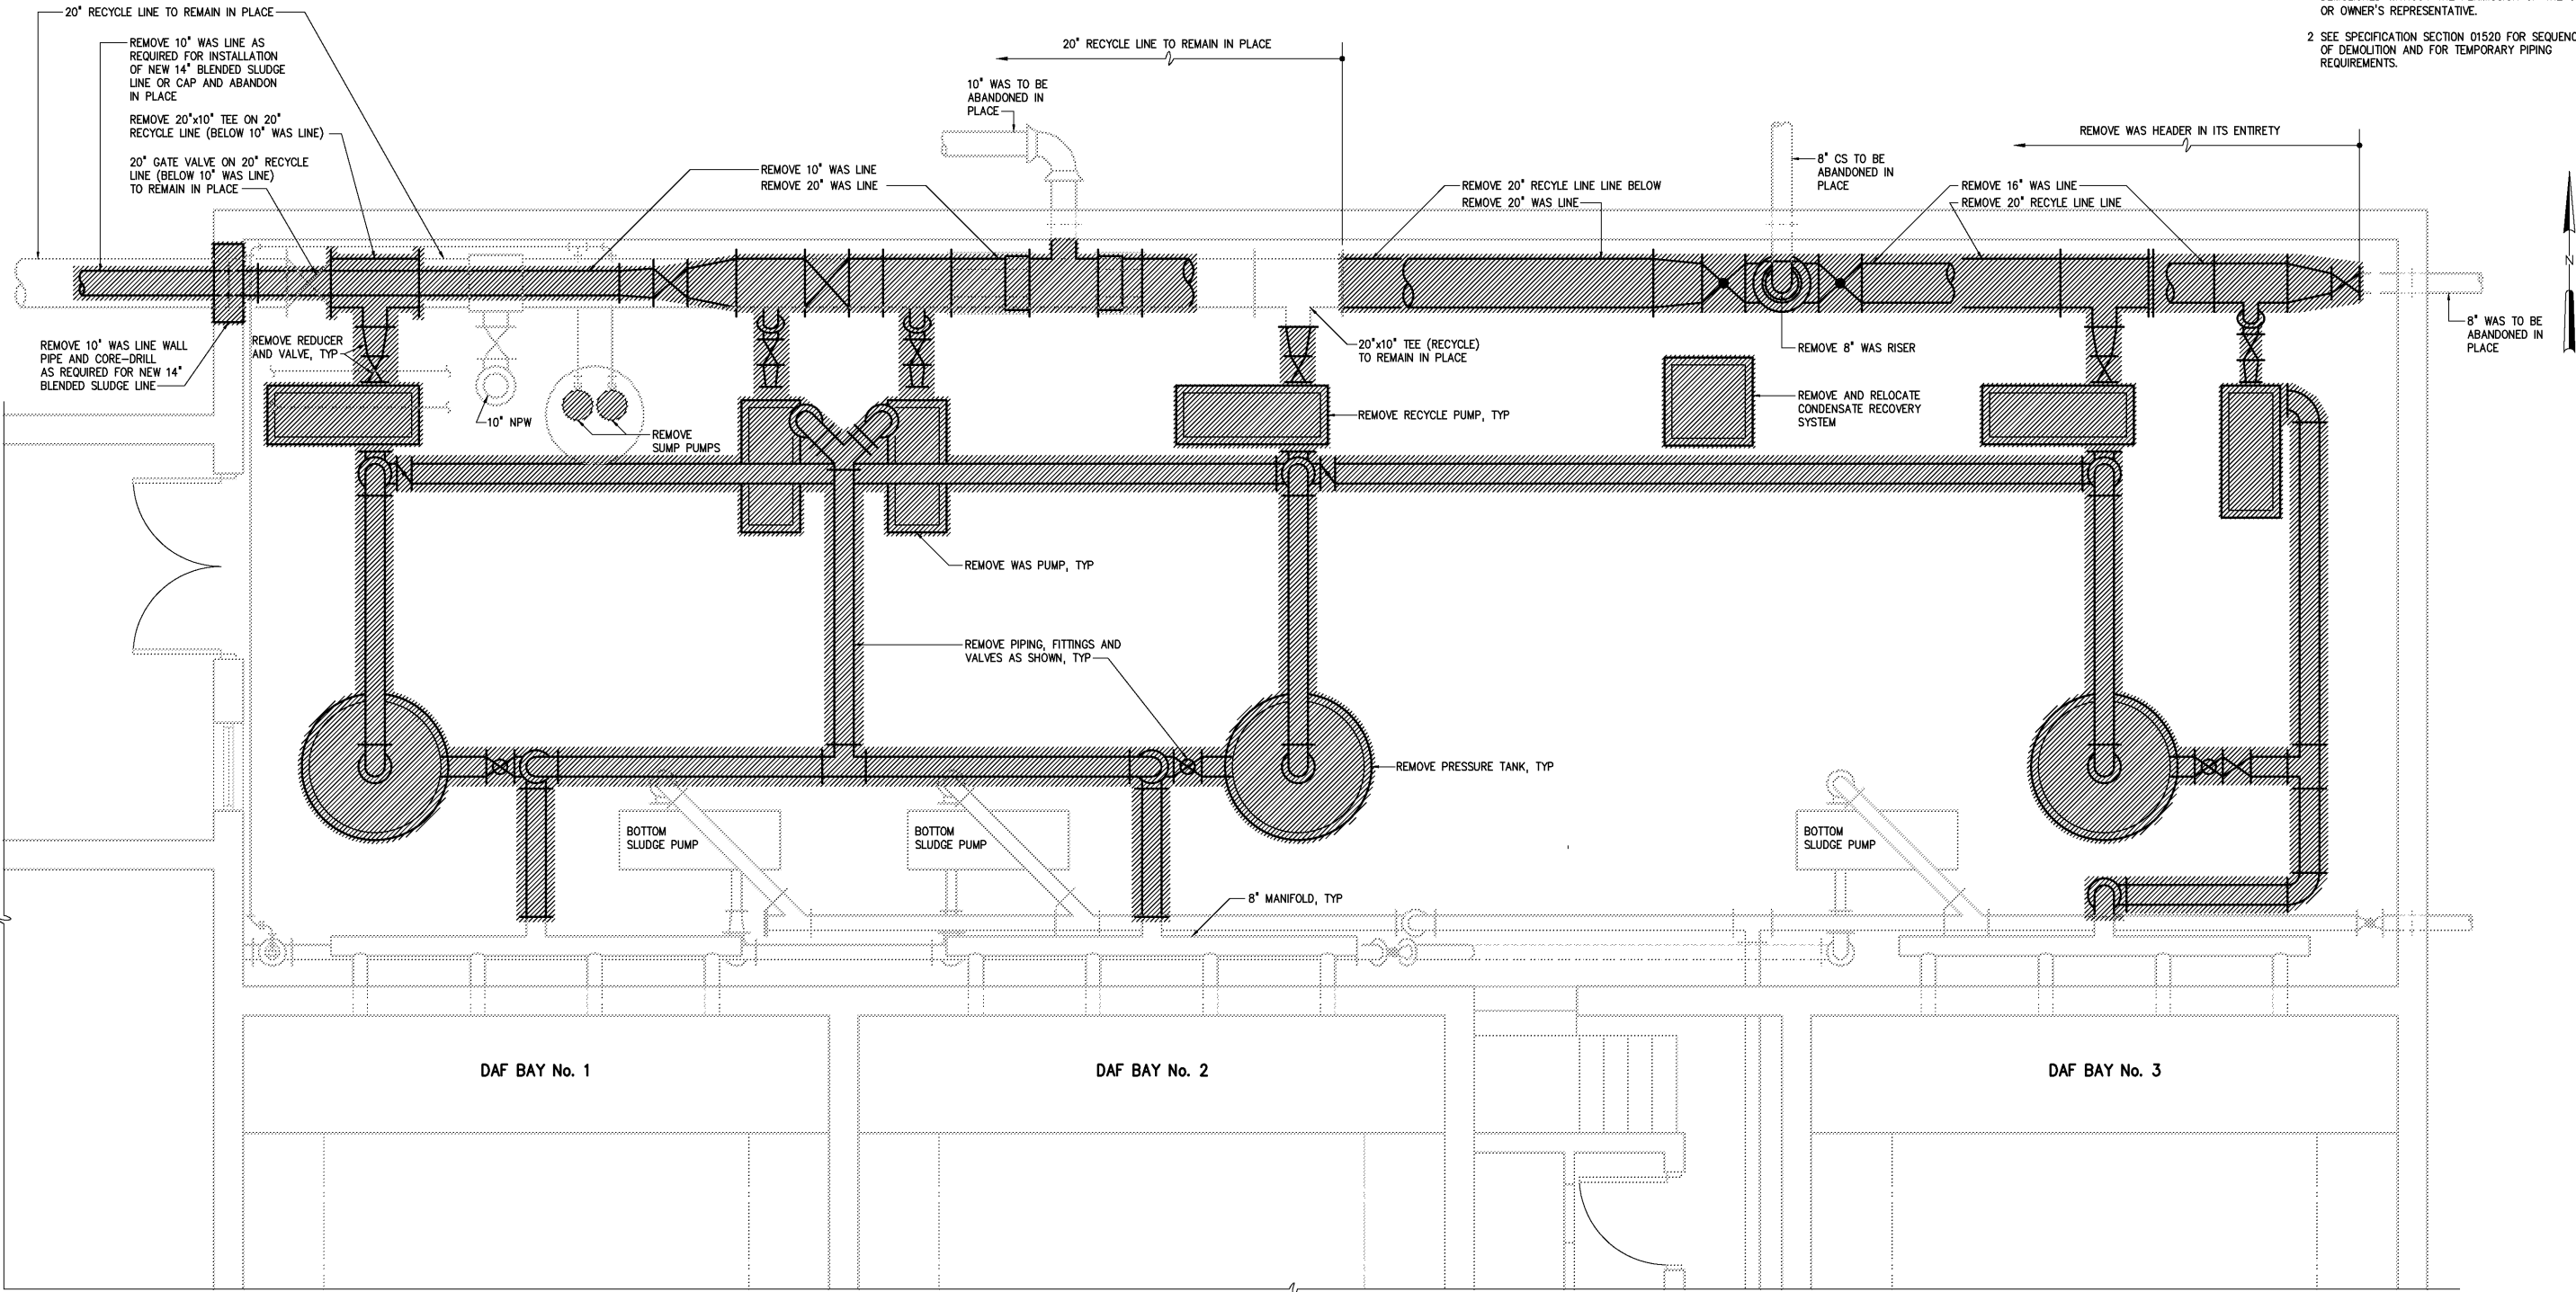

DEMOLITION PLAN - PUMP ROOM

3/8"=1'-0"

				DESIGNED	CMB/DAN
				DRAWN	BRC
				CHECKED	
3	AS BUILT	OCT 2007	RLT	PROJ. ENGR.	H & S
2	CONSTRUCTION	MAR 2004	RLT		
1	REGULATORY APPROVAL	NOV 2003	RLT		
NO.	ISSUED FOR	DATE	BY	APPROVED	

THIS DOCUMENT ORIGINALLY ISSUED FOR CONSTRUCTION AND SEALED BY ROBERT S. DIFIORE, SEAL NO. 22769

RECORD DRAWING

THIS DRAWING HAS BEEN MODIFIED TO REFLECT FIELD CHANGES REPORTED BY THE CONTRACTOR OR ANOTHER PARTY, BUT NOT VERIFIED BY THE CERTIFYING ENGINEER. THIS DOCUMENT ORIGINALLY ISSUED AND SEALED BY CHARLES M. BULLARD, SEAL NUMBER 036668. THIS MEDIA SHALL NOT BE CONSIDERED A CERTIFIED DOCUMENT.

THIS DOCUMENT ORIGINALLY ISSUED FOR CONSTRUCTION AND SEALED BY RONALD L. TAYLOR, SEAL NO. 024649

HAZEN AND SAWYER
Environmental Engineers & Scientists
4011 WestChase Blvd, Raleigh, North Carolina 27607

CITY OF ROANOKE
VIRGINIA

REGIONAL WATER POLLUTION CONTROL PLANT
PROCESS TRAIN IMPROVEMENTS

DAF THICKENER BUILDING MODIFICATIONS
MECHANICAL
DEMOLITION PLAN

THE SCALE BAR SHOWN BELOW MEASURES ONE INCH LONG ON THE ORIGINAL DRAWING.	DATE	MARCH 2004
	H & S JOB NUMBER	30788B
	CONTRACT NUMBER	B
	DRAWING NUMBER	M740