

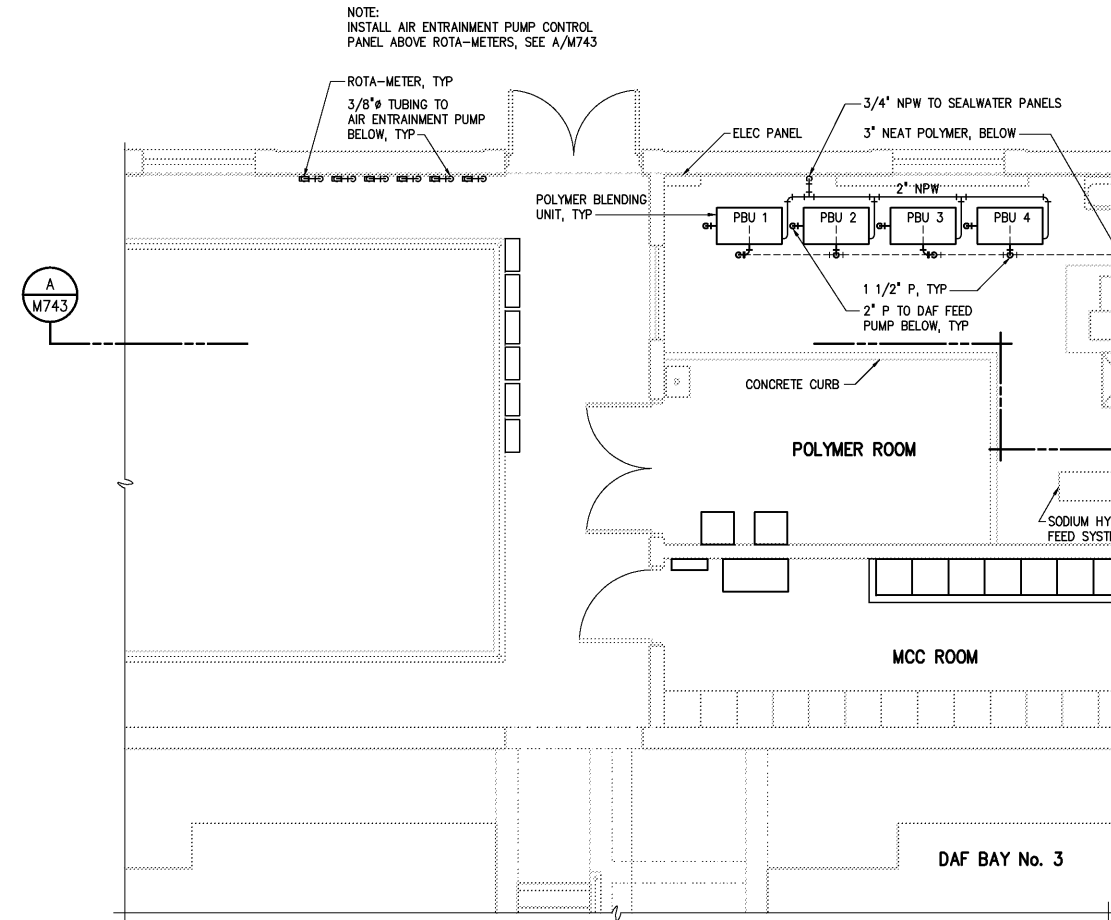
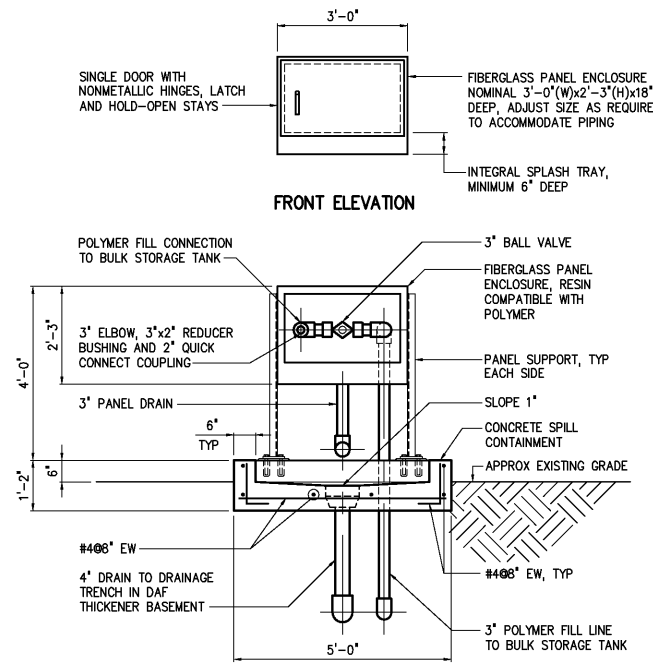


PARTIAL TOP PLAN - DEMOLITION  
1/4"=1'-0"

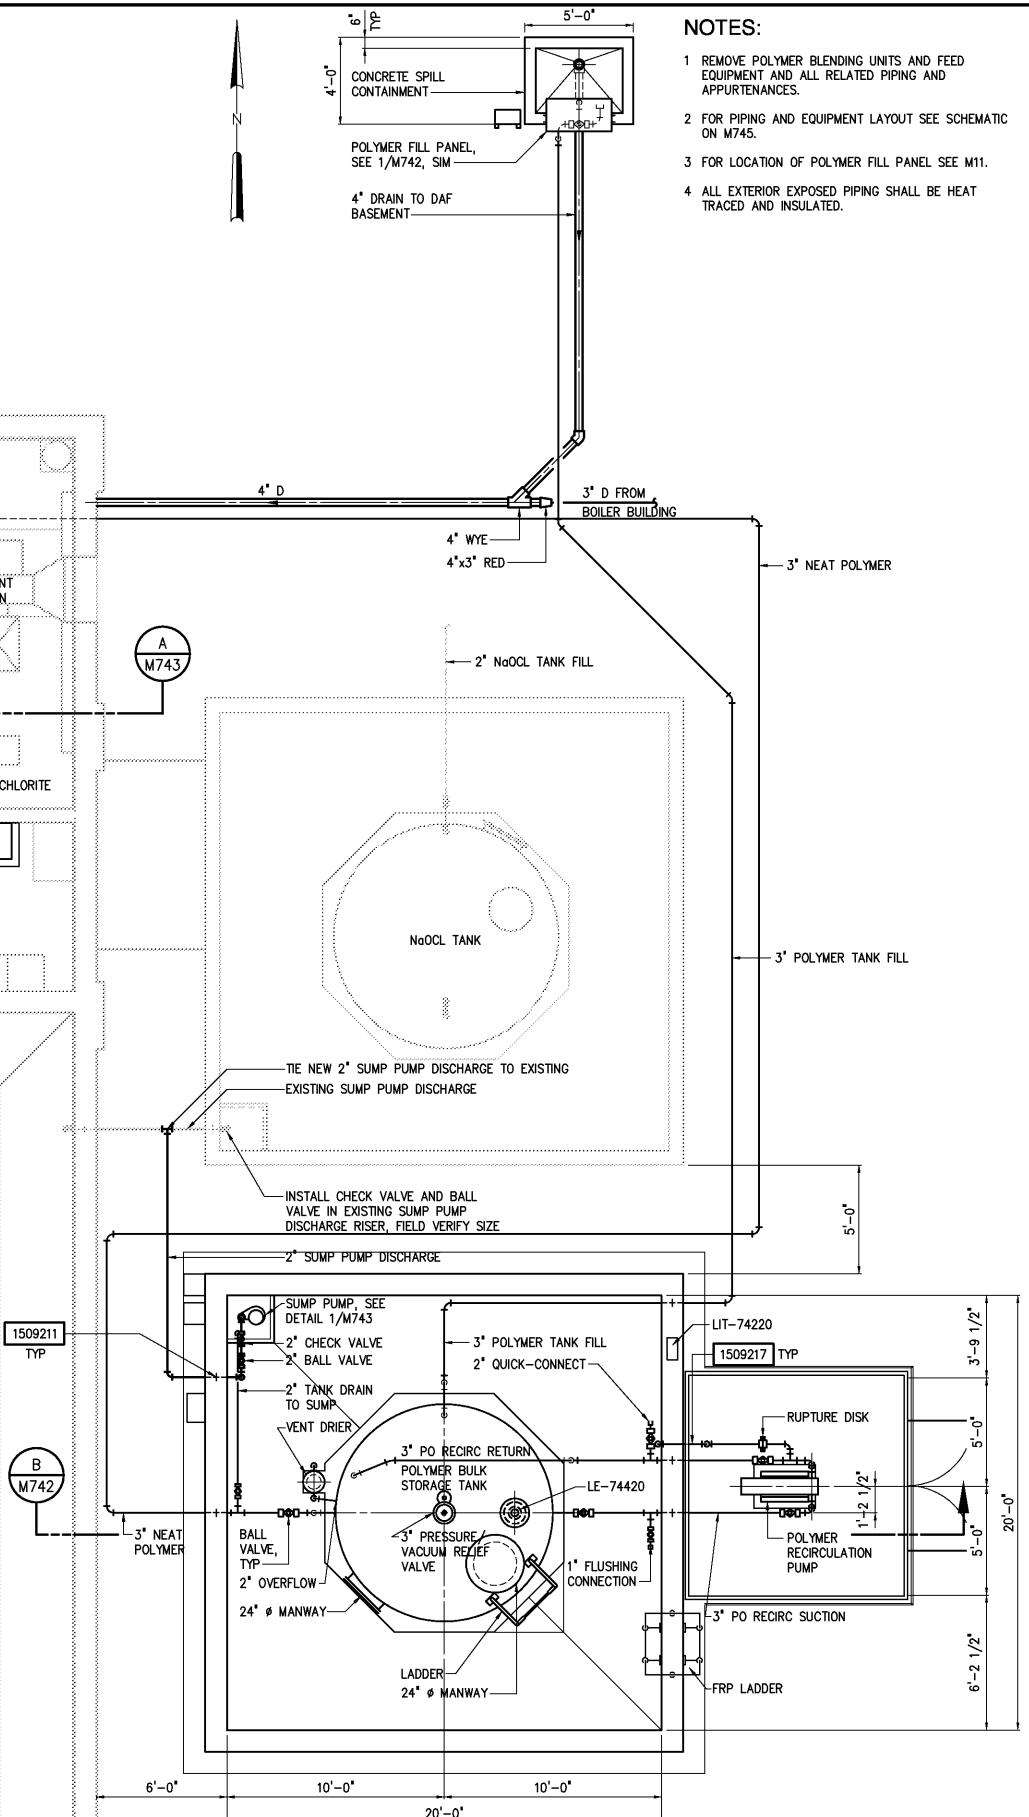

PARTIAL TOP PLAN  
1/4"=1'-0"

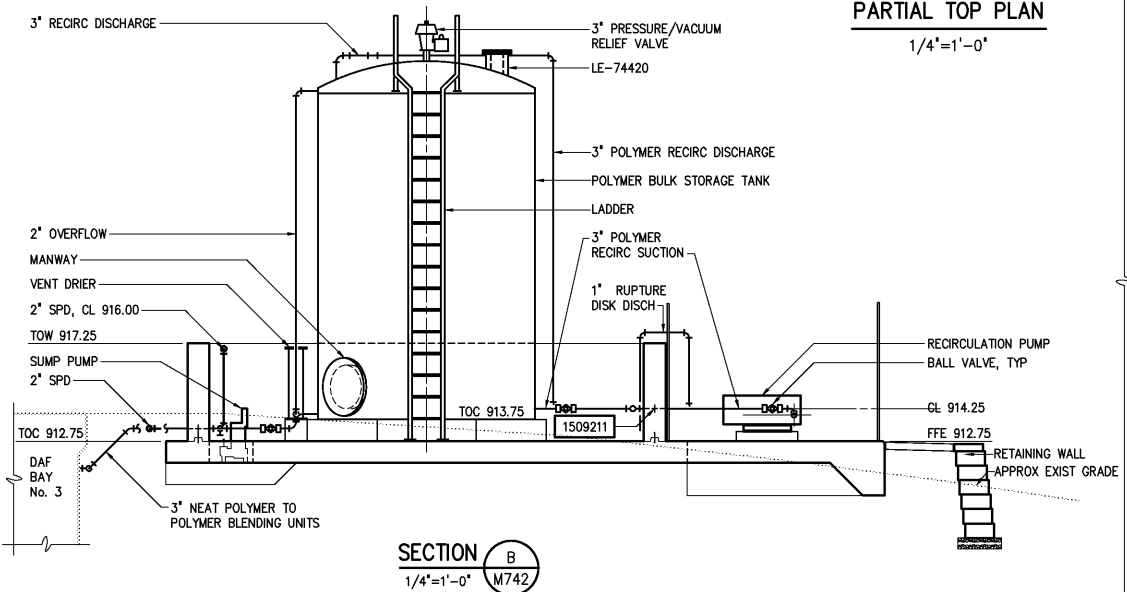

DESIGNED	CMB/DAN
DRAWN	BRC
CHECKED	
PROJ. ENGR.	H & S
APPROVED	
NO.	
1	ISSUED FOR
2	CONSTRUCTION
3	REGULATORY APPROVAL
AS BUILT	
OCT 2007	RLT
MAR 2004	RLT
NOV 2003	RLT
DATE	BY

THIS DOCUMENT ORIGINALLY ISSUED FOR CONSTRUCTION AND SEALED BY ROBERT S. DIFIORE, SEAL NO. 22769

THIS DOCUMENT ORIGINALLY ISSUED FOR CONSTRUCTION AND SEALED BY RONALD L. TAYLOR, SEAL NO. 024649

RECORD DRAWING

THIS DRAWING HAS BEEN MODIFIED TO REFLECT FIELD CHANGES REPORTED BY THE CONTRACTOR OR ANOTHER PARTY, BUT NOT VERIFIED BY THE CERTIFYING ENGINEER. THIS DOCUMENT ORIGINALLY ISSUED AND SEALED BY CHARLES M. BULLARD, SEAL NUMBER 036668. THIS MEDIA SHALL NOT BE CONSIDERED A CERTIFIED DOCUMENT.

**HAZEN AND SAWYER**  
Environmental Engineers & Scientists  
4011 WestChase Blvd, Raleigh, North Carolina 27607

**CITY OF ROANOKE**  
VIRGINIA

REGIONAL WATER POLLUTION CONTROL PLANT  
PROCESS TRAIN IMPROVEMENTS

DAF THICKENER BUILDING MODIFICATIONS  
MECHANICAL  
PARTIAL TOP PLANS, SECTION AND DETAIL

THE SCALE BAR SHOWN BELOW MEASURES ONE INCH LONG ON THE ORIGINAL DRAWING.	DATE	MARCH 2004
H & S JOB NUMBER	CONTRACT NUMBER	DRAWING NUMBER
30788B	B	M742