


NOTES:

1 PROVIDE 316 L STAINLESS STEEL RUPTURE DISK, 150 ANSI FLANGE FOR 1" DIA SCHEDULE 80 PVC DISCHARGE PIPE, 50 PSI BURST PRESSURE, WITH RUPTURE DISK HOLDER WITH PTFE GASKETS. RUPTURE DISK AND HOLDER SHALL BE ZOOK, URA SERIES, OR EQUAL.

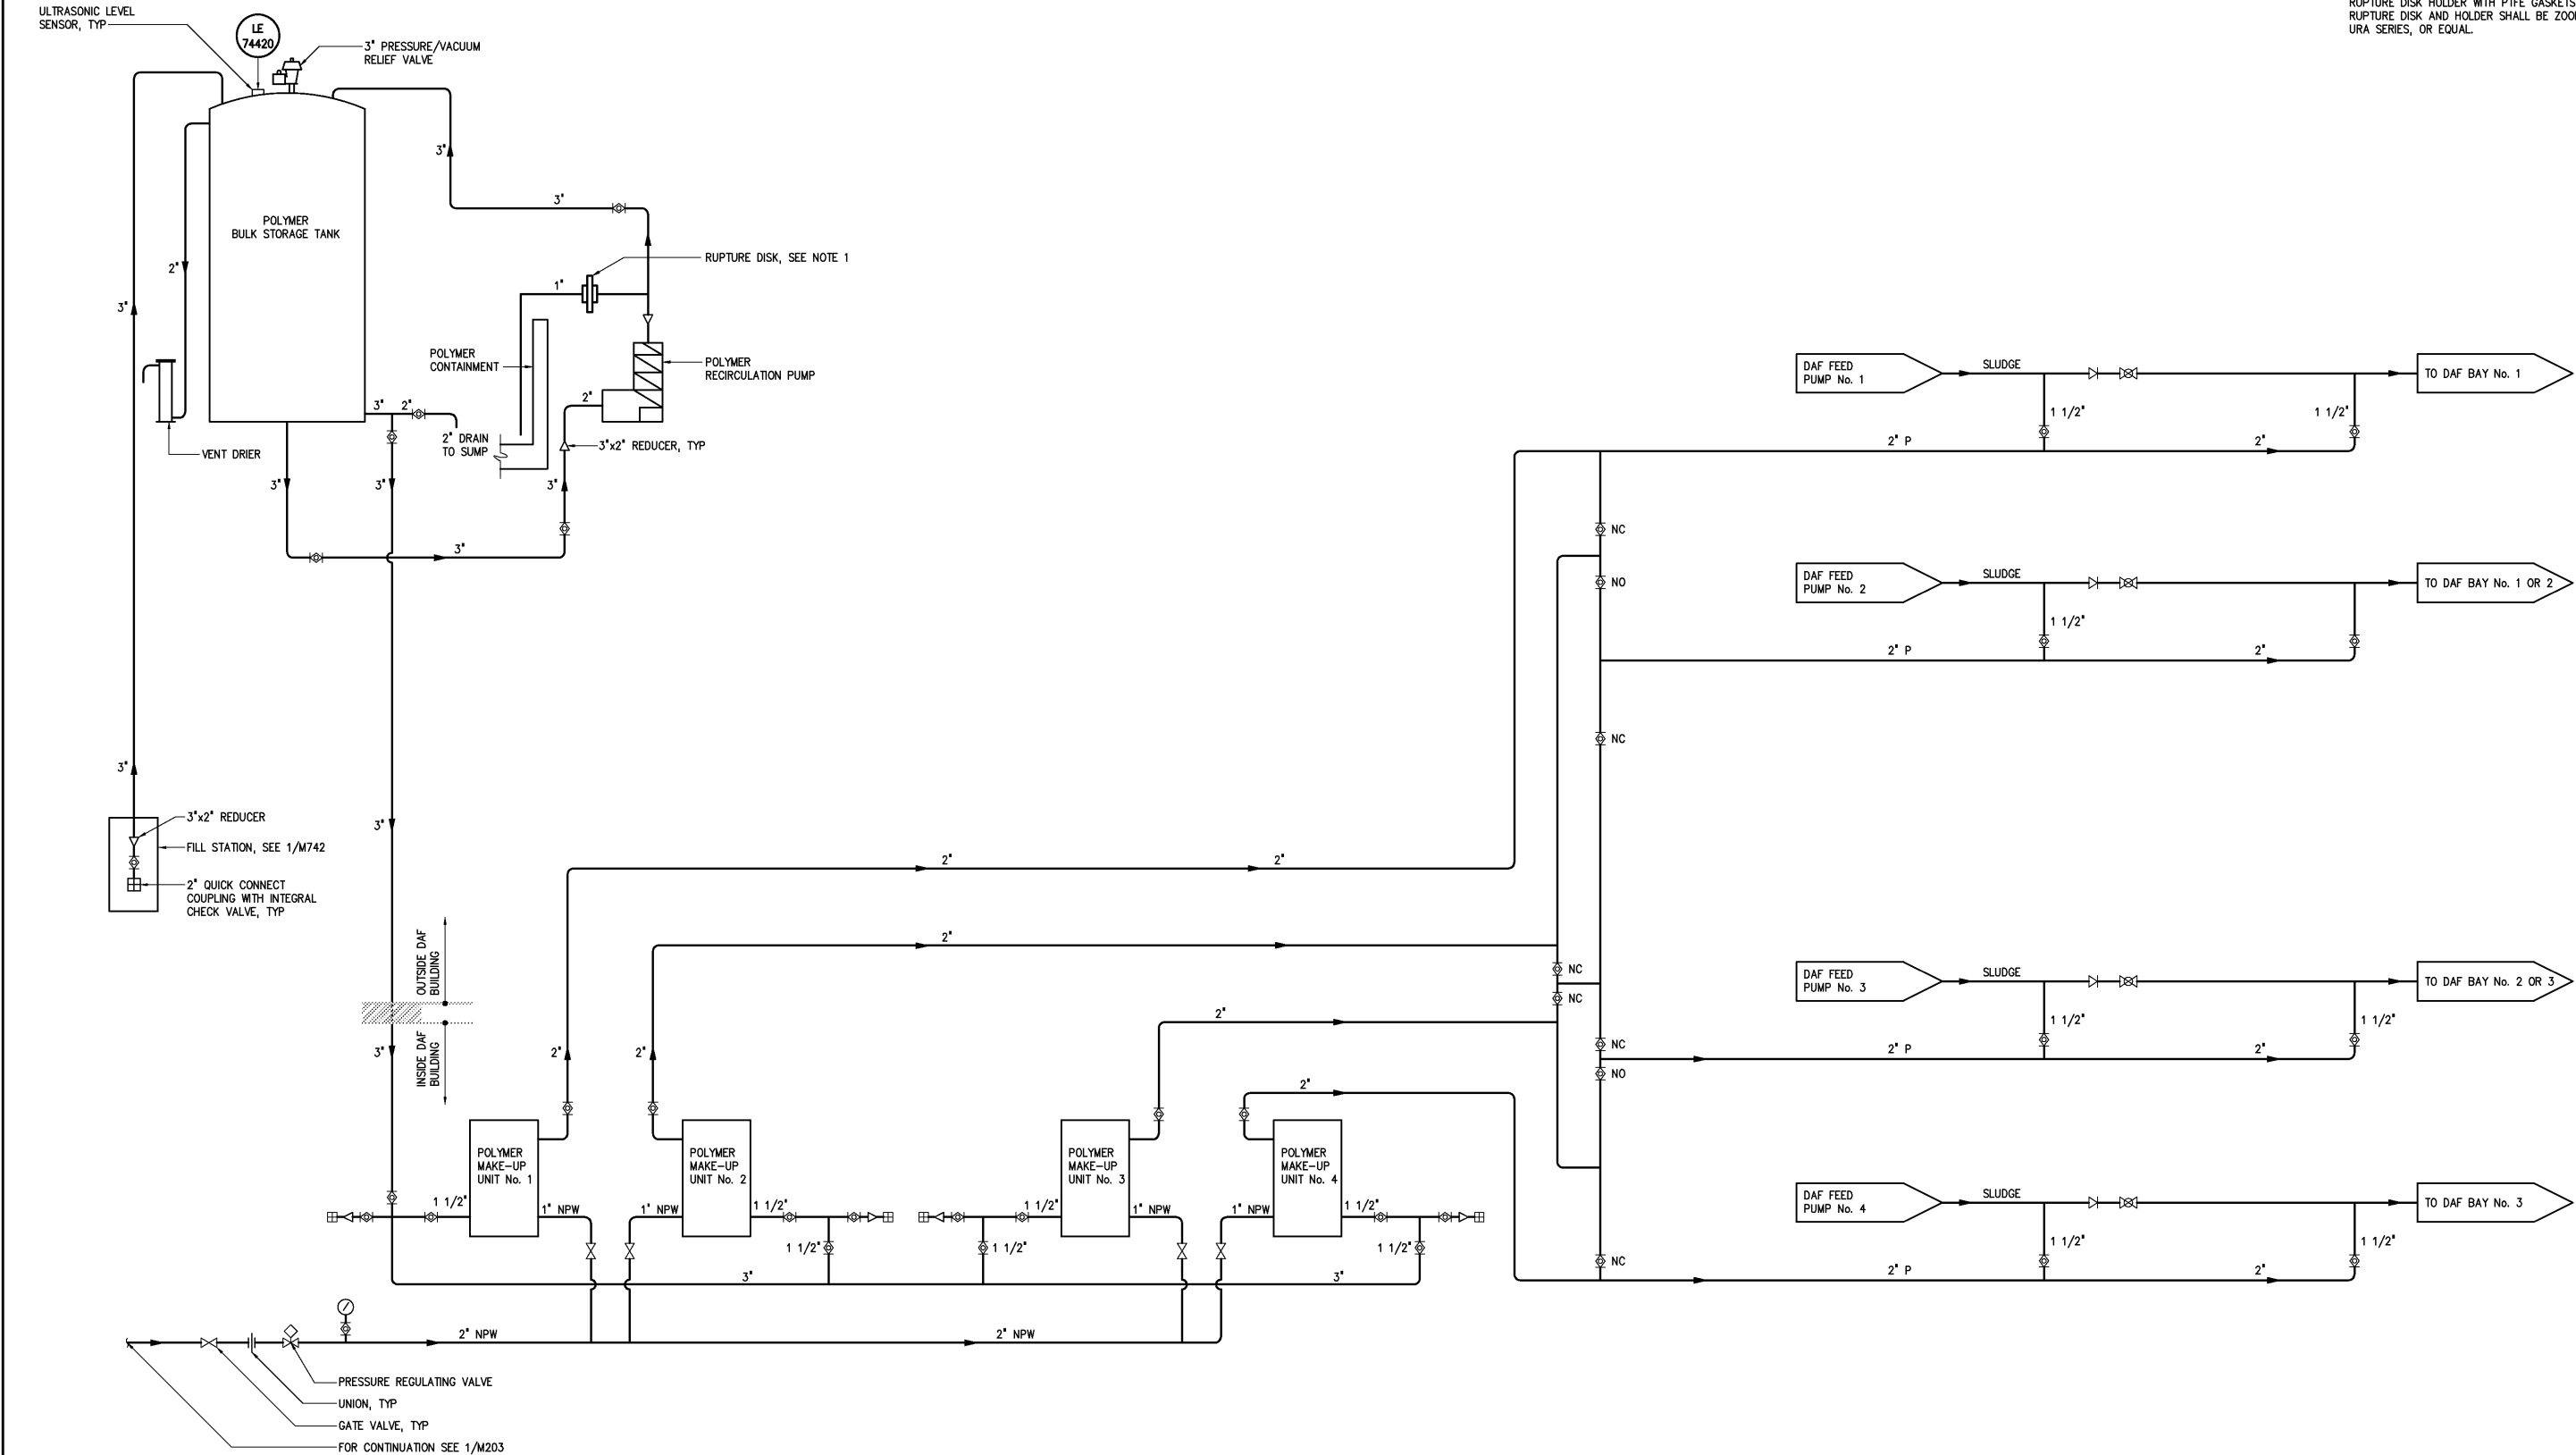

DESIGNED	CMB/DAN
DRAWN	BRC
CHECKED	
PROJ. ENGR.	DAN
APPROVED	
NO.	
3	AS BUILT
2	CONSTRUCTION
1	REGULATORY APPROVAL
NO.	ISSUED FOR
DATE	BY
OCT 2007	RLT
MAR 2004	RLT
NOV 2003	RLT

THIS DOCUMENT ORIGINALLY ISSUED FOR CONSTRUCTION AND SEALED BY ROBERT S. DIFIORE, SEAL NO. 22769

RECORD DRAWING

THIS DRAWING HAS BEEN MODIFIED TO REFLECT FIELD CHANGES REPORTED BY THE CONTRACTOR OR ANOTHER PARTY, BUT NOT VERIFIED BY THE CERTIFYING ENGINEER. THIS DOCUMENT ORIGINALLY ISSUED AND SEALED BY CHARLES M. BULLARD, SEAL NUMBER 036668. THIS MEDIA SHALL NOT BE CONSIDERED A CERTIFIED DOCUMENT.

THIS DOCUMENT ORIGINALLY ISSUED FOR CONSTRUCTION AND SEALED BY RONALD L. TAYLOR, SEAL NO. 024649

HAZEN AND SAWYER
Environmental Engineers & Scientists
4011 WestChase Blvd, Raleigh, North Carolina 27607

CITY OF ROANOKE
VIRGINIA

REGIONAL WATER POLLUTION CONTROL PLANT
PROCESS TRAIN IMPROVEMENTS

DAF THICKENER BUILDING MODIFICATIONS
MECHANICAL
DAF POLYMER SCHEMATIC

THE SCALE BAR SHOWN BELOW MEASURES ONE INCH LONG ON THE ORIGINAL DRAWING.

DATE MARCH 2004
H & S JOB NUMBER 30788B
CONTRACT NUMBER B
DRAWING NUMBER M745