
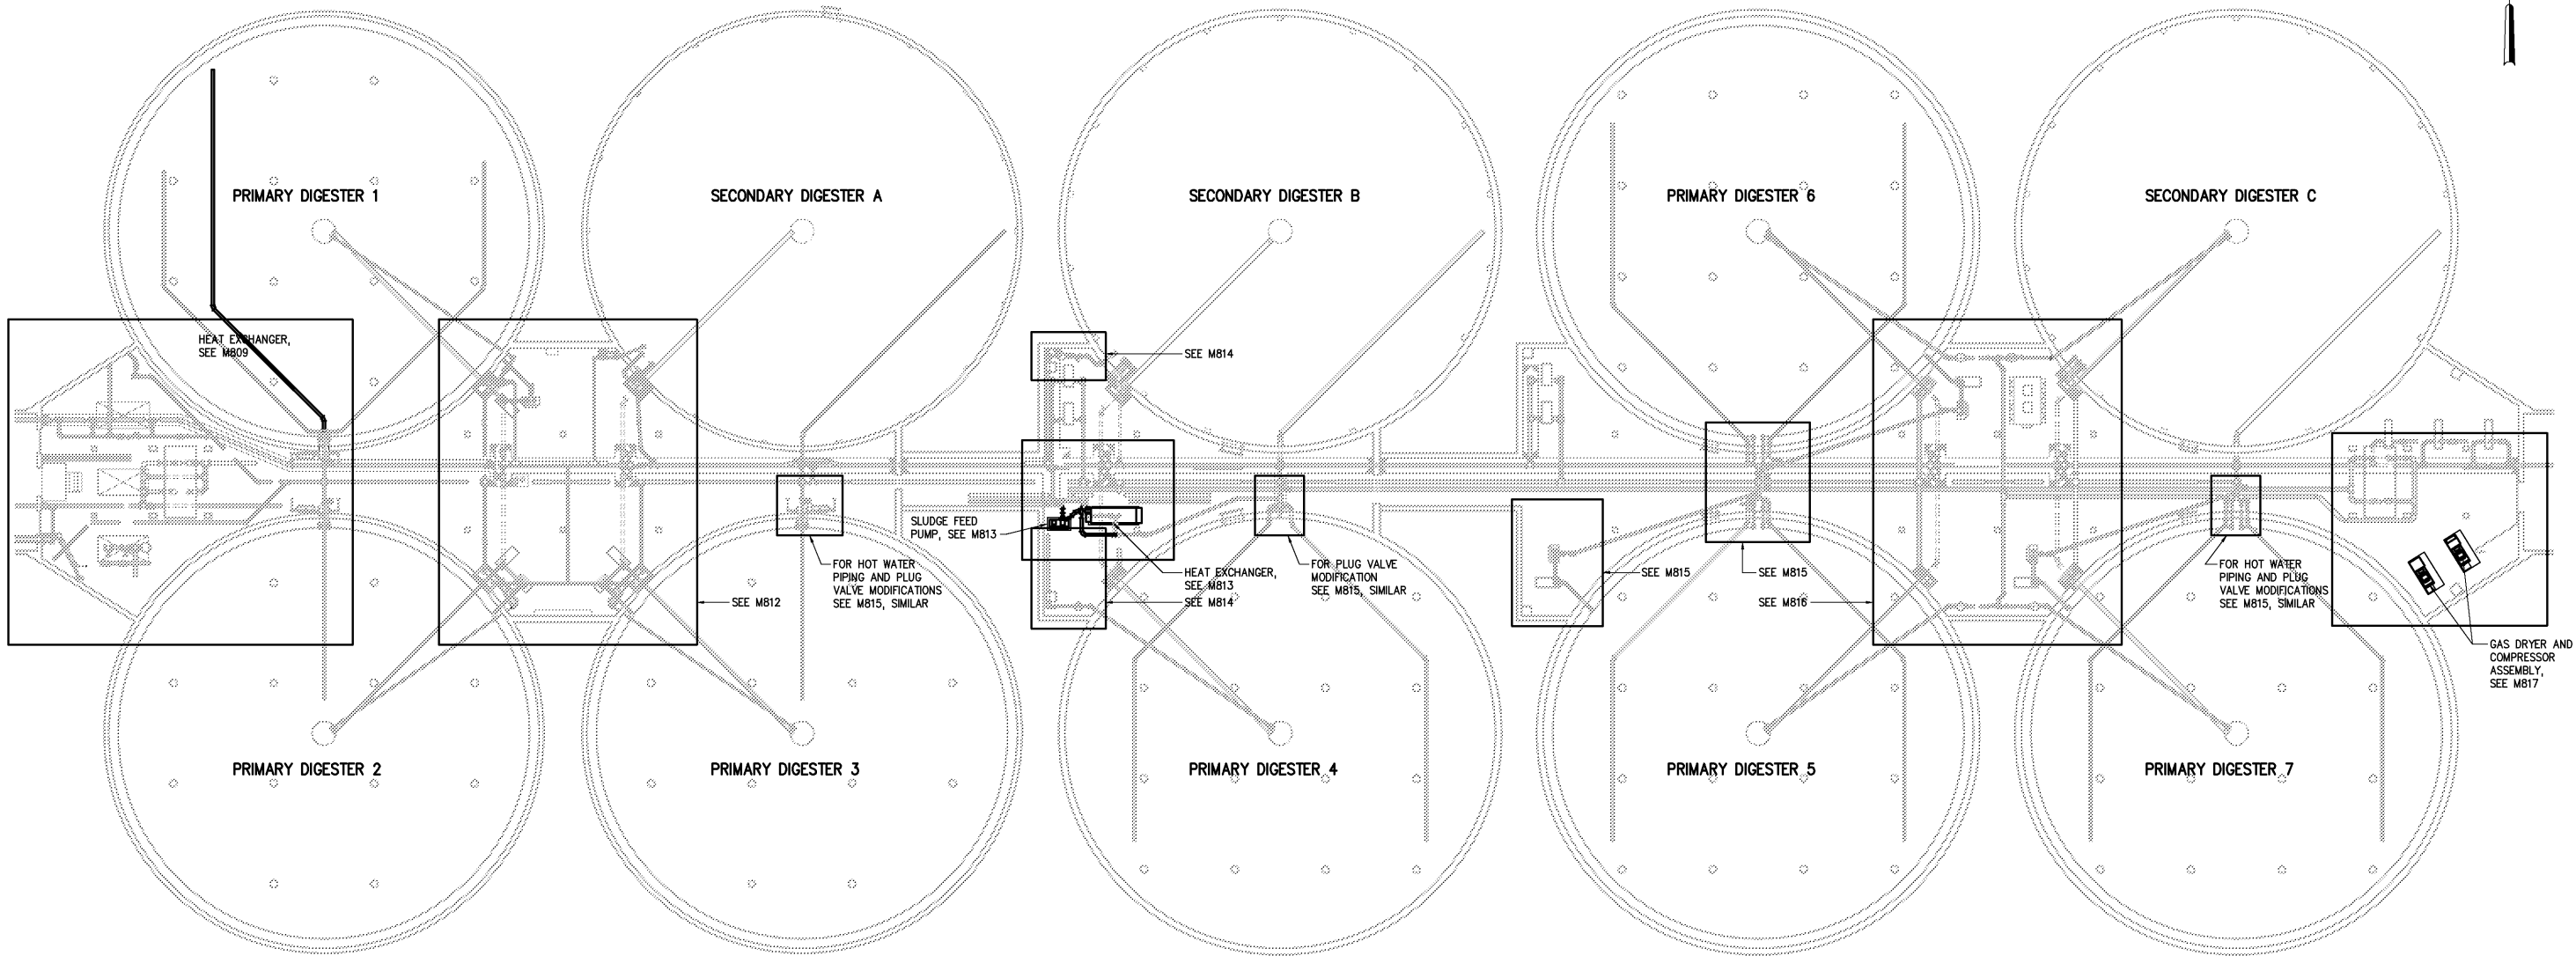 


NOTES:



OVERALL BOTTOM PLAN  
1/16"=1'-0"

				DESIGNED CMB/HGM	RECORD DRAWING	THIS DOCUMENT ORIGINALLY ISSUED FOR CONSTRUCTION AND SEALED BY ROBERT S. DIFIORE, SEAL NO. 22769	THIS DRAWING HAS BEEN MODIFIED TO REFLECT FIELD CHANGES REPORTED BY THE CONTRACTOR OR ANOTHER PARTY, BUT NOT VERIFIED BY THE CERTIFYING ENGINEER. THIS DOCUMENT ORIGINALLY ISSUED AND SEALED BY CHARLES M. BULLARD, SEAL NUMBER 036668. THIS MEDIA SHALL NOT BE CONSIDERED A CERTIFIED DOCUMENT.	HAZEN AND SAWYER Environmental Engineers & Scientists 4011 WestChase Blvd, Raleigh, North Carolina 27607	CITY OF ROANOKE VIRGINIA	REGIONAL WATER POLLUTION CONTROL PLANT PROCESS TRAIN IMPROVEMENTS	DIGESTER MODIFICATIONS  MECHANICAL  OVERALL BOTTOM PLAN	THE SCALE BAR SHOWN BELOW MEASURES ONE INCH LONG ON THE ORIGINAL DRAWING.	DATE MARCH 2004			
				DRAWN HGM									H & S JOB NUMBER 30788B			
				CHECKED									CONTRACT NUMBER B			
3	AS BUILT	OCT 2007	RLT	PROJ. ENGR. DAN	APPROVED	THIS DOCUMENT ORIGINALLY ISSUED FOR CONSTRUCTION AND SEALED BY RONALD L. TAYLOR, SEAL NO. 024649									DRAWING NUMBER M800	
2	CONSTRUCTION	MAR 2004	RLT													
1	REGULATORY APPROVAL	NOV 2003	RLT													
NO.	ISSUED FOR	DATE	BY													