
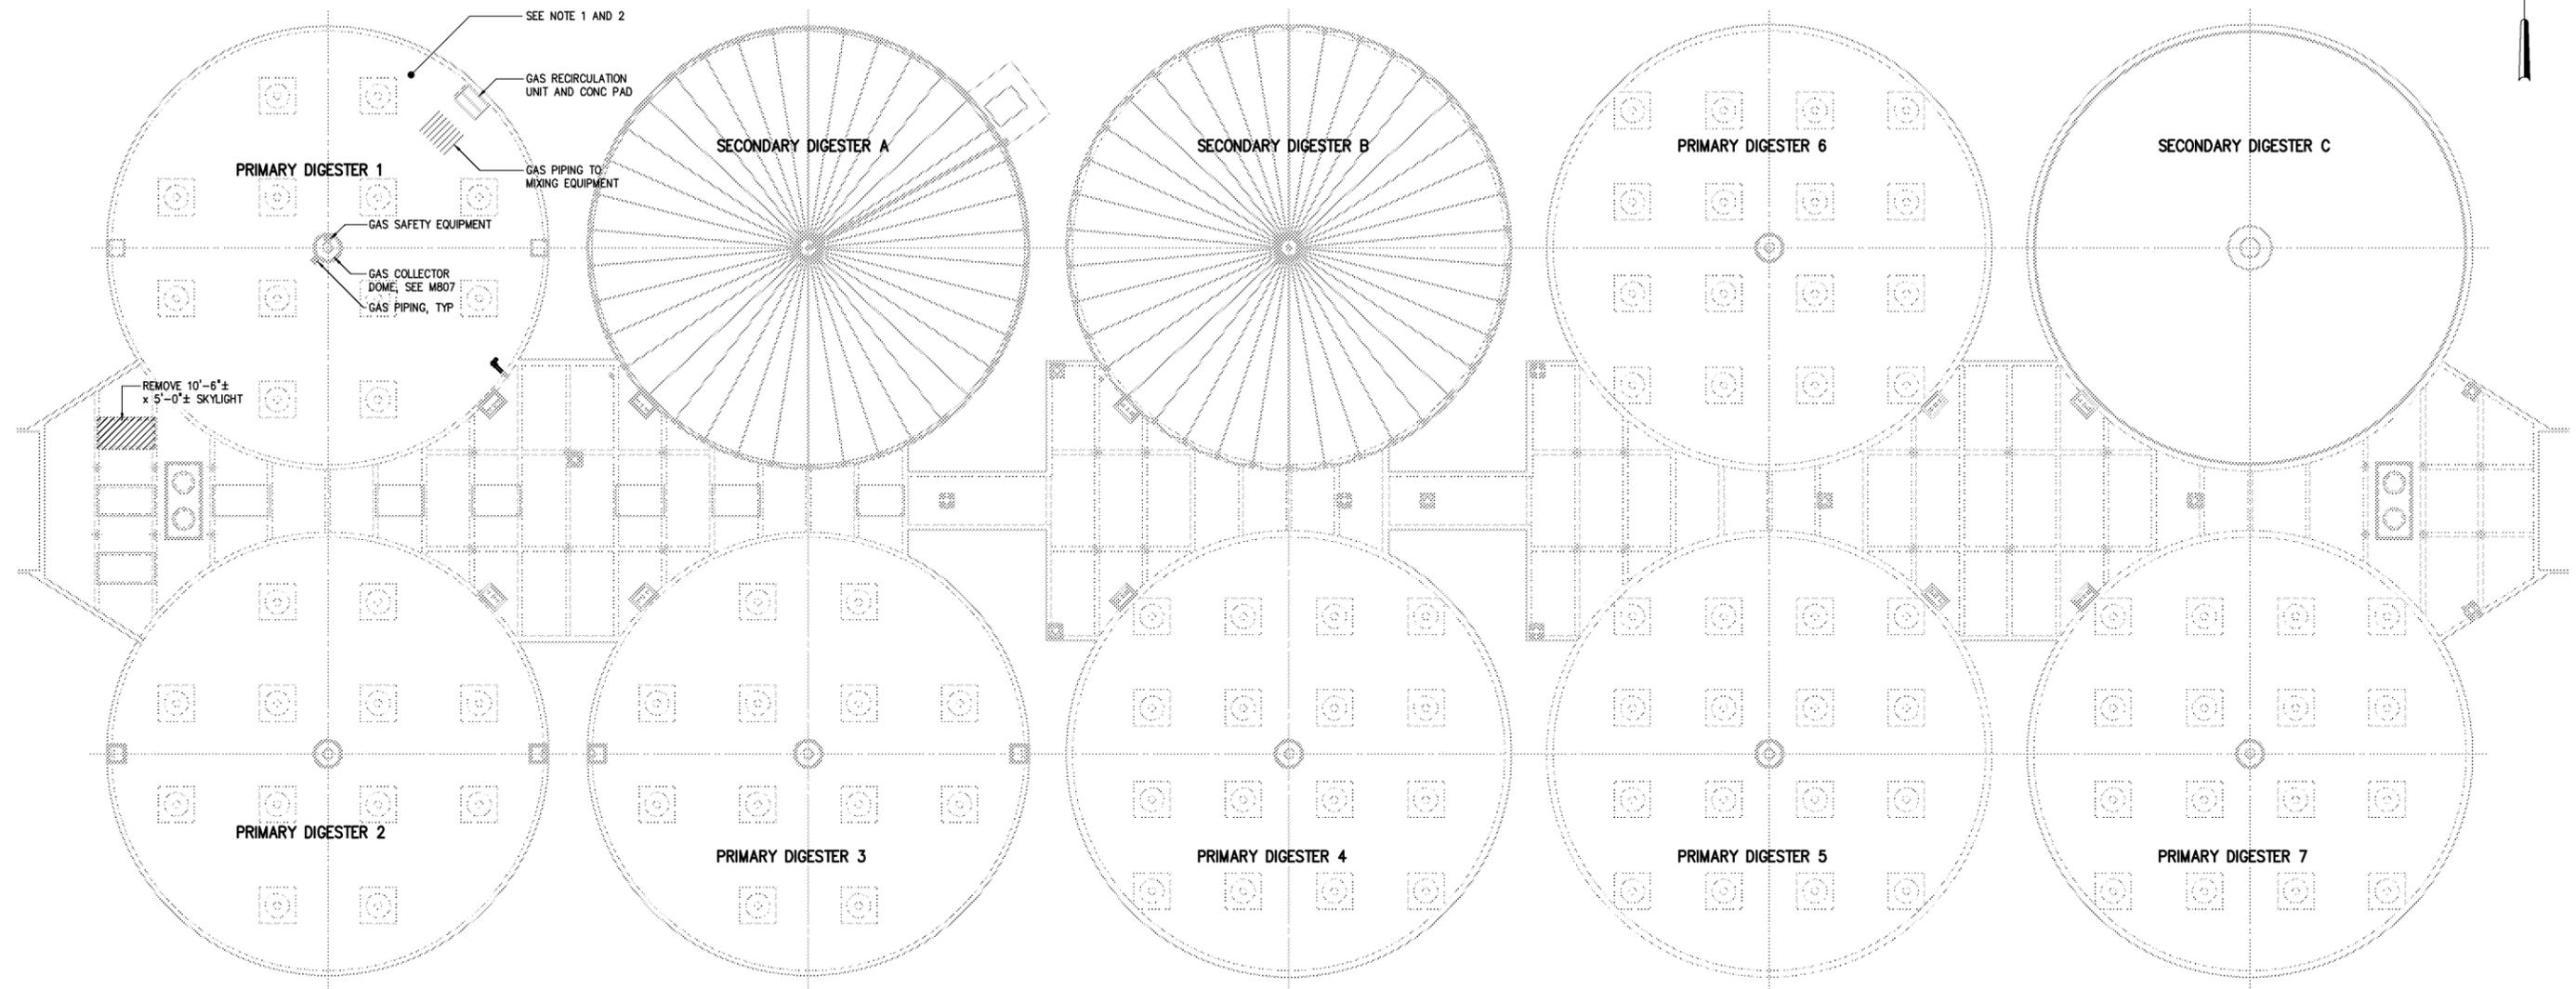


NOTES:

- 1 THE CONTRACTOR SHALL REMOVE SOIL AND GRAVEL OVERBURDEN FROM ROOF OF PRIMARY DIGESTER 1. ROOF SHALL BE CLEANED BY THE CONTRACTOR FOR INSPECTION BY THE ENGINEER. SOIL AND GRAVEL OVERBURDEN THICKNESS IS APPROXIMATELY 18 INCHES.
- 2 THE CONTRACTOR SHALL REPAIR CONCRETE SURFACE SPALLS AND CRACKS AS DIRECTED BY THE ENGINEER. FOLLOWING REPAIR THE CONTRACTOR SHALL REPLACE ROOF COVERING WITH NEW 18 INCH THICK LAYER OF GRAVEL. QUANTITIES TO REPAIR SHALL BE AS QUANTIFIED ON BID FORM AND IN SPECIFICATION SECTION 03732.

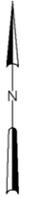

OVERALL TOP PLAN
1/16"=1'-0"

DESIGNED	CMB/HGM	
DRAWN	HGM	
CHECKED		
PROJ. ENGR.	DAN	
APPROVED		
NO.	DATE	BY
3	AS BUILT	OCT 2007 RLT
2	CONSTRUCTION	MAR 2004 RLT
1	REGULATORY APPROVAL	NOV 2003 RLT
	ISSUED FOR	DATE BY

THIS DOCUMENT ORIGINALLY ISSUED FOR CONSTRUCTION AND SEALED BY ROBERT S. DIFIORE, SEAL NO. 22769

RECORD DRAWING

THIS DRAWING HAS BEEN MODIFIED TO REFLECT FIELD CHANGES REPORTED BY THE CONTRACTOR OR ANOTHER PARTY, BUT NOT VERIFIED BY THE CERTIFYING ENGINEER. THIS DOCUMENT ORIGINALLY ISSUED AND SEALED BY CHARLES M. BULLARD, SEAL NUMBER 036668. THIS MEDIA SHALL NOT BE CONSIDERED A CERTIFIED DOCUMENT.

THIS DOCUMENT ORIGINALLY ISSUED FOR CONSTRUCTION AND SEALED BY RONALD L. TAYLOR, SEAL NO. 024649

HAZEN AND SAWYER
Environmental Engineers & Scientists
4011 WestChase Blvd, Raleigh, North Carolina 27607

CITY OF ROANOKE
VIRGINIA
REGIONAL WATER POLLUTION CONTROL PLANT
PROCESS TRAIN IMPROVEMENTS

DIGESTER MODIFICATIONS
MECHANICAL
OVERALL TOP PLAN

THE SCALE BAR SHOWN BELOW MEASURES ONE INCH LONG ON THE ORIGINAL DRAWING.	DATE	MARCH 2004
	H & S JOB NUMBER	30788B
	CONTRACT NUMBER	B
	DRAWING NUMBER	M801