



NOTES:
1 FOR ADDITIONAL INFORMATION SEE
SCHEMATIC M808 AND PLAN M809

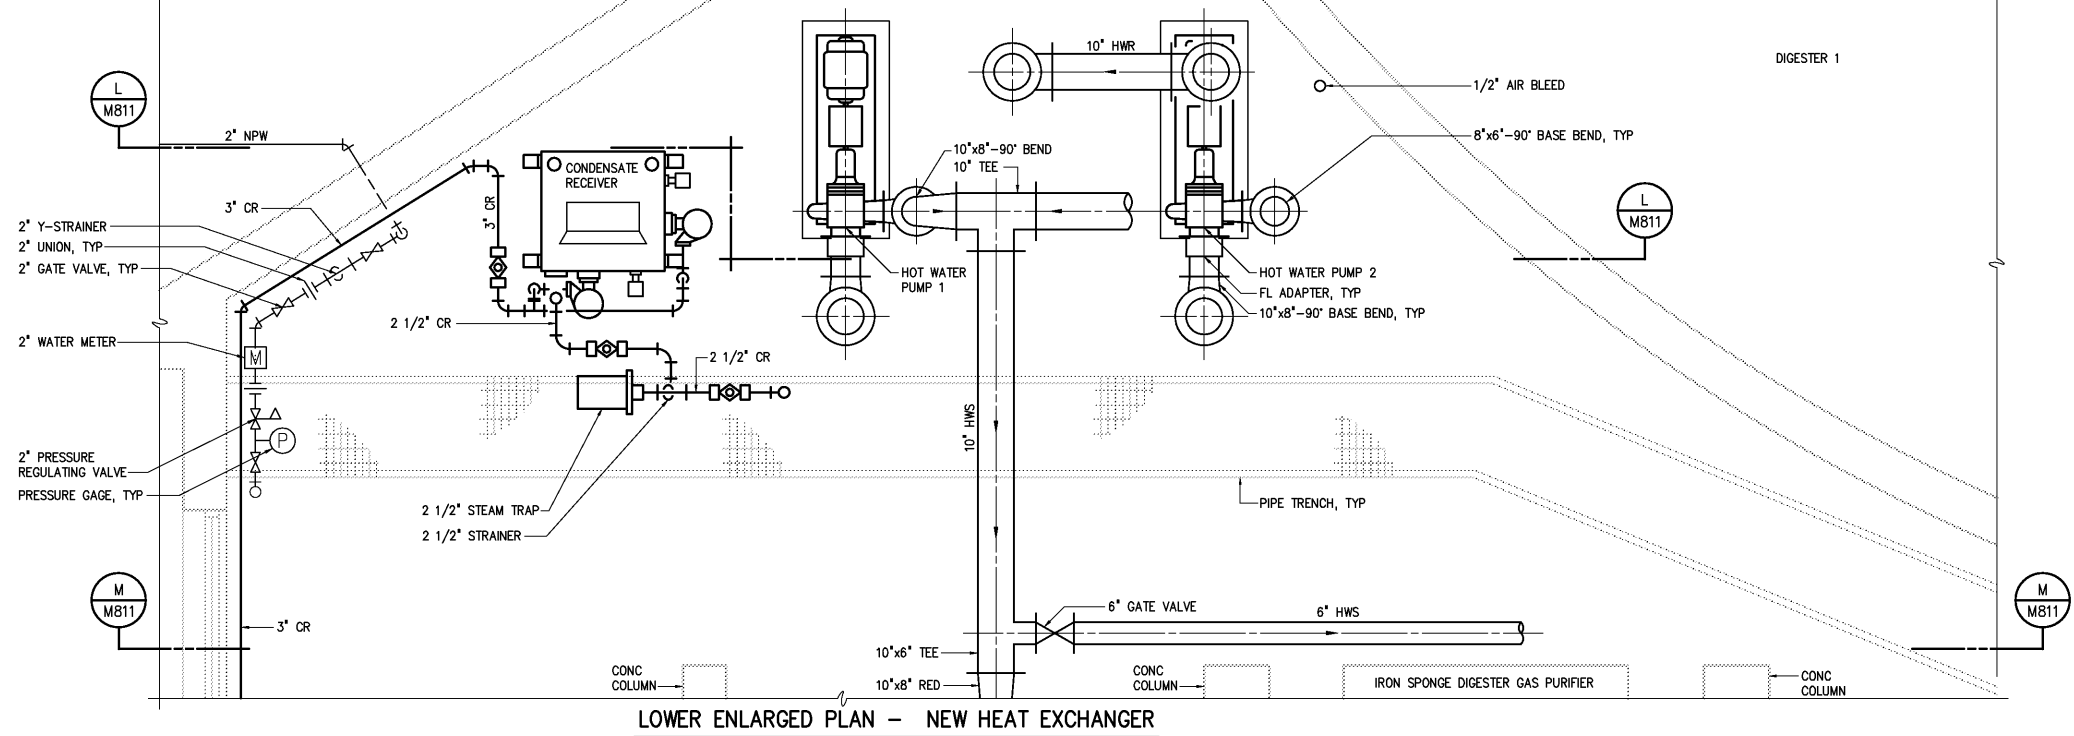

LOWER ENLARGED PLAN - NEW HEAT EXCHANGER

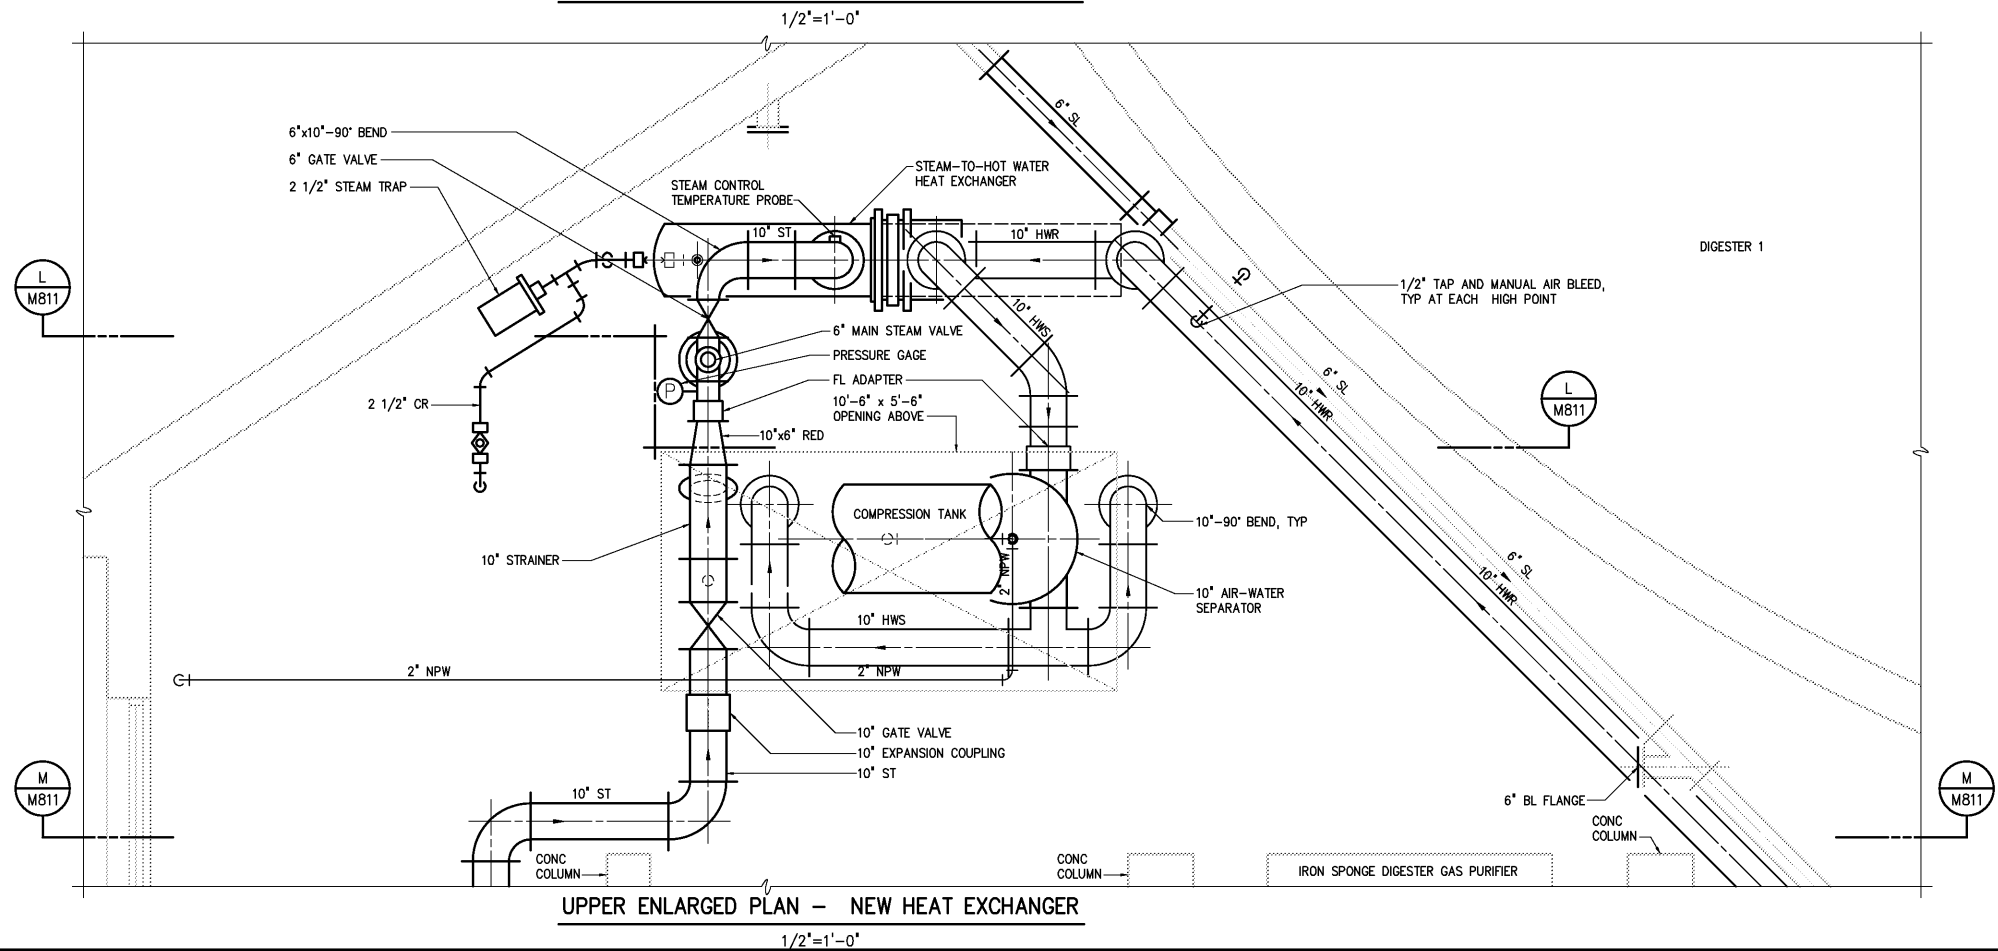

UPPER ENLARGED PLAN - NEW HEAT EXCHANGER

DESIGNED	CMB/HGM
DRAWN	HGM
CHECKED	
PROJ. ENGR.	DAN
APPROVED	
DATE	BY
NO.	
3	AS BUILT
2	CONSTRUCTION
1	REGULATORY APPROVAL
NO.	ISSUED FOR

OCT 2007	RLT
MAR 2004	RLT
NOV 2003	RLT
DATE	BY

RECORD DRAWING

THIS DRAWING HAS BEEN MODIFIED TO REFLECT FIELD CHANGES REPORTED BY THE CONTRACTOR OR ANOTHER PARTY, BUT NOT VERIFIED BY THE CERTIFYING ENGINEER. THIS DOCUMENT ORIGINALLY ISSUED AND SEALED BY CHARLES M. BULLARD, SEAL NUMBER 036668. THIS MEDIA SHALL NOT BE CONSIDERED A CERTIFIED DOCUMENT.

HAZEN AND SAWYER
Environmental Engineers & Scientists
4011 WestChase Blvd, Raleigh, North Carolina 27607

CITY OF ROANOKE
VIRGINIA
REGIONAL WATER POLLUTION CONTROL PLANT
PROCESS TRAIN IMPROVEMENTS

DIGESTER MODIFICATIONS
MECHANICAL
ENLARGED PLANS - NEW HEAT EXCHANGER

THE SCALE BAR SHOWN BELOW MEASURES ONE INCH LONG ON THE ORIGINAL DRAWING.	DATE	MARCH 2004
	H & S JOB NUMBER	30788B
	CONTRACT NUMBER	B
	DRAWING NUMBER	M810