


NOTES:

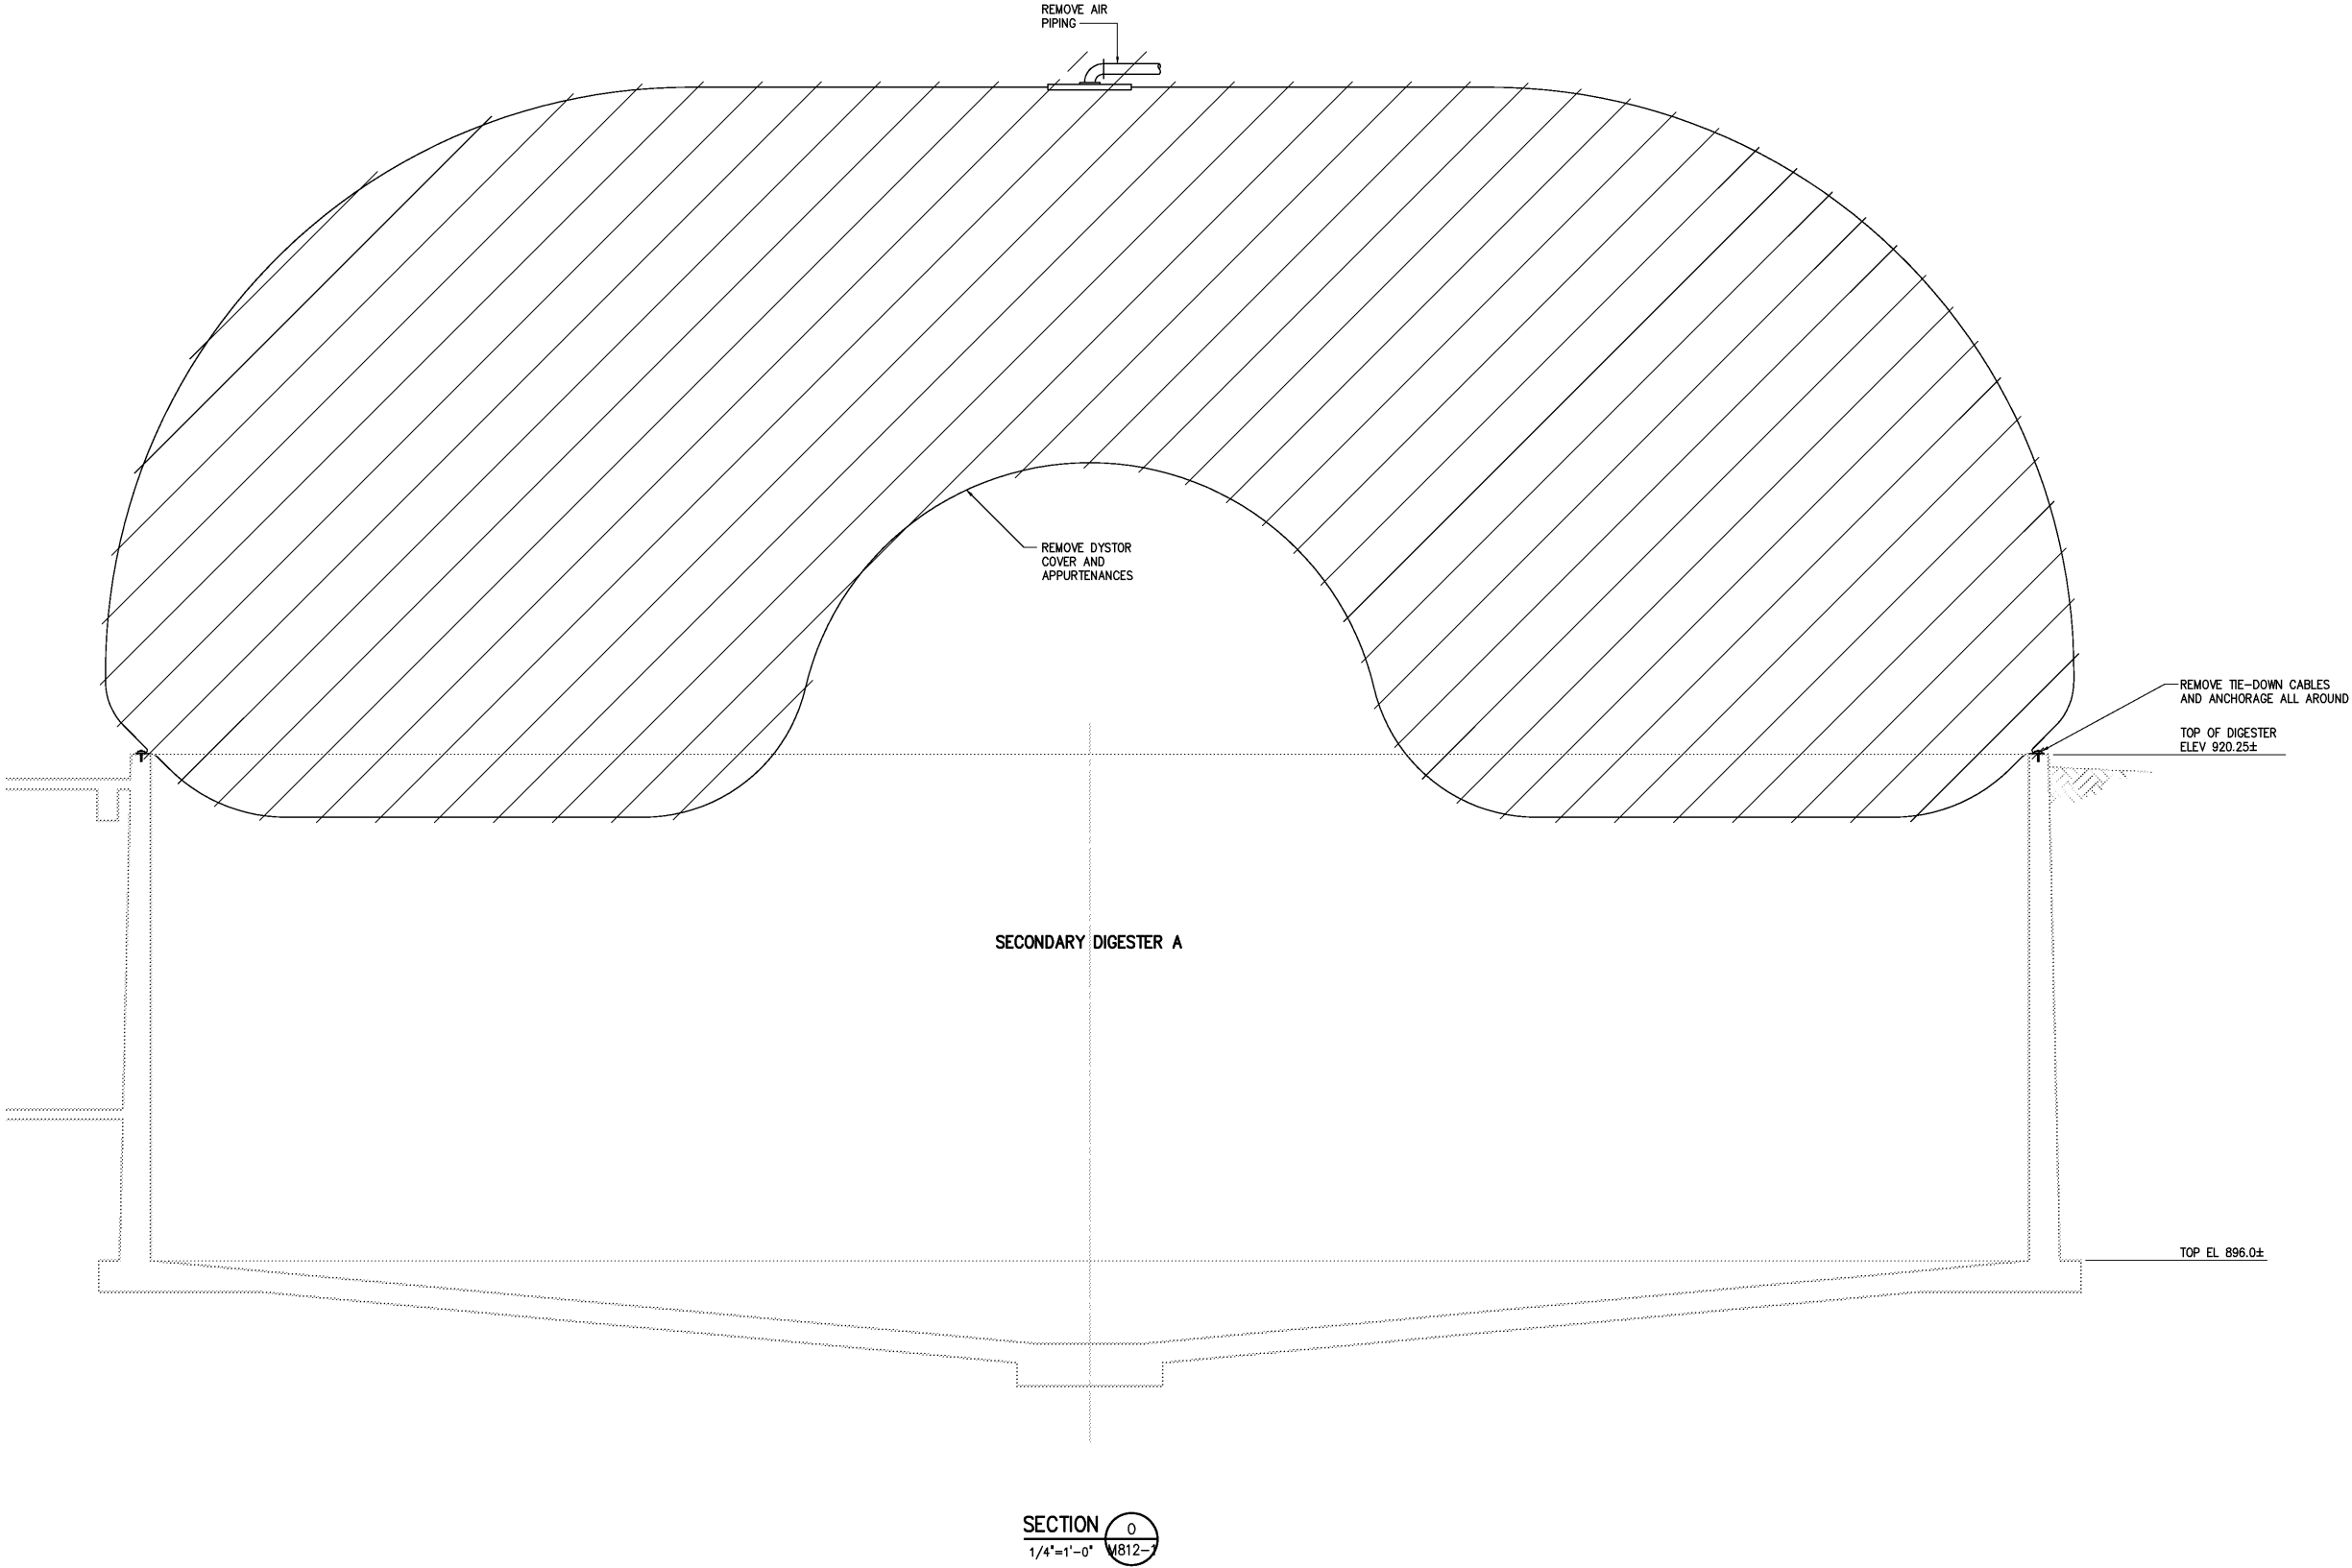

				DESIGNED CMB/HGM	RECORD DRAWING	THIS DOCUMENT ORIGINALLY ISSUED FOR CONSTRUCTION AND SEALED BY ROBERT S. DIFIORE, SEAL NO. 22769	THIS DRAWING HAS BEEN MODIFIED TO REFLECT FIELD CHANGES REPORTED BY THE CONTRACTOR OR ANOTHER PARTY, BUT NOT VERIFIED BY THE CERTIFYING ENGINEER. THIS DOCUMENT ORIGINALLY ISSUED AND SEALED BY CHARLES M. BULLARD, SEAL NUMBER 036668. THIS MEDIA SHALL NOT BE CONSIDERED A CERTIFIED DOCUMENT.	HAZEN AND SAWYER Environmental Engineers & Scientists 4011 WestChase Blvd, Raleigh, North Carolina 27607	CITY OF ROANOKE VIRGINIA	DIGESTER MODIFICATIONS MECHANICAL SECTION SECONDARY DIGESTER A	THE SCALE BAR SHOWN BELOW MEASURES ONE INCH LONG ON THE ORIGINAL DRAWING.	DATE MARCH 2004			
				DRAWN HGM								H & S JOB NUMBER 30788B			
				CHECKED								CONTRACT NUMBER B	DRAWING NUMBER M812-2		
3	AS BUILT	OCT 2007	RLT	PROJ. ENGR. DAN	APPROVED	THIS DOCUMENT ORIGINALLY ISSUED FOR CONSTRUCTION AND SEALED BY RONALD L. TAYLOR, SEAL NO. 024649									
2	CONSTRUCTION	MAR 2004	RLT												
1	REGULATORY APPROVAL	NOV 2003	RLT												
NO.	ISSUED FOR	DATE	BY												