




WAS METER VAULT B/C
BOTTOM PLAN
1/4"=1'-0"

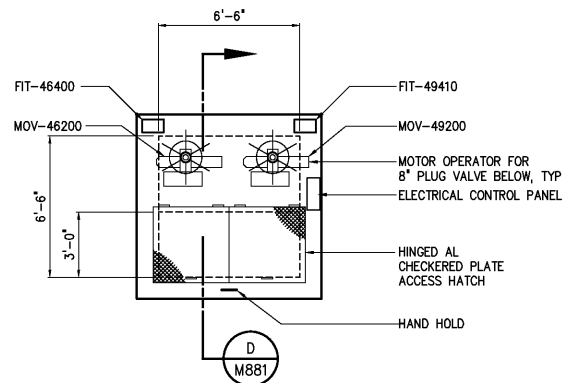


WAS METER VAULT B/C
TOP PLAN
1/4"=1'-0"

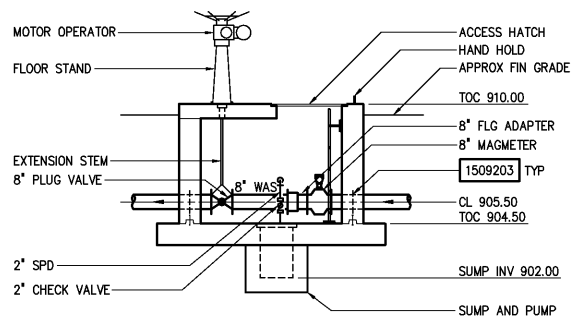


SECTION D
1/4"=1'-0" M881

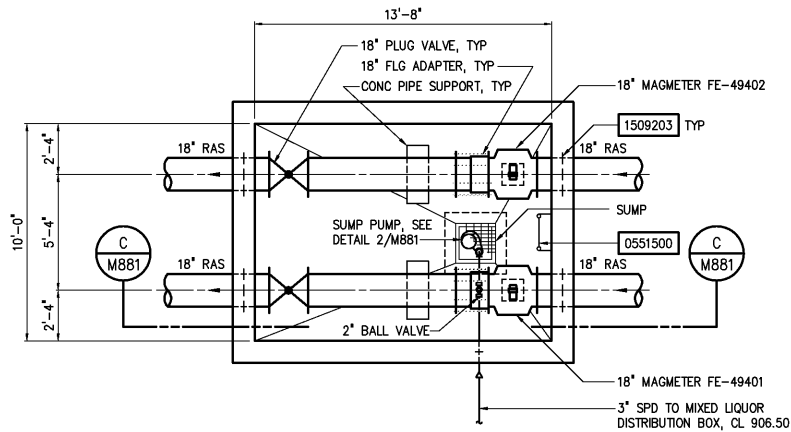

RAS METER VAULT B
BOTTOM PLAN
1/4"=1'-0"

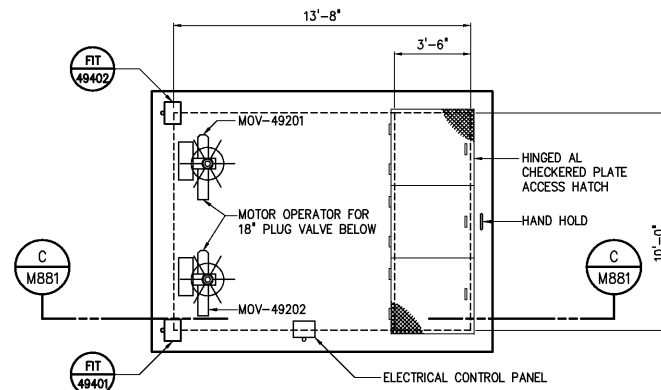


RAS METER VAULT B
TOP PLAN
1/4"=1'-0"

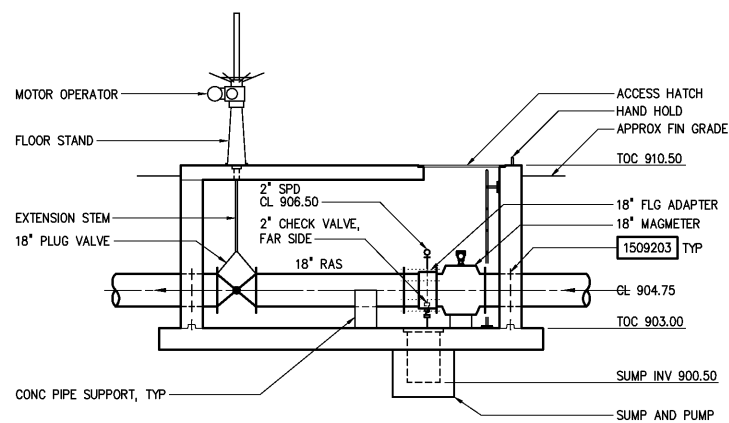

SECTION C
1/4"=1'-0" M881

PUMP CONTROL LEVELS


HIGH LEVEL ALARM AFTER ADJUSTABLE (0-120 SEC) TIME DELAY	902.25
PUMP ON	901.50
PUMP OFF	900.75
BOTTOM OF SUMP	900.50

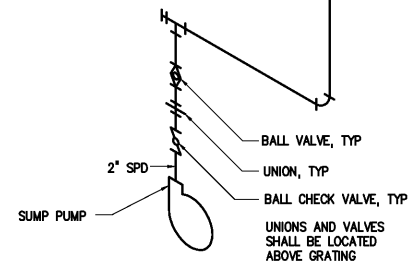

RAS METER VAULT "B" SUMP PUMP
DETAIL 2
NOT TO SCALE M881

PUMP CONTROL LEVELS

HIGH LEVEL ALARM AFTER ADJUSTABLE (0-120 SEC) TIME DELAY	903.75
PUMP ON	903.00
PUMP OFF	902.25
BOTTOM OF SUMP	902.00

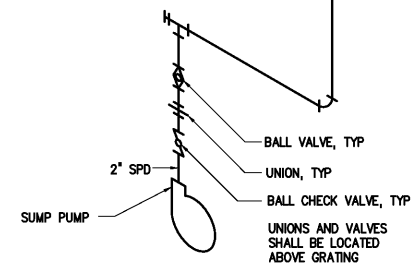

WAS METER VAULT "B/C" SUMP PUMP
DETAIL 1
NOT TO SCALE M881

				DESIGNED	CMB	THIS DOCUMENT ORIGINALLY ISSUED FOR CONSTRUCTION AND SEALED BY ROBERT S. DIFIORE, SEAL NO. 22769	RECORD DRAWING	THIS DRAWING HAS BEEN MODIFIED TO REFLECT FIELD CHANGES REPORTED BY THE CONTRACTOR OR ANOTHER PARTY, BUT NOT VERIFIED BY THE CERTIFYING ENGINEER. THIS DOCUMENT ORIGINALLY ISSUED AND SEALED BY DAVID A. NAILOR, 025465. THIS MEDIA SHALL NOT BE CONSIDERED A CERTIFIED DOCUMENT.	<div><div>HAZEN AND SAWYER</div><div>Environmental Engineers & Scientists</div><div>4011 WestChase Blvd, Raleigh, North Carolina 27607</div></div>	CITY OF ROANOKE VIRGINIA	MISCELLANEOUS YARD STRUCTURES	MECHANICAL	PLANS, SECTIONS AND DETAILS	THE SCALE BAR SHOWN BELOW MEASURES ONE INCH LONG ON THE ORIGINAL DRAWING.	DATE	MARCH 2004				
				DRAWN	BRC										H & S JOB NUMBER	30788B				
				CHECKED															CONTRACT NUMBER	
3	AS BUILT	OCT 2007	RLT	PROJ. ENGR.	DAN														B	DRAWING NUMBER
2	CONSTRUCTION	MAR 2004	RLT			THIS DOCUMENT ORIGINALLY ISSUED FOR CONSTRUCTION AND SEALED BY RONALD L. TAYLOR, SEAL NO. 024649				REGIONAL WATER POLLUTION CONTROL PLANT PROCESS TRAIN IMPROVEMENTS						M881				
1	REGULATORY APPROVAL	NOV 2003	RLT																	
NO.	ISSUED FOR		DATE	BY	APPROVED															