




PARTIAL INTERMEDIATE DEMOLITION PLAN
1/4"=1'-0"

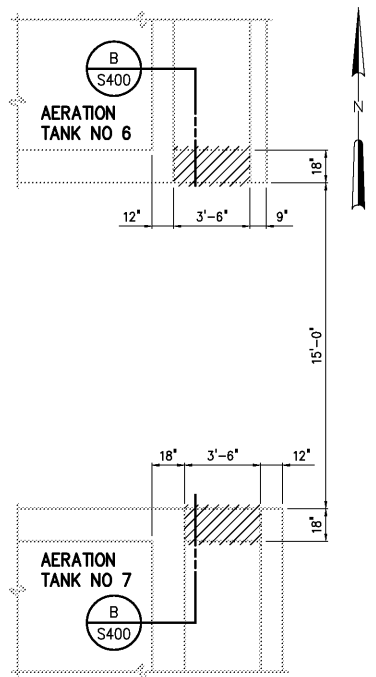


PARTIAL INTERMEDIATE DEMOLITION PLAN
1/4"=1'-0"

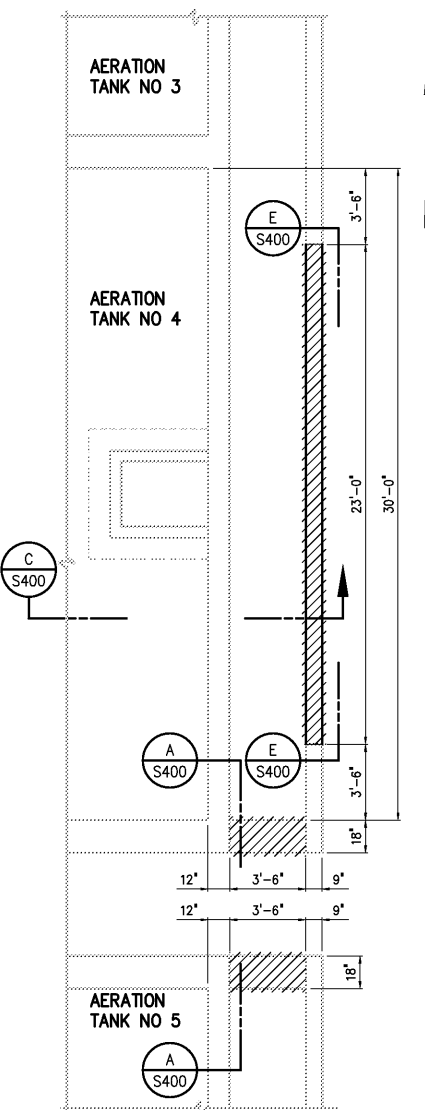


PARTIAL INTERMEDIATE DEMOLITION PLAN
1/4"=1'-0"

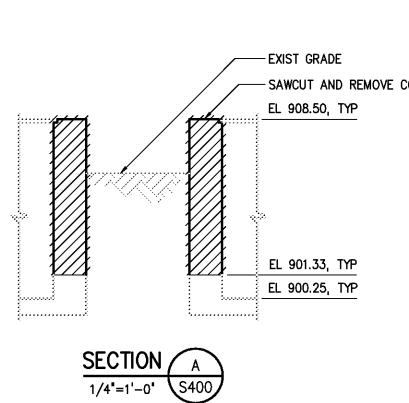


SECTION A
1/4"=1'-0" S400

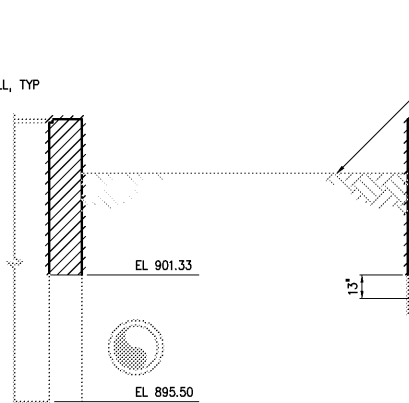


SECTION B
1/4"=1'-0" S400

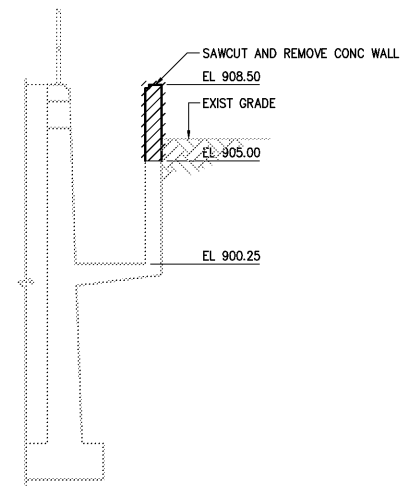

SECTION C
1/4"=1'-0" S400

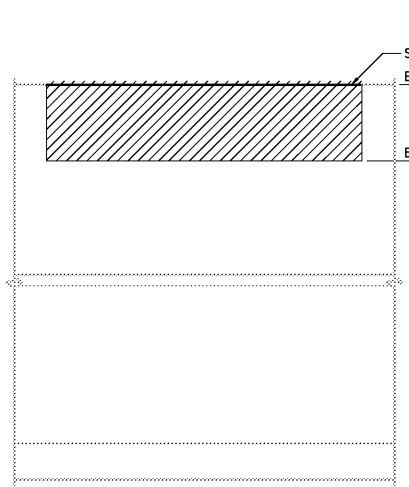

SECTION D
1/4"=1'-0" S400

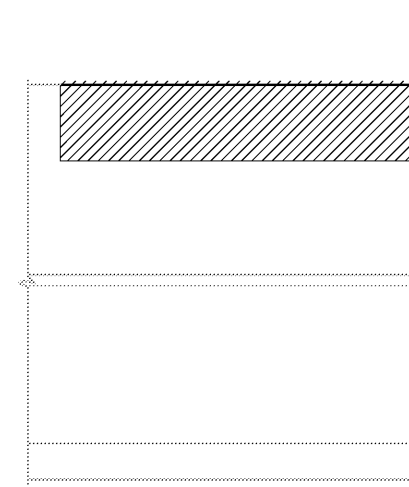

SECTION E
1/4"=1'-0" S400

NOTES:

- 1 ALL DIMENSIONS AND ELEVATIONS SHALL BE FIELD VERIFIED PRIOR TO CONSTRUCTION.
- 2 ALL CONCRETE DEMOLITION SHOWN SHALL BE SELECTIVE DEMOLITION BY SAWCUTTING AND CAREFUL REMOVAL OF CONCRETE SHOWN TO BE REMOVED. NO OVER CUTTING OF AREAS TO BE DEMOLISHED SHALL BE PERMITTED. EXPLOSIVES AND VIBRATORY HAMMERS SHALL NOT BE USED FOR DEMOLITION WORK.
- 3 WHERE ANCHORING DEVICES AND/OR REINFORCEMENT STEEL REMAIN FOLLOWING DEMOLITION, REMOVE AND/OR BURN BACK REINFORCING STEEL 1 1/2" MINIMUM BELOW SURFACE AND VOIDS CREATED SHALL BE FILLED WITH EPOXY RESIN BINDER.
- 4 CONCRETE SURFACES LEFT EXPOSED FOLLOWING DEMOLITION SHALL BE SEALED WITH EPOXY RESIN COATING SUCH AS SIKAGUARD 62 BY SIKACORPORATION, DURACOTE 240 BY TAMMS INDUSTRIES, OR APPROVED EQUAL.

3	AS BUILT	OCT 2007	RLT
2	CONSTRUCTION	MAR 2004	RLT
1	REGULATORY APPROVAL	NOV 2003	RLT
NO.	ISSUED FOR	DATE	BY

DESIGNED	WGL
DRAWN	SMH
CHECKED	
PROJ. ENGR.	DAN
APPROVED	

RECORD DRAWING

THIS DOCUMENT ORIGINALLY ISSUED FOR CONSTRUCTION AND SEALED BY ROBERT S. DIFIORE, SEAL NO. 22769

THIS DRAWING HAS BEEN MODIFIED TO REFLECT FIELD CHANGES REPORTED BY THE CONTRACTOR OR ANOTHER PARTY, BUT NOT VERIFIED BY THE CERTIFYING ENGINEER. THIS DOCUMENT ORIGINALLY ISSUED AND SEALED BY CHRISTOPHER T. PHILLIPS, 033796. THIS MEDIA SHALL NOT BE CONSIDERED A CERTIFIED DOCUMENT.

THIS DOCUMENT ORIGINALLY ISSUED FOR CONSTRUCTION AND SEALED BY RONALD L. TAYLOR, SEAL NO. 024649

HAZEN AND SAWYER
Environmental Engineers & Scientists
4011 WestChase Blvd, Raleigh, North Carolina 27607

CITY OF ROANOKE
VIRGINIA

REGIONAL WATER POLLUTION CONTROL PLANT
PROCESS TRAIN IMPROVEMENTS

AERATION TANK MODIFICATIONS
STRUCTURAL
PLANS AND SECTIONS - DEMOLITION

THE SCALE BAR SHOWN BELOW MEASURES ONE INCH LONG ON THE ORIGINAL DRAWING.	DATE	MARCH 2004
	H & S JOB NUMBER	30788B
	CONTRACT NUMBER	B
	DRAWING NUMBER	S400