




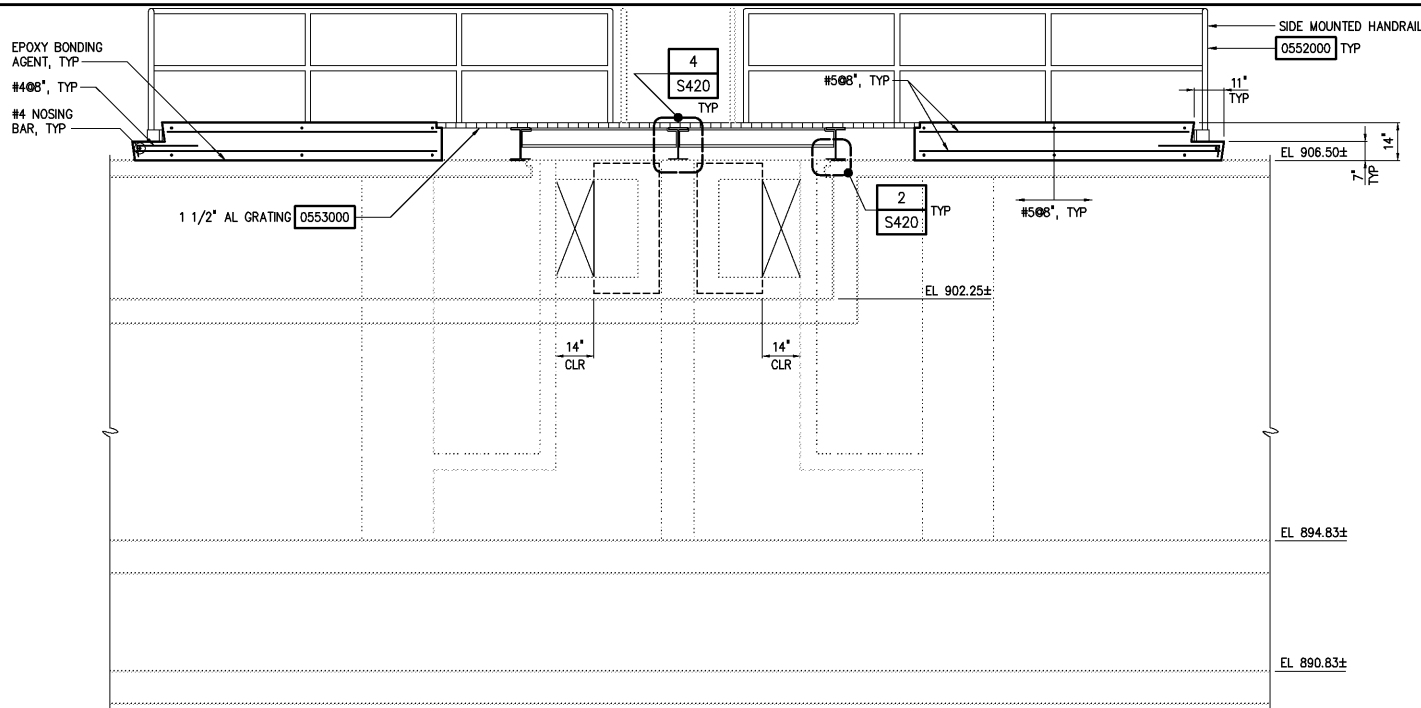

SECTION E
3/8"=1'-0" S421

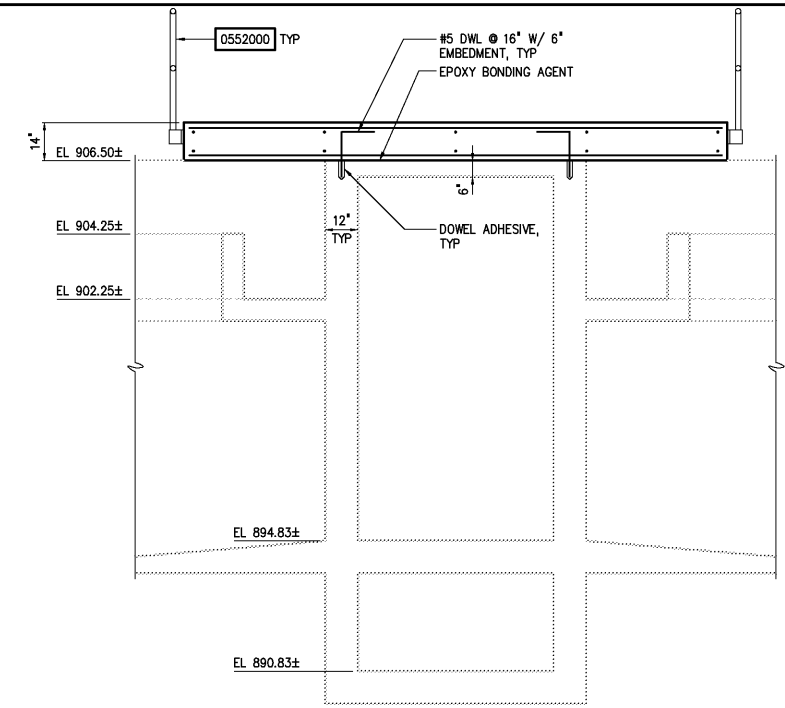


SECTION G
3/8"=1'-0" S421

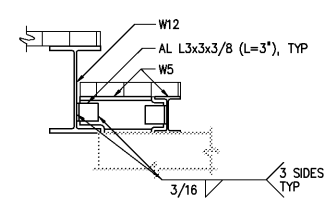


DETAIL 5
1/2"=1'-0" S421

- NOTES:
- 1 W12 INDICATES AL W12x14.29.
 - 2 W7 INDICATES AL W7x5.8.
 - 3 W5 INDICATES AL W5x3.7.
 - 4 ALL DIMENSIONS AND ELEVATIONS SHALL BE FIELD VERIFIED PRIOR TO CONSTRUCTION.

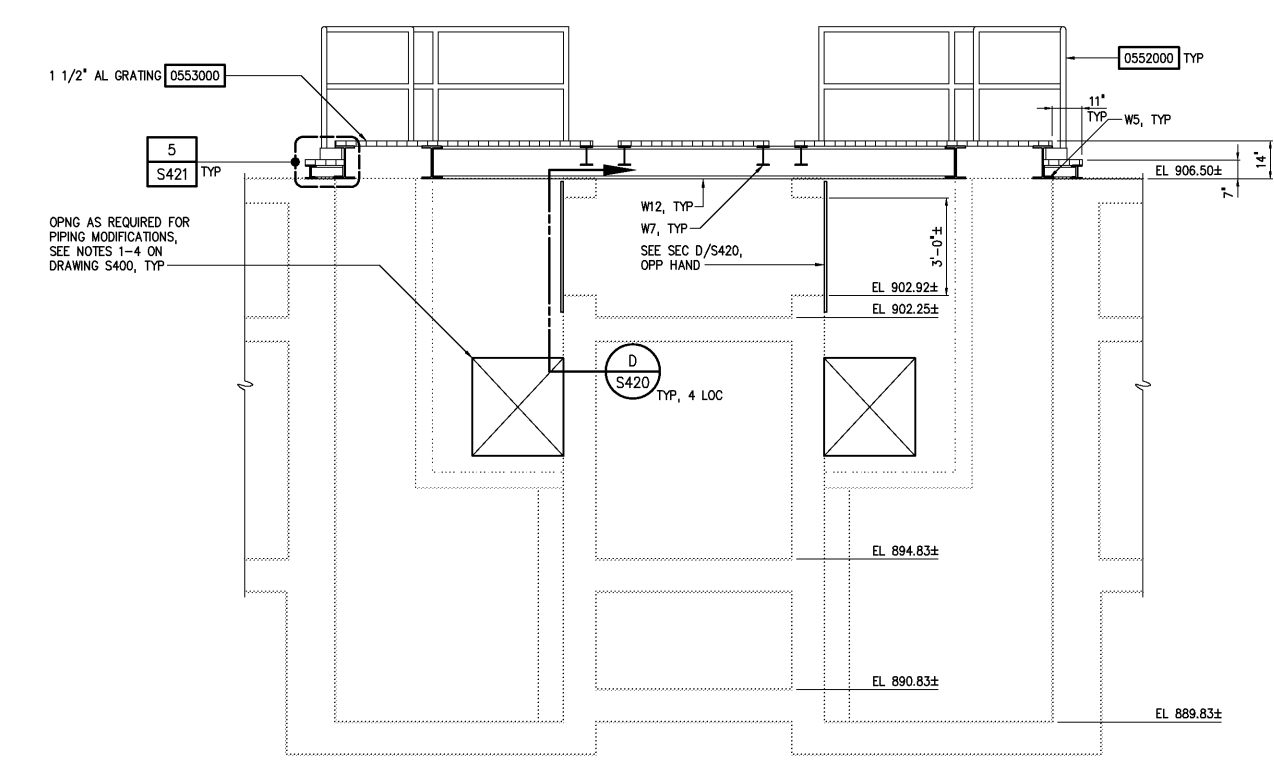

SECTION F
3/8"=1'-0" S421

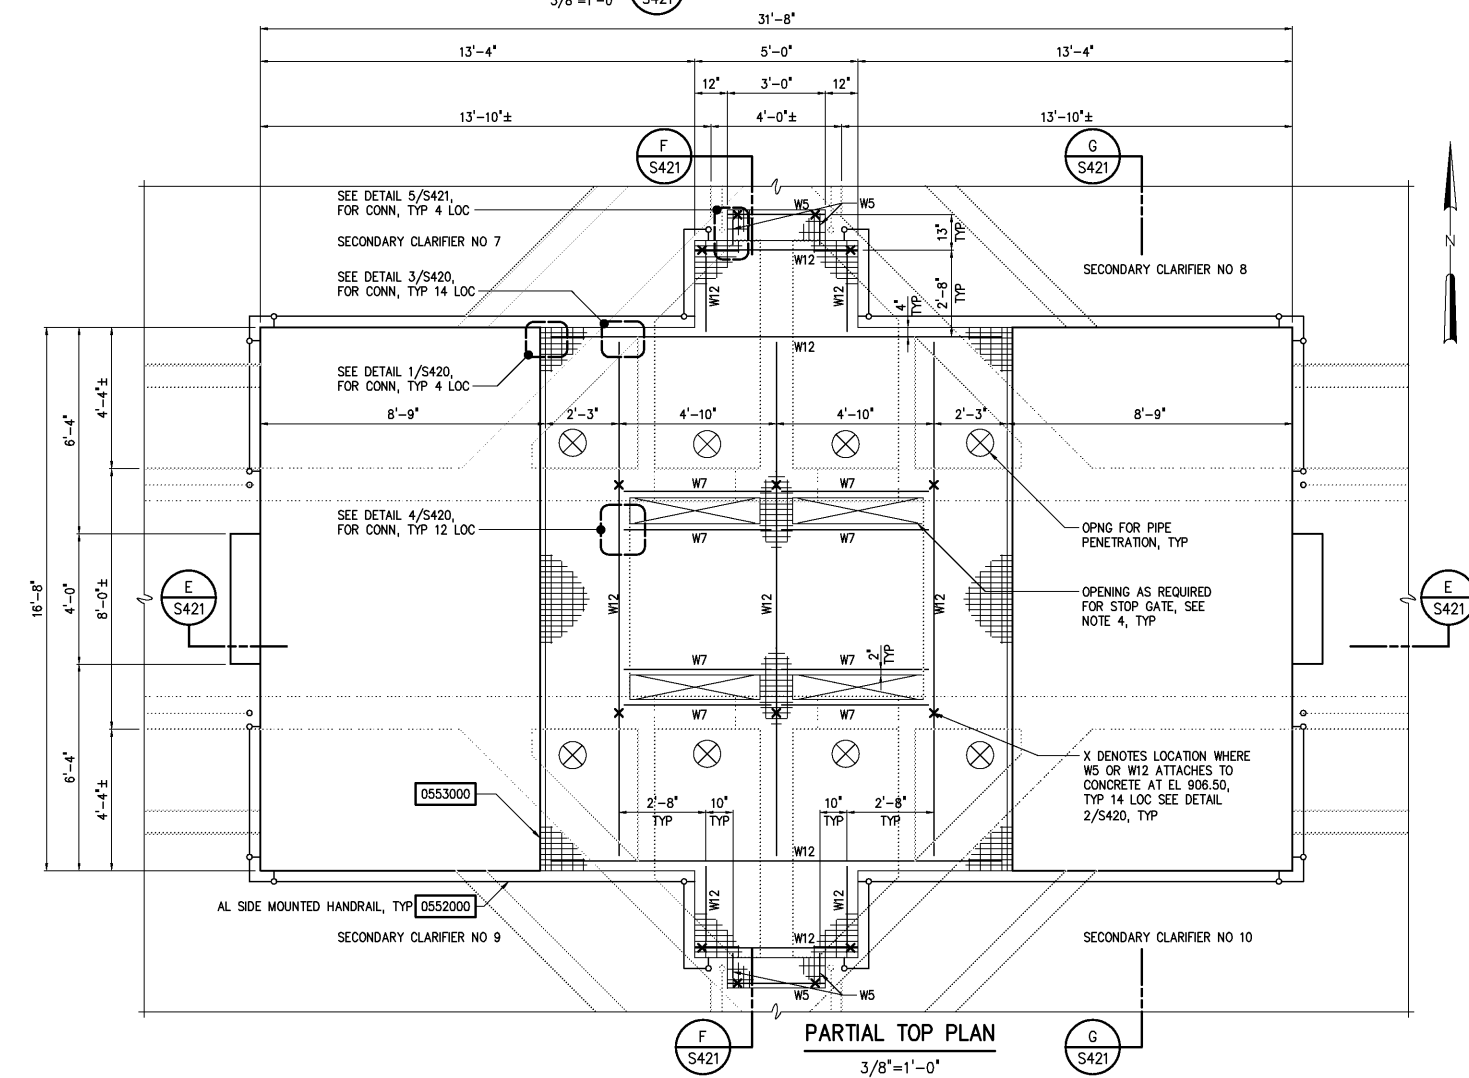

PARTIAL TOP PLAN
3/8"=1'-0" S421

3	AS BUILT	OCT 2007	RLT
2	CONSTRUCTION	MAR 2004	RLT
1	REGULATORY APPROVAL	NOV 2003	RLT
NO.	ISSUED FOR	DATE	BY
			APPROVED

DESIGNED	WGL
DRAWN	SMH
CHECKED	
PROJ. ENGR.	DAN
APPROVED	

THIS DOCUMENT ORIGINALLY ISSUED FOR CONSTRUCTION AND SEALED BY ROBERT S. DIFIORE, SEAL NO. 22769

THIS DOCUMENT ORIGINALLY ISSUED FOR CONSTRUCTION AND SEALED BY RONALD L. TAYLOR, SEAL NO. 024649

RECORD DRAWING

THIS DRAWING HAS BEEN MODIFIED TO REFLECT FIELD CHANGES REPORTED BY THE CONTRACTOR OR ANOTHER PARTY, BUT NOT VERIFIED BY THE CERTIFYING ENGINEER. THIS DOCUMENT ORIGINALLY ISSUED AND SEALED BY CHRISTOPHER T. PHILLIPS, 033796. THIS MEDIA SHALL NOT BE CONSIDERED A CERTIFIED DOCUMENT.

HAZEN AND SAWYER
Environmental Engineers & Scientists
4011 WestChase Blvd, Raleigh, North Carolina 27607

CITY OF ROANOKE
VIRGINIA

REGIONAL WATER POLLUTION CONTROL PLANT
PROCESS TRAIN IMPROVEMENTS

SECONDARY CLARIFIERS AND RAS PUMPING FACILITIES
STRUCTURAL
PARTIAL PLANS, SECTIONS AND DETAILS
SECONDARY CLARIFIER NOS 7-10

THE SCALE BAR SHOWN BELOW MEASURES ONE INCH LONG ON THE ORIGINAL DRAWING.

DATE MARCH 2004
H & S JOB NUMBER 30788B
CONTRACT NUMBER B
DRAWING NUMBER S421