




NOTES:  
1 SEE SPECIFICATION SECTION 16482 FOR  
PRE-ENGINEERED METAL BUILDING REQUIREMENTS.

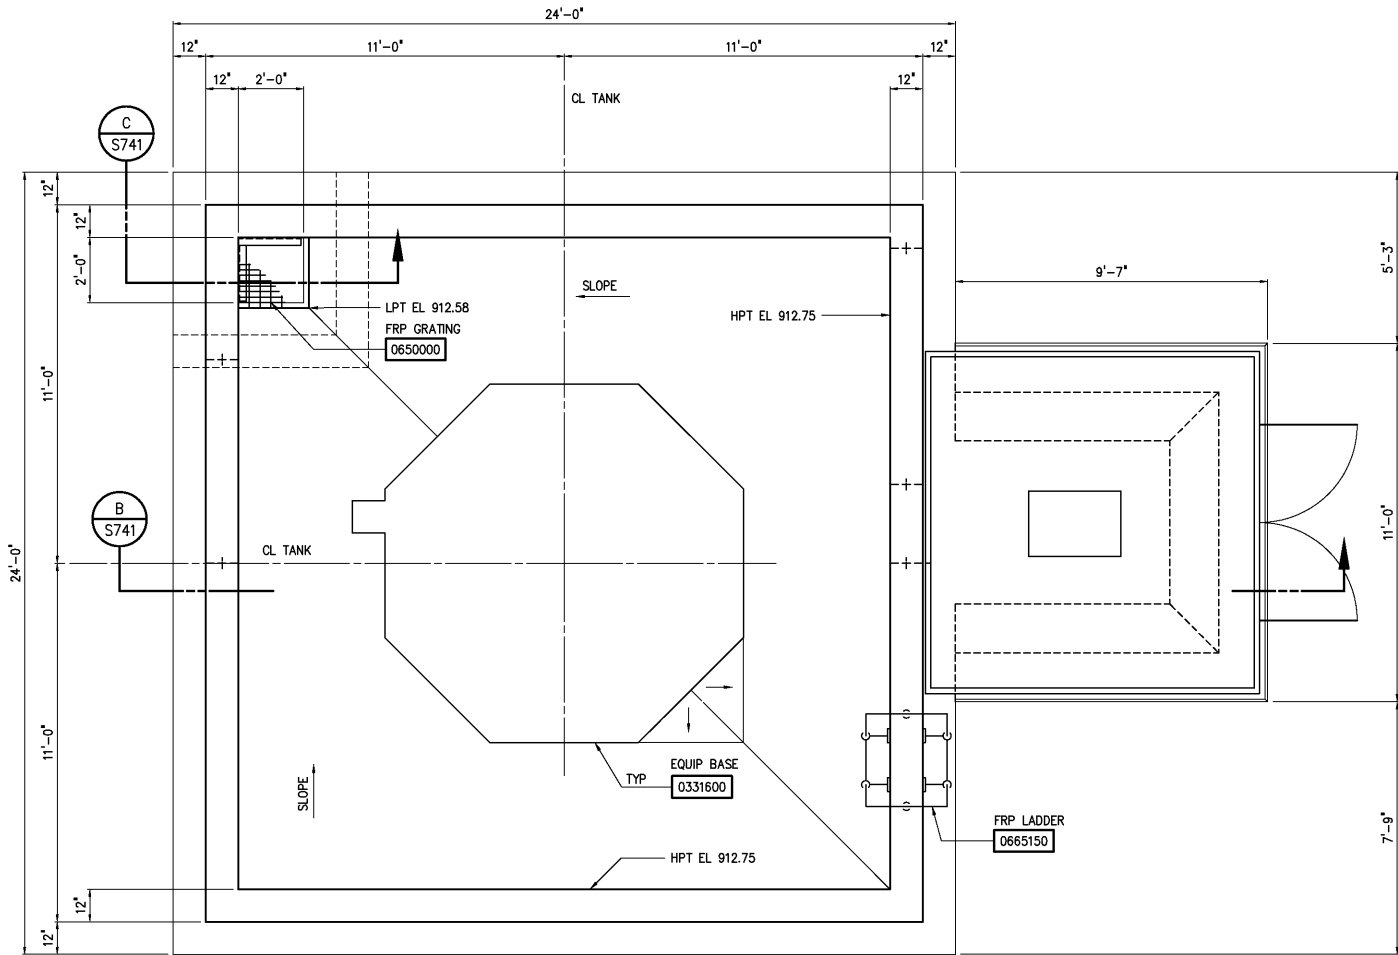


POLYMER BULK STORAGE  
TANK CONTAINMENT  
TOP PLAN  
3/8"=1'-0"

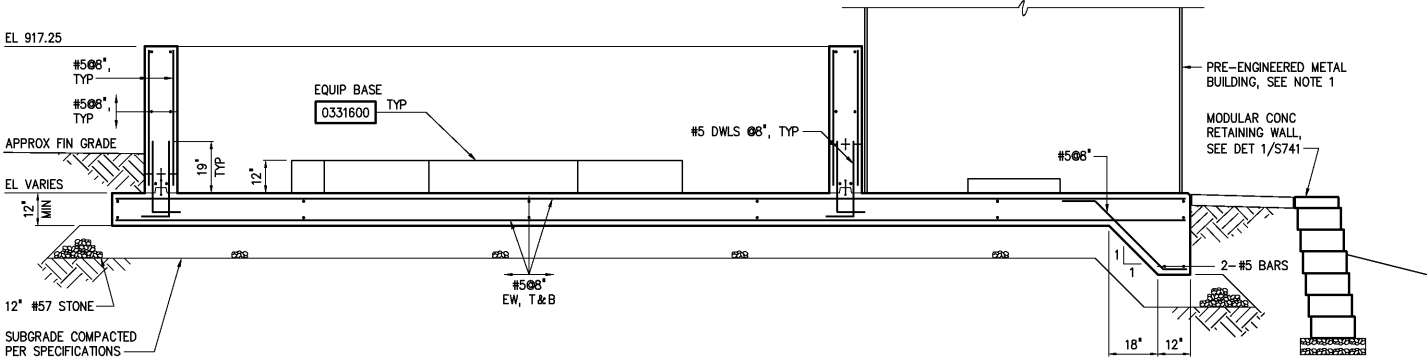

SECTION B  
3/8"=1'-0" S741

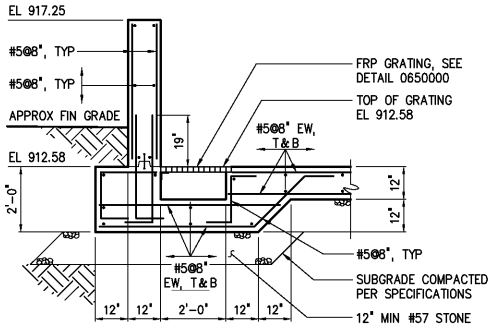

SECTION C  
3/8"=1'-0" S741

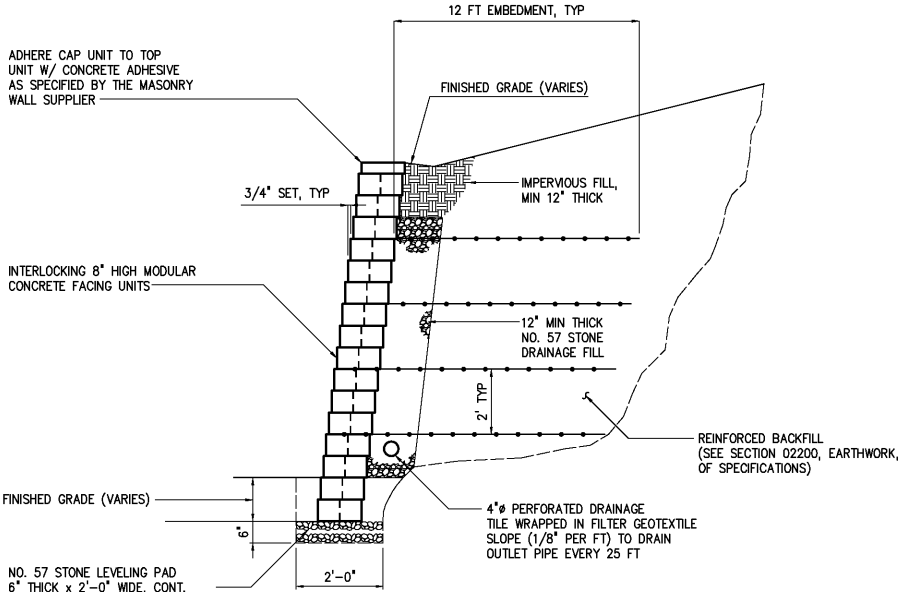

DETAIL 1  
NTS S741

DESIGNED WGL/DDZ				RECORD DRAWING				CITY OF ROANOKE VIRGINIA				DAF THICKENER BUILDING MODIFICATIONS				THE SCALE BAR SHOWN BELOW MEASURES ONE INCH LONG ON THE ORIGINAL DRAWING.				DATE MARCH 2004			
DRAWN DDZ				THIS DRAWING HAS BEEN MODIFIED TO REFLECT FIELD CHANGES REPORTED BY THE CONTRACTOR OR ANOTHER PARTY, BUT NOT VERIFIED BY THE CERTIFYING ENGINEER.				REGIONAL WATER POLLUTION CONTROL PLANT PROCESS TRAIN IMPROVEMENTS				STRUCTURAL				H & S JOB NUMBER 30788B				CONTRACT NUMBER B			
CHECKED				THIS DOCUMENT ORIGINALLY ISSUED FOR CONSTRUCTION AND SEALED BY ROBERT S. DIFIORE, SEAL NO. 22769				DAF POLYMER CONTAINMENT AREA, PLANS AND SECTIONS				DRAWING NUMBER S741											
PROJ. ENGR. DAN				THIS DOCUMENT ORIGINALLY ISSUED FOR CONSTRUCTION AND SEALED BY RONALD L. TAYLOR, SEAL NO. 024649																			
NO. 1				NO. 2																			
AS BUILT				CONSTRUCTION																			
OCT 2007				MAR 2004																			
RLT				RLT																			
NOV 2003				DATE																			
BY				APPROVED																			