
14'-6" 14'-6" S800 S800 FIELD VERIFY EX PIPE OVERFLOW BOX SEE DETAIL 1/S800 EXISTING TOP PLAN 1/8"=1'-0"

NOTES:

- 1 PRIOR TO REMOVAL OF TOP SLAB THE CONTRACTOR SHALL EXCAVATE AROUND THE PERINETER OF THE DIGESTER TANK TO A MINIMUM ELEVATION OF 914.00. EQUIPMENT USED FOR EXCAVATION SHALL NOT EXCEP ITOOLO LBS AUE WEIGHT AND SHALL NOT BE PERMITTED WITHIN 6 FT OF TANK WALL WITHOUT APPROVAL CONTRACTOR SHALL SUBMIT EXCAVATION DETAILS FOR APPROVAL.
- 2 METHOD OF TOP SLAR REMOVAL SHALL BE THE CHOICE OF THE CONTRACTOR. REMOVAL OF TOP SLAB SHALL BE PERFORMED SUCH THAT NO DAMAGE OCCURS TO COLUMNS, COLUMN CAPITALS OR DROP PANELS. TOP SLAB SHALL BE REMOVED AT THE INTERFACE OF THE SLAB AND TANK WALL SO THAT TOP OF EXISTING DIGESTRE TANK WALL REMANS AT ELEVATION 918.00. AFTER REMOVAL OF TOP SLAB ALL EXPOSED REINFORCING OR OTHER PROTRUDING EMBEDWENTS SHALL BE BURNED BACK A MINIMUM OF 1/27 AND ALL VOIDS SHALL BE FUELD WITH AN 1/2* AND ALL VOIDS SHALL BE FILLED WITH AN EPOXY RESIN BINDER MEETING THE REQUIREMENTS OF SPECIFICATION 03250.
- SPECIFICATION 03250.

 3 PRIOR TO REMOVAL OF THE TOP SLAB THE CONTRACTOR SHALL REMOVE THE PORTION OF THE PORTION OF THE PORTION OF THE PORTION TANK OVERFLOW BOX WHICH REST ON THE DIGESTER TOP SLAB. REMOVAL SHALL BE MADE BY WALL AND A HORIZONAL CUT THROUGH THE BOX WALL AND A HORIZONAL CUT THROUGH THE BOX OF THE PIPE GALLET. OVERCUTING SUCH THAT THE TOP SLAB OF THE PIPE GALLET. OVERCUTING SUCH THAT THE TOP SLAB OF THE PIPE GALLET. SETTING SUCH THAT THE TOP SLAB OF THE PIPE GALLET. SETTING SUCH THAT THE TOP SLAB OF THE PIPE GALLET. SETTING SHALL BE BURNED BACK AND PATCHED AS RECUEDED BY NOTE 2. ABOVE. ALL OVERFLOW PIPING LOCATED IN BOX SHALL BE PLUGGED PIPING TO ANY DEMOLITION AND SHALL BEPLIANCED PIPING TO
- NEW BUX IS COMPLETE.

 4. CONTRACTOR SHALL BE RESPONSIBLE FOR THE STRUCTURAL INTEGRITY OF THE EXISTING TOP SLAB BURNG DEMOLITION. PORTIONS OF TOP SLAB BEING REMOVED SHALL BE SUPPORTED AT ALL TIMES DURING REMOVAL AND SHALL NOT BE ALLOWED TO FALL INTO DIRESTER TANK. CONTRACTOR SHALL PROVIDE. ADEQUATE SUPPORT FOR EXISTING TOP SLAB DURING DEMOLITION SO THAT ANY PORTIONS OF THE SLAB NOT YET REMOVED CAN NOT COLLAPSE INTO THE DIGESTER TANK.

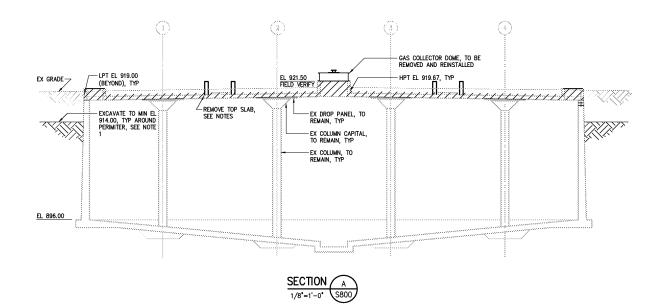

- APPROX LOCATION FOR VERTICAL CUT OF OVERFLOW BOX WALL, SEE NOTE 3, TYP

REMOVE WALL ABOVE DIGESTER SLAB, SEE NOTE 3

EX STEEL COVER, TO BE REMOVED AND REINSTALLED PRIMARY TANK OVERFLOW BOX

				DESIGNED AGM DRAWN AGM
				CHECKED
3	AS BUILT	OCT 2007	RLT	PROJ. ENGR. RLT
2	CONSTRUCTION	MAR 2004	RLT	
1	REGULATORY APPROVAL	NOV 2003	RLT	
NO.	ISSUED FOR	DATE	BY	APPROVED

THIS DOCUMENT ORIGINALLY ISSUED FOR CONSTRUCTION AND SEALED BY ROBERT S. DIFIORE, SEAL NO. 22769

THIS DOCUMENT ORIGINALLY ISSUED FOR CONSTRUCTION AND SEALED BY RONALD L. TAYLOR, SEAL NO. 024649

THIS DRAWING HAS BEEN MODIFIED TO REFLECT FIELD CHANGES REPORTED BY THE CONTRACTOR OR ANOTHER PARTY, BUT NOT VERIFIED BY THE CERTIFYING ENGINEER. THIS DOCUMENT ORIGINALLY ISSUED AND SEALED BY CHRISTOPHER T. PHILLIPS, 033796. THIS MEDIA SHALL NOT BE CONSIDERED A CERTIFIED DOCUMENT.

RECORD DRAWING

HAZEN AND SAWYER Environmental Engineers & Scientists 4011 WestChase Blvd, Raleigh, North Carolina 27607 CITY OF ROANOKE VIRGINIA

DIGESTER TANK

PIPE GALLERY

DETAIL 1 3/8"=1'-0" S800

REGIONAL WATER POLLUTION CONTROL PLANT PROCESS TRAIN IMPROVEMENTS

EXISTING DIGESTER NO. 1 DEMOLITION STRUCTURAL PLAN AND SECTIONS

THE SCALE BAR DATE MARCH 2004 SHOWN BELOW MEASURES ONE INCH LONG ON THE ORIGINAL

DRAWING.

H & S JOB 30788B CONTRACT NUMBER DRAWING NUMBER S800