

ROOM FINISH SCHEDULE																	
NO.	DESCRIPTION	FLOOR		BASE		WALL-NORTH		WALL-EAST		WALL-SOUTH		WALL-WEST		CEILING			REMARKS
		SUBSTRATE	FINISH	SUBSTRATE	FINISH	SUBSTRATE	FINISH	SUBSTRATE	FINISH	SUBSTRATE	FINISH	SUBSTRATE	FINISH	SUBSTRATE	FINISH	HEIGHT	
DIGESTER BOILER BUILDING – SEE DRAWING A840																	
840	CONTROL ROOM	CONC	SEALER	CMU	PT	CMU	PT	CMU	PT	CMU	PT	CMU	PT	CONC	PT	16'-0"	
841	ELECTRICAL ROOM	CONC	SEALER	CMU	PT	CMU	PT	CMU	PT	CMU	PT	CMU	PT	CONC	PT	16'-0"	
842	BOILER ROOM	CONC	SEALER	CMU	PT	CMU	PT	CMU	PT	CMU	PT	CMU	PT	CONC	PT	16'-8"	

FINISH ABBREVIATIONS:

CONC= CONCRETE

CMU= CONCRETE MASONRY UNITS

PT= PAINT

DOOR SCHEDULE																			
NO.	FRAME		DOOR					DETAILS			GLAZING	LOUVER	FIRE LABEL	BSA LABEL	FINISH	HDWR NO	THRSHLD	REMARKS	
	TYPE	MATL	TYPE	MATL	WIDTH	HEIGHT	THICKNESS	HEAD	JAMB	SILL									
DIGESTER BOILER BUILDING – SEE DRAWING A840																			
840	F-3	HM	D	HM	3'-0"	7'-0"	1 3/4"	1/A2	1/A2	1/A2	TG	--	--	--	PT	3	AL	--	
840A	F-3	HM	C	HM	3'-0"	7'-0"	1 3/4"	3/A2	3/A2	3/A2	TG	--	--	--	PT	4	AL	--	
841	F-3	HM	D	HM	(2) 2'-10"	7'-0"	1 3/4"	1/A2	1/A2	1/A2	TG	--	--	--	PT	2	AL	--	
842	F-3	HM	D	HM	3'-0"	7'-0"	1 3/4"	1/A2	1/A2	1/A2	TG	--	--	--	PT	3	AL	--	
842A	MFR	STEEL	F	AL	10'-0"	12'-0"	3/4"	2/A2	2/A2	2/A2	ACRYLIC	--	--	--	MFR	1	--	ROLL-UP DOOR	
842B	MFR	STEEL	F	AL	10'-0"	12'-0"	3/4"	2/A2	2/A2	2/A2	ACRYLIC	--	--	--	MFR	1	--	ROLL-UP DOOR	
842C	F-3	HM	D	HM	3'-0"	7'-0"	1 3/4"	1/A2	1/A2	1/A2	TG	--	--	--	PT	3	AL	--	

SCHEDULE ABBREVIATIONS:

PT= PAINTED

HM= HOLLOW METAL


AL= ALUMINUM

TG= TEMPERED GLASS


MFR= MANUFACTURER

DOOR TYPES 1/4" = 1'-0"


NOTES: GLASS SHALL BE 1/4" TEMPERED, EXCEPT FIRE RATED DOORS WHICH SHALL BE 1/4" WIRE GLASS

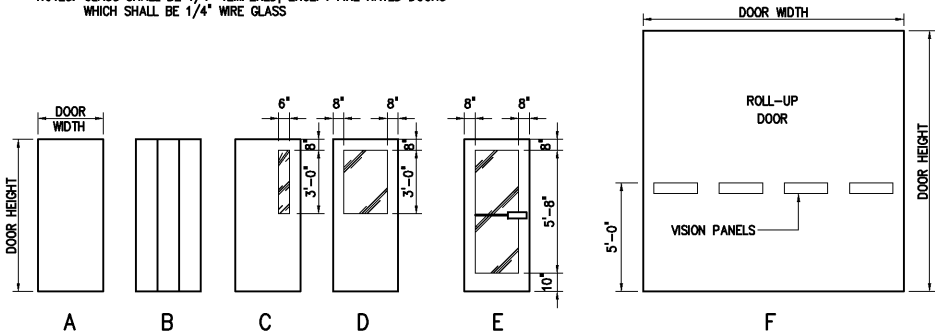


FRAME TYPES 1/4" = 1'-0"

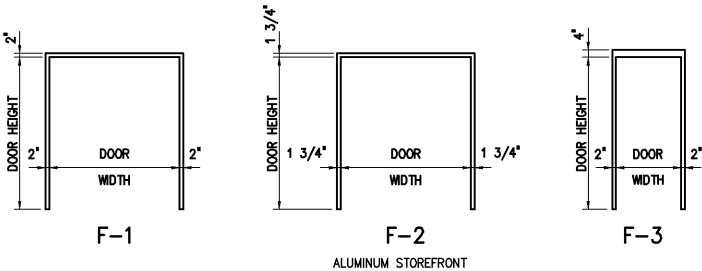

THRESHOLD TYPES 3" = 1'-0"

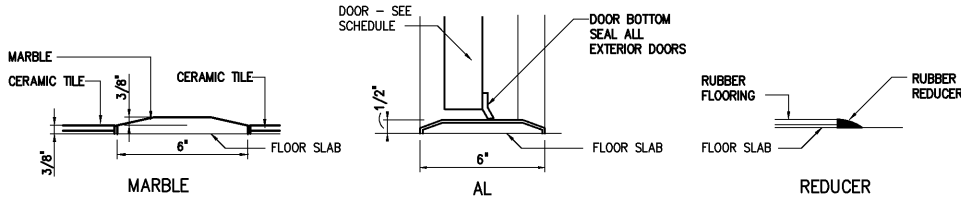

FRAME PROFILES 3" = 1'-0"

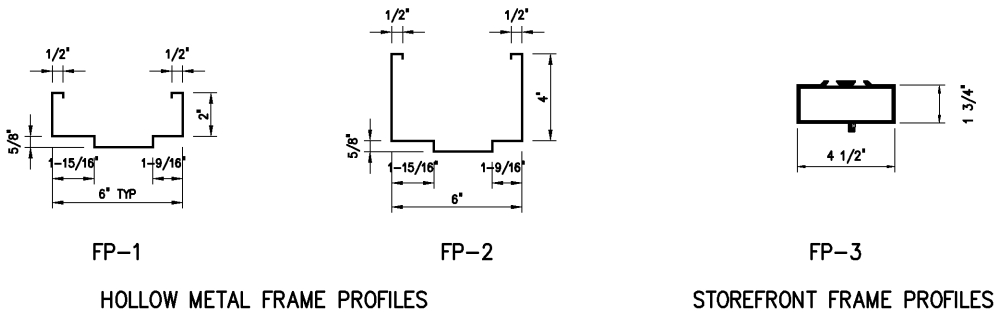

NO.				DESIGNED	WHR	THIS DOCUMENT ORIGINALLY ISSUED FOR CONSTRUCTION AND SEALED BY ROBERT S. DIFIORE, SEAL NO. 22769	RECORD DRAWING	HAZEN AND SAWYER Environmental Engineers & Scientists 4011 WestChase Blvd, Raleigh, North Carolina 27607	CITY OF ROANOKE VIRGINIA	REGIONAL WATER POLLUTION CONTROL PLANT PROCESS TRAIN IMPROVEMENTS	ARCHITECTURAL ROOM FINISH AND DOOR SCHEDULES	THE SCALE BAR SHOWN BELOW MEASURES ONE INCH LONG ON THE ORIGINAL DRAWING.	DATE MARCH 2004	
				DRAWN	ALB								H & S JOB NUMBER 30788B	
	3	AS BUILT	OCT 2007	RLT									CONTRACT NUMBER	DRAWING NUMBER
	2	CONSTRUCTION	MAR 2004	RLT									B	A1
	1	REGULATORY APPROVAL	NOV 2003	RLT		THIS DOCUMENT ORIGINALLY ISSUED FOR CONSTRUCTION AND SEALED BY RONALD L. TAYLOR, SEAL NO. 024649	THIS DRAWING HAS BEEN MODIFIED TO REFLECT FIELD CHANGES REPORTED BY THE CONTRACTOR OR ANOTHER PARTY, BUT NOT VERIFIED BY THE CERTIFYING ENGINEER. THIS DOCUMENT ORIGINALLY ISSUED AND SEALED BY WILLIAM H. RUSSELL, SEAL NUMBER 008532. THIS MEDIA SHALL NOT BE CONSIDERED A CERTIFIED DOCUMENT.							
		ISSUED FOR	DATE	BY	APPROVED									