



- NOTES:
1. MASONRY REINF #5 @ 48" OC, AT ALL CORNERS, AND ADJACENT TO ALL OPENINGS, ALL WALLS.
 2. INTERIOR MASONRY WALLS TO BE FULL HEIGHT. FILL UNGROUTED CELLS WITH CORE-FILL 500 OR EQUAL.
 3. DIMENSIONS GIVEN ARE TO NOMINAL FACE OF MASONRY
 4. PROVIDE CEMENT GROUT AS REQUIRED TO OBTAIN 1/4" PER FOOT SLOPE. PRECAST CONCRETE ROOF PANELS WILL HAVE A CAMBER.
 5. PROVIDE BACKER ROD AND SEALANT BOTH SIDES OF WALL, FULL HEIGHT OF WALL (TYPICAL)

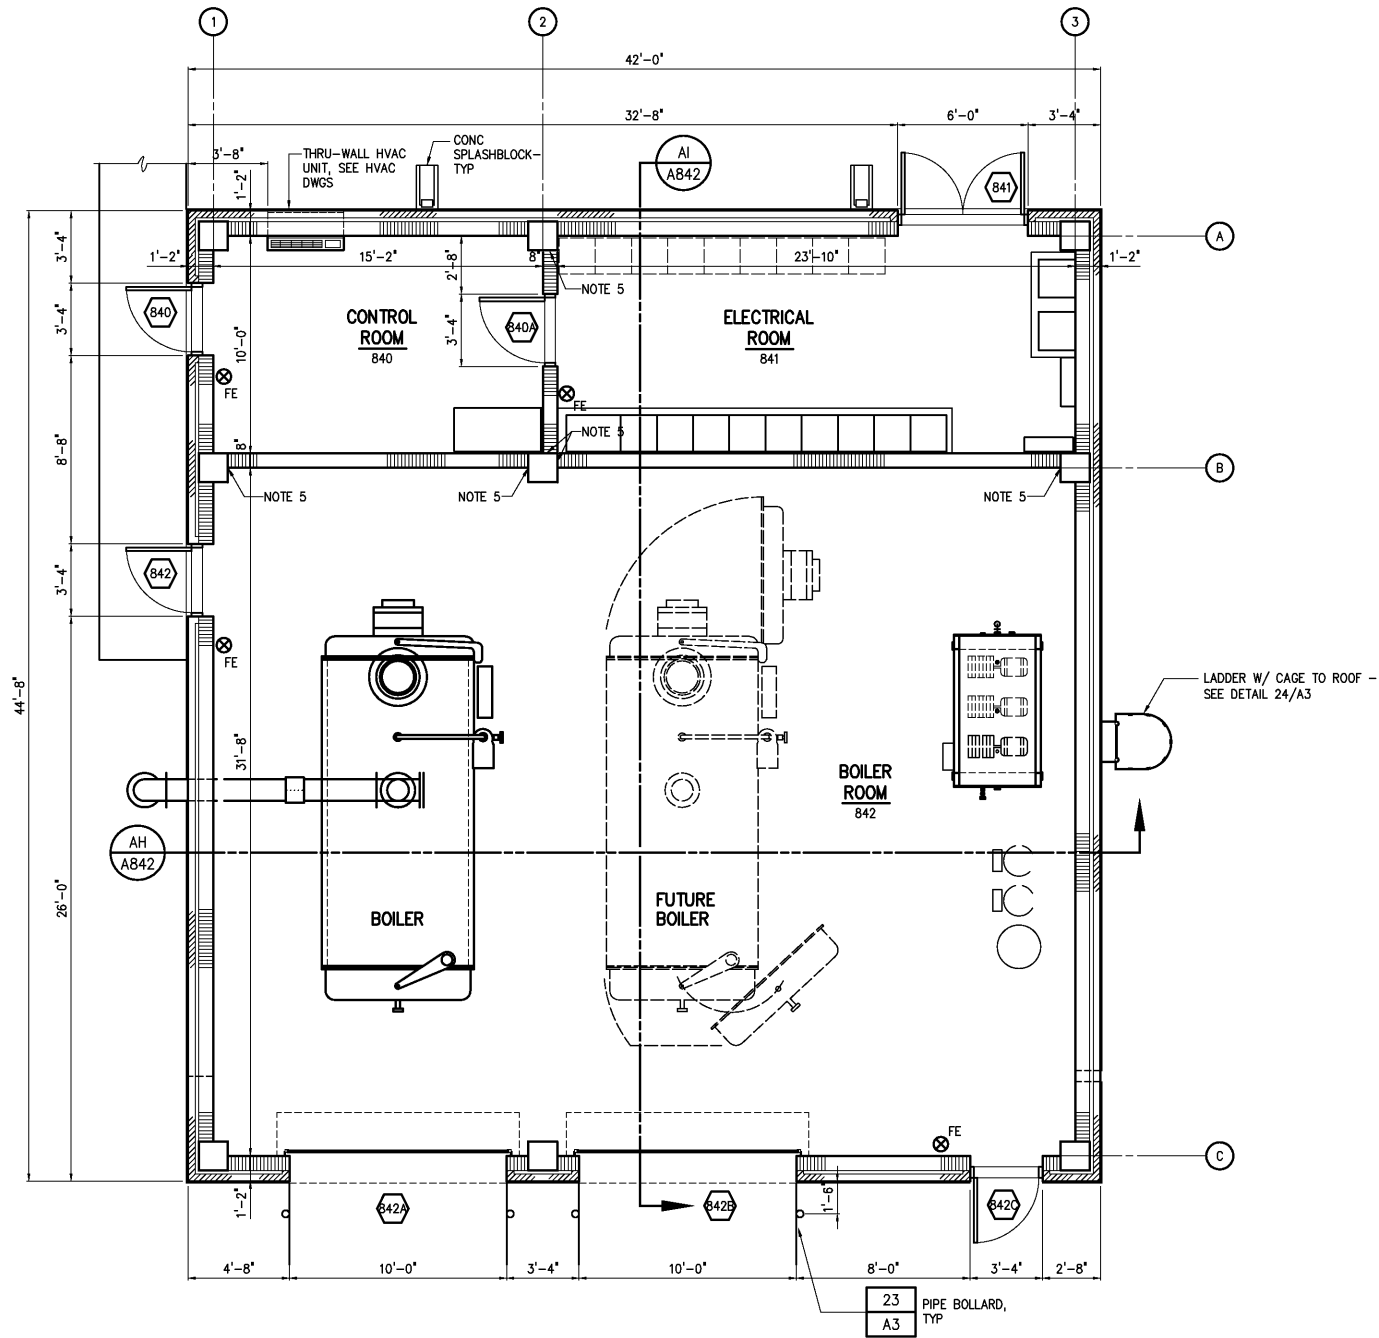

TOP PLAN

1/4"=1'-0"

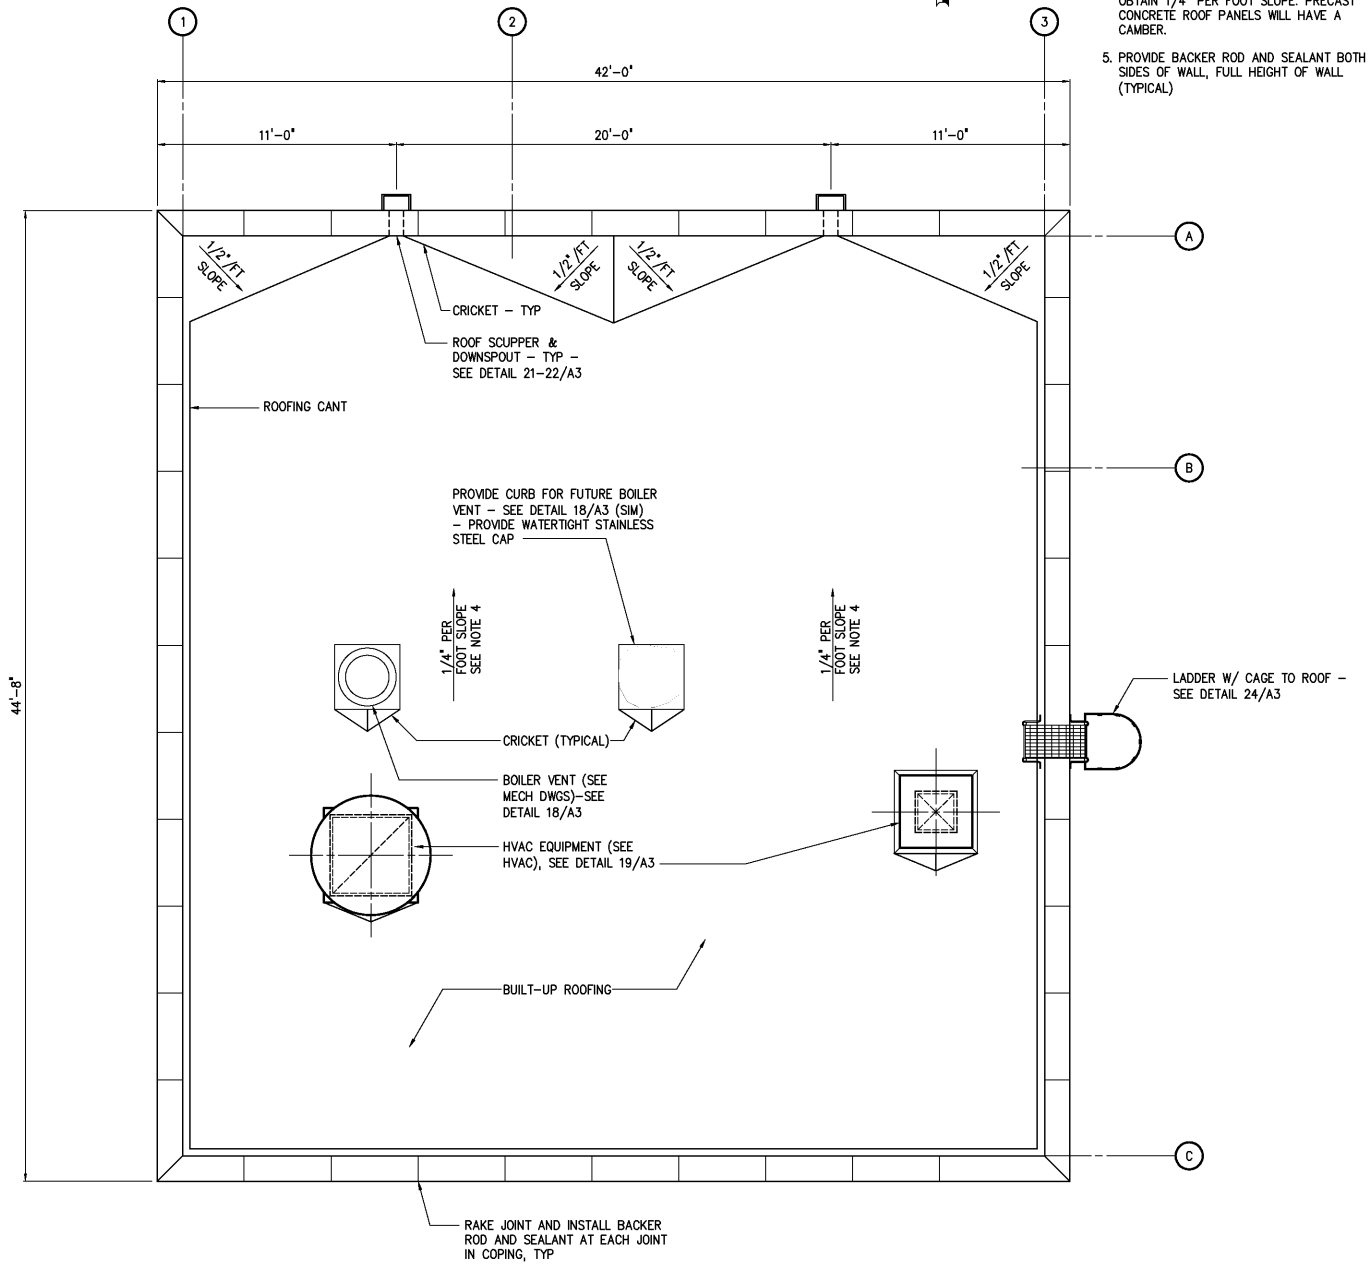

ROOF PLAN

1/4"=1'-0"

LEGEND:

- 120 DOOR NUMBER - SEE DRAWING NO. A1
- FE- FIRE EXTINGUISHER

NO.	AS BUILT	OCT 2007	RLT	DESIGNED	WHR
2	CONSTRUCTION	MAR 2004	RLT	DRAWN	ALB
1	REGULATORY APPROVAL	NOV 2003	RLT	CHECKED	
	ISSUED FOR	DATE	BY	PROJ. ENGR.	H & S
				APPROVED	

THIS DOCUMENT ORIGINALLY ISSUED FOR CONSTRUCTION AND SEALED BY ROBERT S. DIFIORE, SEAL NO. 22769

RECORD DRAWING

THIS DRAWING HAS BEEN MODIFIED TO REFLECT FIELD CHANGES REPORTED BY THE CONTRACTOR OR ANOTHER PARTY, BUT NOT VERIFIED BY THE CERTIFYING ENGINEER. THIS DOCUMENT ORIGINALLY ISSUED AND SEALED BY WILLIAM H. RUSSELL, SEAL NUMBER 008532. THIS MEDIA SHALL NOT BE CONSIDERED A CERTIFIED DOCUMENT.

THIS DOCUMENT ORIGINALLY ISSUED FOR CONSTRUCTION AND SEALED BY RONALD L. TAYLOR, SEAL NO. 024649

HAZEN AND SAWYER
Environmental Engineers & Scientists
4011 WestChase Blvd, Raleigh, North Carolina 27607

CITY OF ROANOKE
VIRGINIA

REGIONAL WATER POLLUTION CONTROL PLANT
PROCESS TRAIN IMPROVEMENTS

DIGESTER BOILER BUILDING
ARCHITECTURAL
TOP PLAN AND ROOF PLAN

THE SCALE BAR SHOWN BELOW MEASURES ONE INCH LONG ON THE ORIGINAL DRAWING.	DATE	MARCH 2004
	H & S JOB NUMBER	30788B
	CONTRACT NUMBER	B
	DRAWING NUMBER	A840