


- NOTES:
- 1 EXISTING MOV-60240 IS LOCATED INSIDE THE AIR SCOUR ROOM NEAR THE NORTH WALL.
 - 2 FSL-60403 SHALL BE LOCATED ON THE AIR SCOUR BLOWER DISCHARGE HEADER.
 - 3 A NEW 66" PIPE WILL BE INSTALLED UNDER THE EXISTING DUCTBANK IN THIS AREA. THE CONTRACTOR SHALL SUPPORT THE EXISTING DUCTBANK DURING THE INSTALLATION OF THE NEW 66" PIPE BELOW.
 - 4 THE CONTRACTOR SHALL USE THE EXISTING 2-2" SPARE CONDUIT AT THIS LOCATION TO INSTALL WIRE TO PP-17B AND PLC-23.

DUCTBANK CONDUIT AND WIRE	
NO.	DESCRIPTION
62	CABLE BY INSTRUMENTATION SUBCONTRACTOR, 3" C 4-2" SP.C 2-2" C FOR EXISTING FIBER AND INTERCOM
63	12#14, #14G, 2" C 3#12, #12G, 1" C 1-1" SP.C

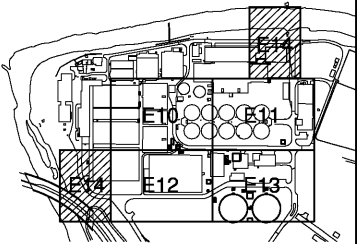

DESIGNED	BRL
DRAWN	BRL
CHECKED	
PROJ. ENGR.	DAN
APPROVED	
NO.	

THIS DOCUMENT ORIGINALLY ISSUED FOR CONSTRUCTION AND SEALED BY ROBERT S. DIFIORE, SEAL NO. 22769
THIS DOCUMENT ORIGINALLY ISSUED FOR CONSTRUCTION AND SEALED BY RONALD L. TAYLOR, SEAL NO. 024649

RECORD DRAWING
THIS DRAWING HAS BEEN MODIFIED TO REFLECT FIELD CHANGES REPORTED BY THE CONTRACTOR OR ANOTHER PARTY, BUT NOT VERIFIED BY THE CERTIFYING ENGINEER. THIS DOCUMENT ORIGINALLY ISSUED AND SEALED BY GERALD J. RATASKY, 026535. THIS MEDIA SHALL NOT BE CONSIDERED A CERTIFIED DOCUMENT.

HAZEN AND SAWYER
Environmental Engineers & Scientists
4011 WestChase Blvd, Raleigh, North Carolina 27607

CITY OF ROANOKE
VIRGINIA
REGIONAL WATER POLLUTION CONTROL PLANT
PROCESS TRAIN IMPROVEMENTS

SITE PLAN
ELECTRICAL
PARTIAL SITE PLAN

THE SCALE BAR SHOWN BELOW MEASURES ONE INCH LONG ON THE ORIGINAL DRAWING.	DATE MARCH 2004
CONTRACT NUMBER B	H & S JOB NUMBER 30788B
DRAWING NUMBER E14	