



- NOTES:
- 1 THE EXISTING CONDUIT IN THESE LOCATIONS SHALL BE RELOCATED AS INDICATED ON DRAWING E421. THE CONTRACTOR SHALL FURNISH AND INSTALL ALL NEW WIRE AND CONDUIT NECESSARY TO RELOCATE THESE EXISTING CONDUITS. THESE CONDUITS CONTAIN POWER AND CONTROL WIRE TO THE CLARIFIER DRIVES. THE CONTRACTOR SHALL COORDINATE CLARIFIER DOWN TIME WITH THE OWNER. THE EXISTING CLARIFIER DRIVES ARE SUPPLIED FROM THE EXISTING CIRCUIT BREAKERS INSIDE THE CLARIFIER EQUIPMENT HOUSE (REFERENCE DRAWING E2 FOR CLARIFIER EQUIPMENT HOUSE LOCATION).
- 2 THE CONTRACTOR SHALL REMOVE THE EXISTING DISCONNECT SWITCH AND 480V RECEPTACLE. REMOVE ALL CONDUCTORS FROM THEIR RESPECTIVE SOURCES. THESE DEVICES ARE SUPPLIED FROM MCC-8 (SEE DRAWING E12) AND ARE NO LONGER IN USE.

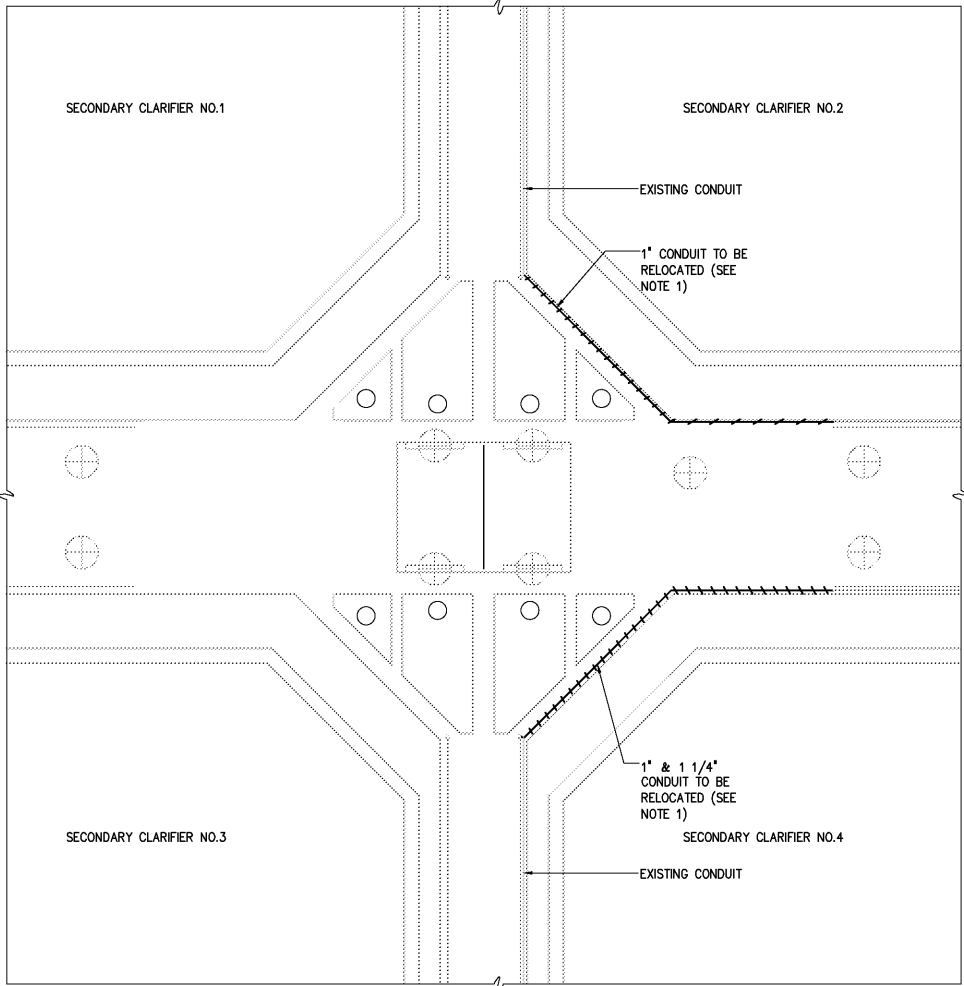

PARTIAL TOP PLAN – DEMOLITION
1/4"=1'-0"

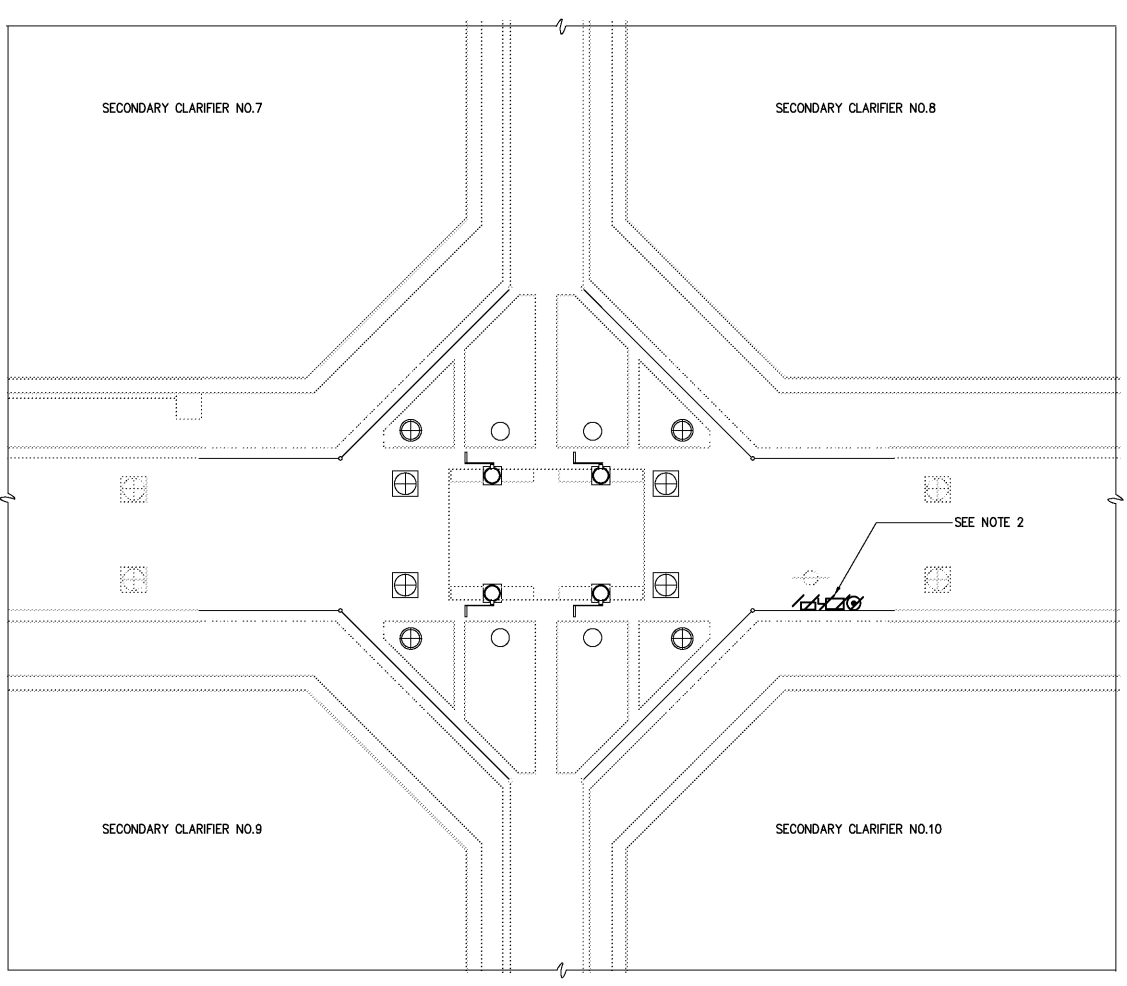

PARTIAL TOP PLAN – DEMOLITION
1/4"=1'-0"

				DESIGNED _____ BRL	RECORD DRAWING	THIS DOCUMENT ORIGINALLY ISSUED FOR CONSTRUCTION AND SEALED BY ROBERT S. DIFIORE, SEAL NO. 22769	THIS DRAWING HAS BEEN MODIFIED TO REFLECT FIELD CHANGES REPORTED BY THE CONTRACTOR OR ANOTHER PARTY, BUT NOT VERIFIED BY THE CERTIFYING ENGINEER. THIS DOCUMENT ORIGINALLY ISSUED AND SEALED BY GERALD J. RATASKY, 026535. THIS MEDIA SHALL NOT BE CONSIDERED A CERTIFIED DOCUMENT.	HAZEN AND SAWYER Environmental Engineers & Scientists 4011 WestChase Blvd, Raleigh, North Carolina 27607	CITY OF ROANOKE VIRGINIA	REGIONAL WATER POLLUTION CONTROL PLANT PROCESS TRAIN IMPROVEMENTS	SECONDARY CLARIFIERS AND RAS PUMPING FACILITIES	ELECTRICAL PARTIAL DEMOLITION PLANS	THE SCALE BAR SHOWN BELOW MEASURES ONE INCH LONG ON THE ORIGINAL DRAWING. <div></div>	DATE	MARCH 2004	
				DRAWN _____ BRL										H & S JOB NUMBER	30788B	
				CHECKED _____										CONTRACT NUMBER	DRAWING NUMBER	
3	AS BUILT	OCT 2007	RLT	PROJ. ENGR. _____ DAN												
2	CONSTRUCTION	MAR 2004	RLT													
1	REGULATORY APPROVAL	NOV 2003	RLT													
NO.	ISSUED FOR	DATE	BY	APPROVED												