
NOTES:

- 1 THE EXISTING FILTER MAIN CONTROL PANEL SHALL REMAIN IN SERVICE UNTIL ALL NEW FILTER CONSOLES AND PLC-FM ARE INSTALLED AND OPERATIONAL. THE CONTROL PANEL SHALL NOT BE REMOVED UNTIL RECEIVING OWNERS PERMISSION. TELEPHONE AND PATCH PANEL TO BE RELOCATED. ABANDONED WIRES SHALL BE REMOVED. REFERENCE SECJICATION SECTION 01520 FOR ADDITIONAL INFORMATION.
- 2 THE CONTRACTOR SHALL REMOVE ALL WIRE AND EXPOSED COMDUIT FROM THE EXISTING FILTER CONSOLES TO THE FILTER SOLENOID VALVE PANEL (SEE DRAWING EEDI). THE CONTRACTOR SHALL DISCONNECT THE EXISTING FILTER CONSOLES FROM THEIR RESPECTIVE POWER SOURCES AND REMOVE ALL WIRE AND EXPOSED CONDUIT.

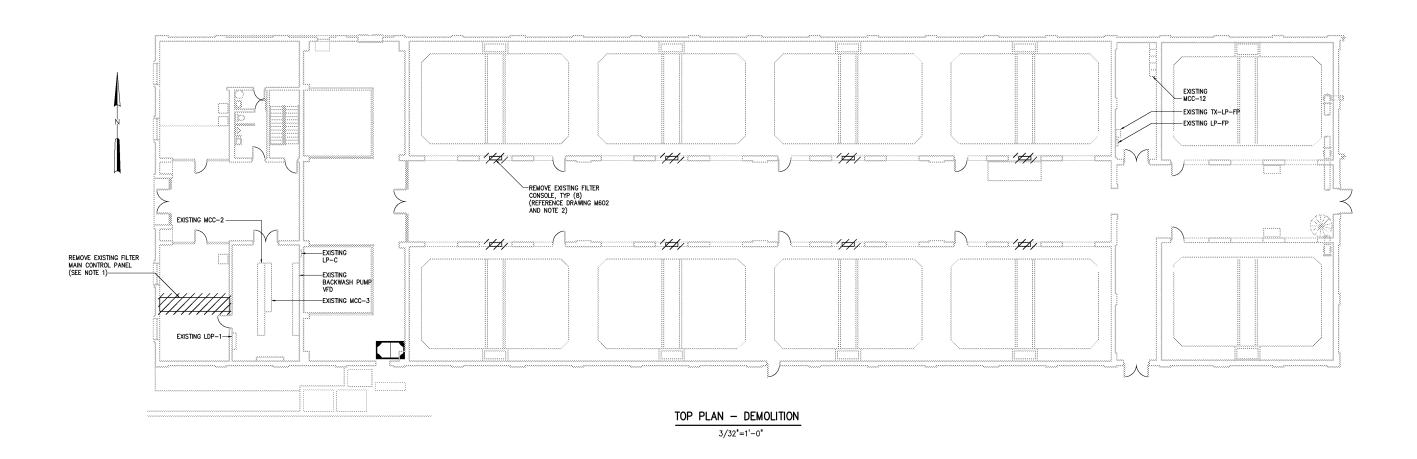

				DESIGNED BRL	
				DRAWNBRL	
				CHECKED	
3	AS BUILT	OCT 2007	RLT	PROJ. ENGR. DAN	
2	CONSTRUCTION	MAR 2004	RLT		l
1	REGULATORY APPROVAL	NOV 2003	RLT		l
NO.	ISSUED FOR	DATE	BY	APPROVED	

THIS DOCUMENT ORIGINALLY ISSUED FOR CONSTRUCTION AND SEALED BY ROBERT S. DIFIORE, SEAL NO. 22769

THIS DOCUMENT ORIGINALLY ISSUED FOR CONSTRUCTION AND SEALED BY RONALD L. TAYLOR, SEAL NO. 024649

RECORD DRAWING

THIS DRAWING HAS BEEN MODIFIED TO REFLECT FIELD CHANGES REPORTED BY THE CONTRACTOR OR ANOTHER PARTY, BUT NOT VERIFIED BY THE CERTIFYING ENGINEER. THIS DOCUMENT ORIGINALLY ISSUED AND SEALED BY GERALD ATASKY, O26535. THIS MEDIA SHALL NOT BE CONSIDERED A CERTIFIED DOCUMENT.

HAZEN AND SAWYER Environmental Engineers & Scientists 4011 WestChase Blvd, Raleigh, North Carolina 27607

CITY OF ROANOKE VIRGINIA

REGIONAL WATER POLLUTION CONTROL PLANT PROCESS TRAIN IMPROVEMENTS

EFFLUENT FILTER MODIFICATIONS ELECTRICAL TOP DEMOLITION PLAN

HE SCALE BAR	DATE
HOWN BELOW EASURES ONE	H & S NUMBER
HE ORIGINAL	CONTR NUMB

MARCH 2004 30788B IRACT J DRAWING NUMBER E600