
 
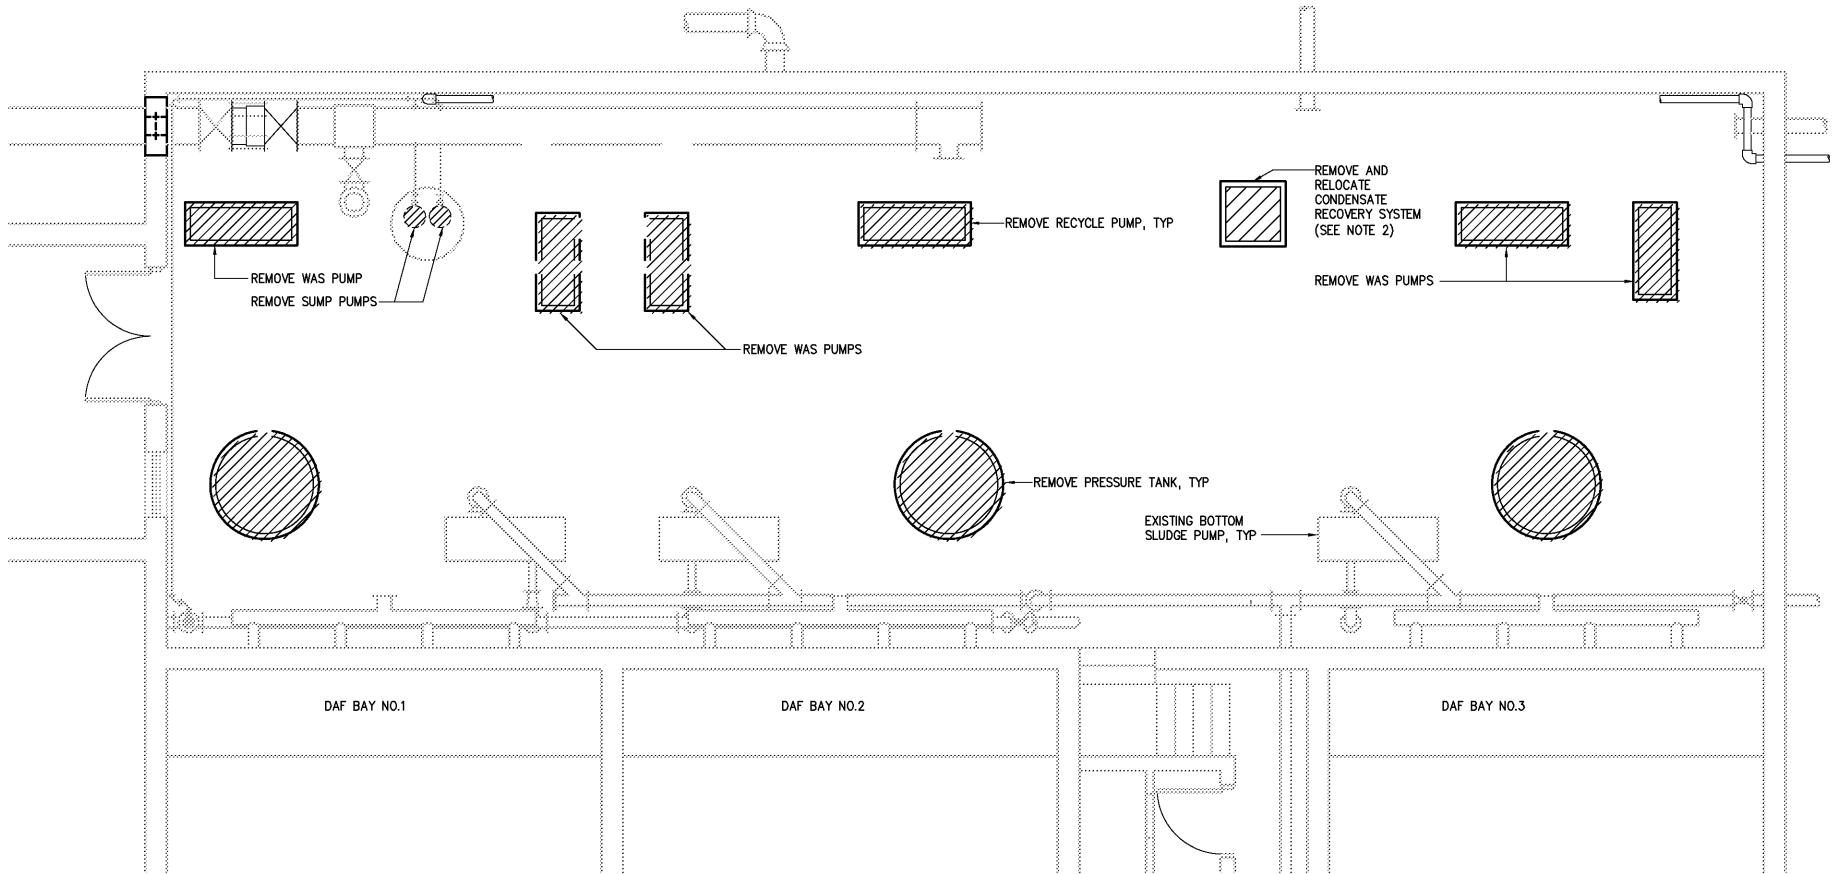


- NOTES:
1. THE CONTRACTOR SHALL RELOCATE THE EXISTING COMBINATION POWER UNIT LP-MP1 TO THE LOCATION INDICATED ON E742. THE CONTRACTOR SHALL PROVIDE TEMPORARY 120VAC POWER TO THE FOLLOWING LOADS CONNECTED TO THE EXISTING LP-MP1 WHILE IT IS RELOCATED:  
-UT-105 AND FILL STATION  
-RECIRCULATION PUMP  
-HYPOCHLORITE PUMP  
-SUMP PUMP CONTROL PANEL
  2. THE CONTRACTOR SHALL FURNISH AND INSTALL ALL WIRE AND CONDUIT NECESSARY TO RELOCATE THE EXISTING CONDENSATE RECOVERY SYSTEM. THE CONTRACTOR SHALL REUSE THE EXISTING POWER CIRCUIT TO SUPPLY THE CONDENSATE RECOVERY SYSTEM AT ITS NEW LOCATION. REFERENCE DRAWING E741.
  3. THE EXISTING WAS CONTROL PANEL SHALL REMAIN IN SERVICE UNTIL THE EXISTING WAS PUMPS ARE REMOVED.
  4. THE CONTRACTOR SHALL REMOVE ALL CONDUIT AND WIRE ASSOCIATED WITH THE EXISTING EQUIPMENT INDICATED TO BE DEMOLISHED ON THIS DRAWING. THE CONTRACTOR SHALL DISCONNECT THE EQUIPMENT INDICATED TO BE DEMOLISHED FROM THEIR RESPECTIVE SOURCES. ALL WIRE & CONDUIT BETWEEN THE POWER SOURCE AND THE EQUIPMENT TO BE DEMOLISHED SHALL BE REMOVED. THE EXISTING RECYCLE & WAS PUMPS ARE SUPPLIED FROM THE EXISTING MCC-1 (SEE DRAWING E742). REFERENCE DRAWING M740 FOR ADDITIONAL DEMOLITION INFORMATION.



**BOTTOM PLAN-DEMOLITION**  
1/4"=1'-0"

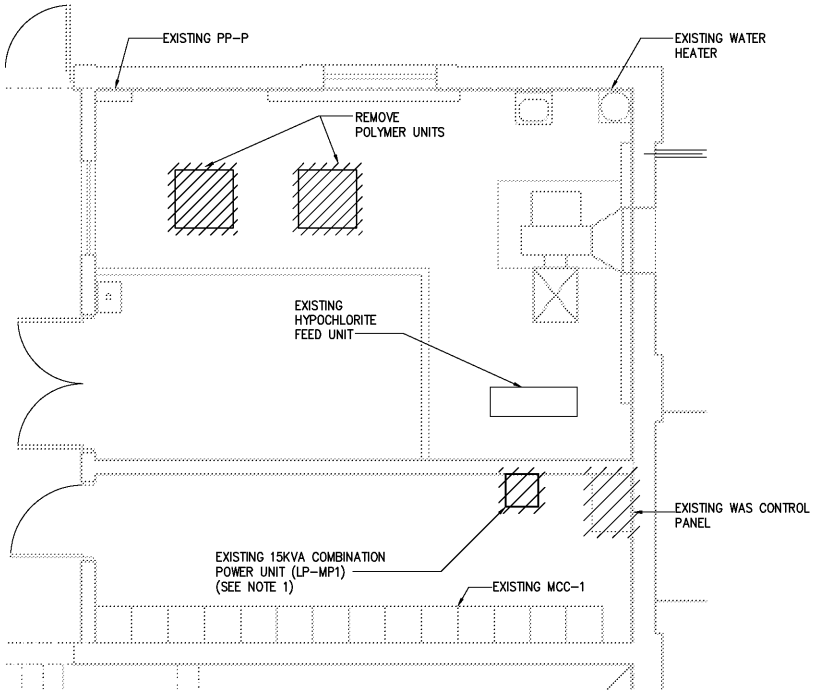

**PARTIAL TOP PLAN-DEMOLITION**  
1/4"=1'-0"

				DESIGNED <b>BRL</b>	<b>RECORD DRAWING</b>  THIS DOCUMENT ORIGINALLY ISSUED FOR CONSTRUCTION AND SEALED BY ROBERT S. DIFIORE, SEAL NO. 22769	<b>HAZEN AND SAWYER</b> Environmental Engineers & Scientists 4011 WestChase Blvd, Raleigh, North Carolina 27607	<b>CITY OF ROANOKE</b> VIRGINIA	<b>DAF THICKENER BUILDING MODIFICATIONS</b>  ELECTRICAL  DEMOLITION PLAN	THE SCALE BAR SHOWN BELOW MEASURES ONE INCH LONG ON THE ORIGINAL DRAWING.	DATE <b>MARCH 2004</b>				
				DRAWN <b>BRL</b>						H & S JOB NUMBER <b>30788B</b>				
				CHECKED						CONTRACT NUMBER <b>B</b>				
3	AS BUILT	OCT 2007	RLT	PROJ. ENGR. <b>H &amp; S</b>	THIS DOCUMENT ORIGINALLY ISSUED FOR CONSTRUCTION AND SEALED BY ROBERT S. DIFIORE, SEAL NO. 22769					THIS DRAWING HAS BEEN MODIFIED TO REFLECT FIELD CHANGES REPORTED BY THE CONTRACTOR OR ANOTHER PARTY, BUT NOT VERIFIED BY THE CERTIFYING ENGINEER. THIS DOCUMENT ORIGINALLY ISSUED AND SEALED BY GERALD J. RATASKY, 026535. THIS MEDIA SHALL NOT BE CONSIDERED A CERTIFIED DOCUMENT.	<b>REGIONAL WATER POLLUTION CONTROL PLANT</b> <b>PROCESS TRAIN IMPROVEMENTS</b>			DRAWING NUMBER <b>E740</b>
2	CONSTRUCTION	MAR 2004	RLT											
1	REGULATORY APPROVAL	NOV 2003	RLT											
NO.	ISSUED FOR	DATE	BY	APPROVED										